IREDELL COUNTY HEALTH DEPARTMENT

Statesville Office (704) 878-5305 Mooresville Office (704) 660-3625 PERMIT # 216 300

IMPROVEMENT PERMIT / AUTHORIZATION TO CONSTRUCT / OPERATION PERMIT / EXISTING SYSTEM

PIN # 4648-35-1664

APPLICANT: Niblock Homes, LLC APPLICANT ADDRESS: 759 Concord Parkway Ste. #20 Concord, NC 28027

SITE ADDRESS: 709 Big Indian Loop Mooresville, NC 28117 PHONE: 704-788-4818 ALT. PHONE: 704-920-7104

SITE DIRECTIONS: Rt 150 West → Right on Bluefield Rd → Left on Big Indian Loop → Right on Big Indian Loop → House on Right (Lake Lot)


SUBDIVISION: CL+T SECTION: 12 LOT # 76 LOT AREA: 0.791 acres DESIGN FLOW: 240 gal/day L.T.A.R.: Existing

Septic Tank	Existing	(gal)	STB	—	Date	—	☐ New System	☐ Repair	☐ Expansion	System Type: I (II) III IV V VI	
Pump Tank	—	(gal)	PT	—	Date	—	System Description:	Existing			
Pump Make	—	Model	—	Serial #	—		Repair System Description:	Existing			
# Nitrification Fields	Exist	# Lines	Exist	Linear Ft:	Exist		Maintenance Agreement Required:	☐ YES	☒ NO		
Trench Width	Existing	Max. Trench Bottom Depth	Exist	Gravel Depth	Exist		☒ GRAVITY	☐ PRESSURE			

☒ Residence No. Bedrooms 2 — Water Supply
☐ Business No. Persons 4 — ☐ Private
☐ Other No. Employees — ☐ Public
☒ Slab ☐ Crawl Space — ☐ Community
☐ Basement w/plumbing ☐ Basement w/o plumbing

Comments / Conditions: This approval is for the proposed 24'x25' detached garage + enclosure of the existing house's porch as a sunroom. Strongly recommend pumping septic tank every 3-5 years

INITIAL SITE SKETCH

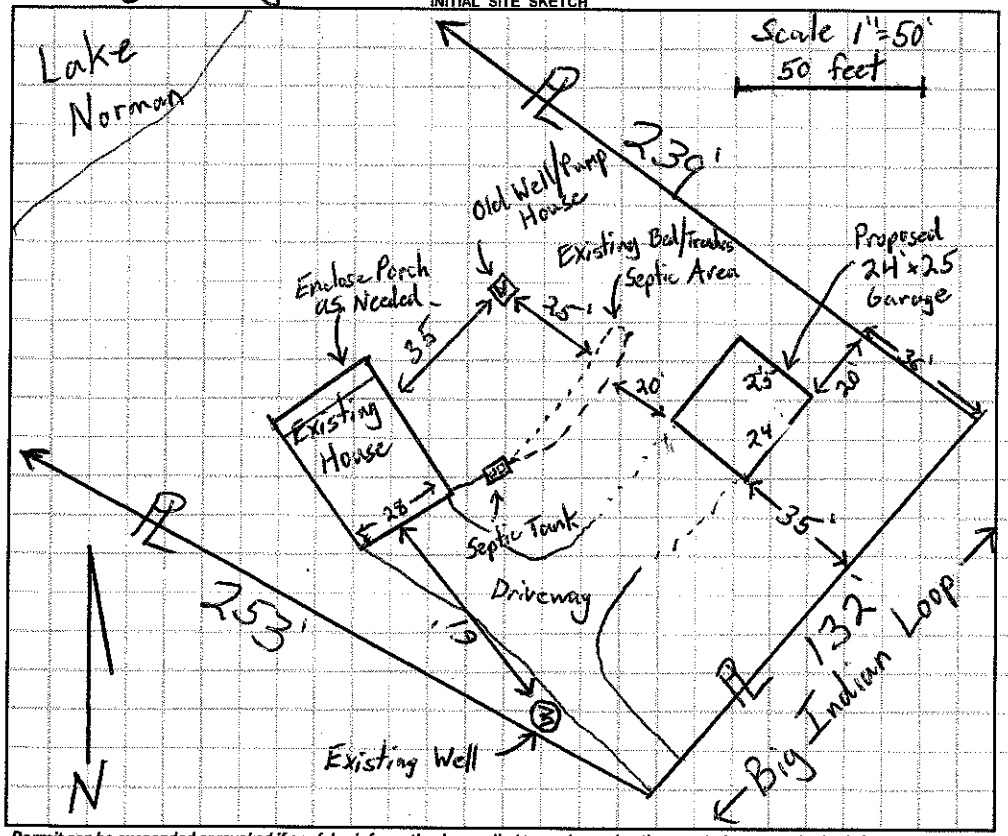

AS BUILT SKETCH

Permit can be suspended or revoked if any false information is supplied toward securing the permit / any unauthorized changes are made to the site / any unauthorized changes are made in the installation of the system. **CONTACT A LOCATOR SERVICE PRIOR TO ANY EXCAVATION**


☐ **IMPROVEMENT PERMIT** *with plat valid without expiration.* ☐ **IMPROVEMENT PERMIT** *with site plan valid for 60 mos.* ☐ **AUTHORIZATION TO CONSTRUCT** *valid for period equal to IMPROVEMENT PERMIT--not to exceed 60 mo.*

Owner / Applicant Signature: Beth Wagner Date: 4/4/16 Installed by:

IMPROVEMENT PERMIT by: Date: OPERATION PERMIT by: Date:

AUTHORIZATION TO CONSTRUCT by: Date: Existing System Inspected by: Tim Rhuch Date: 3-8-16

Health Dept. Copy - WHITE Applicant (Final Approval) - YELLOW Applicant (Conditional Approval) - PINK

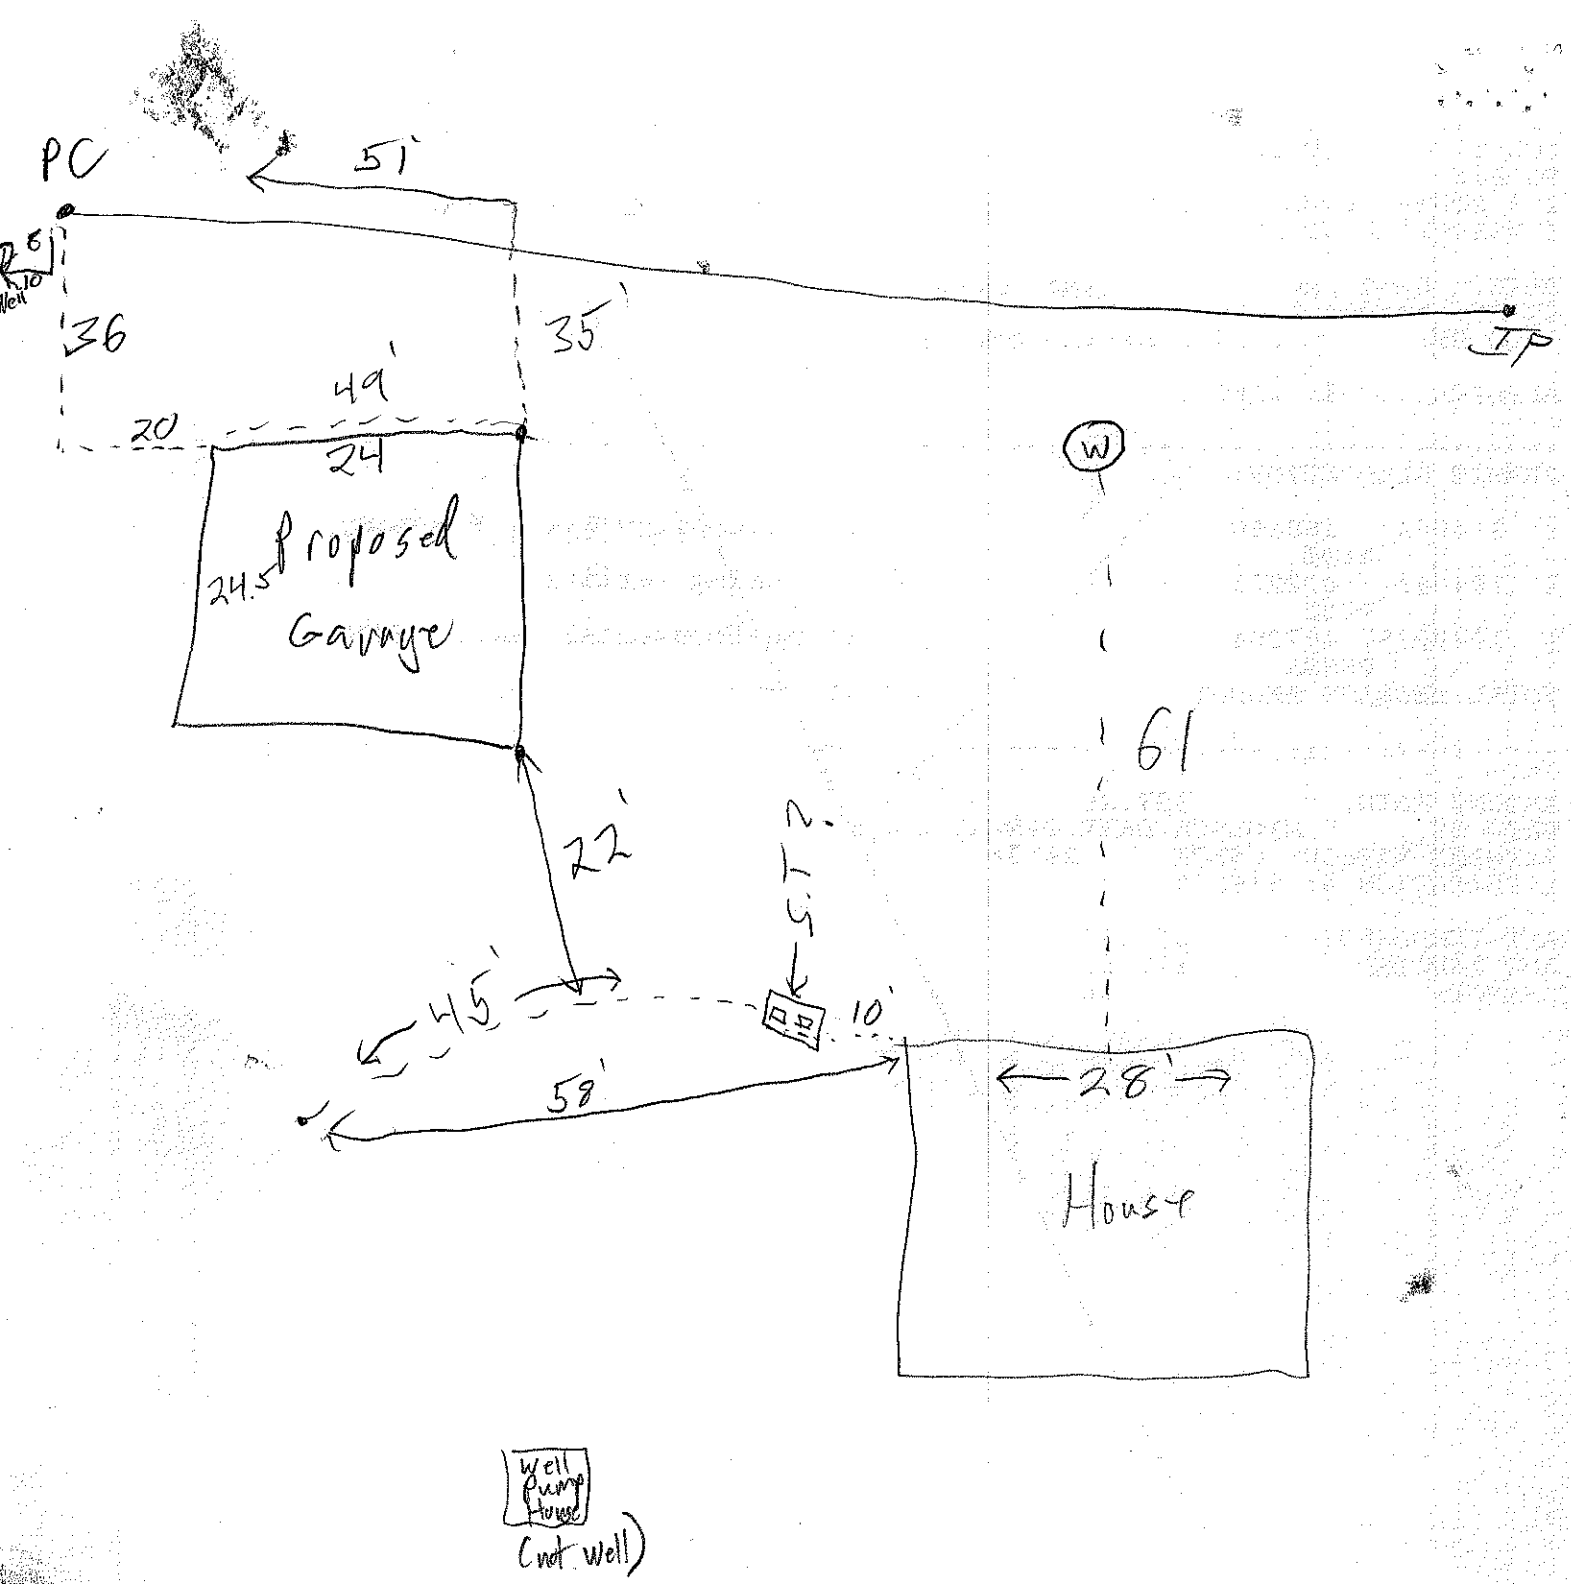
PC
51'
36'
35'
49'
20'
24'
24.5'
Proposed
Garage
IP
W
61'
22'
5.1'
45'
10'
58'
28'
House
Well
Pump
House
(not well)