IREDELL COUNTY HEALTH DEPARTMENT

STATESVILLE 704-878-5305 MOORESVILLE 704-664-5281

Paid 130.00

IMPROVEMENT PERMIT / AUTHORIZATION TO CONSTRUCT / OPERATION PERMIT / EXISTING SYSTEM INSPECTIO

PERMIT# 116423 PIN# 4604835 2755 Family Valve Homes (Jeff) DATE 11-5-03

OWNER OR CONTRACTOR R M Morgan PHONE: Business 799-1560 Home 622-2725

ADDRESS 3535 High Ridge Rd Charlotte, NC 28270

LOCATION Hwy 150 West TR Bluefield TL Big Indian Loop property on right TR

SUBDIVISION N/A BLOCK / SECTION 12 LOT 77 LOT AREA .76 Acre SITE CLASS. PS DESIGN FLOW 480gpd L.T.A.R. .3+

Septic Tank: 1000 Gallons; STR Mull 1600 Date 8-28-04
Pump Tank: 1600 Gallons; PT 62 Date
Pump Make: Model Serial No.
Nitrification Field: No Fields 1 Square Feet 1200 Linear Feet 400'
No Lines 4@100' Trench Width 36" Max Trench Bottom Depth Gravel Depth N/A

[X] New System [ ] Repair System Type: I, II, (III), IV, V, VI
System Description: Gravity - 25% Reduction
Repair System Description: Grav/Pump - Pine Block
Maintenance Agreement Required: [ ] Yes [ ] No


[X] House/Mod. Home No. Bedrooms 4
[ ] Mobile Home No. Bathrooms 3
[ ] Business No. Employees
[ ] Other
[ ] Slab [ ] Crawl Space [X] Basement w/plumbing [ ] Basement wo/plumbing

Water Supply: [X] Individual [ ] Public [ ] Community

Comments:/Conditions: Keep Septic System at least 10' from PL, 50' from lake & at least 50' from any well

Comments:/Conditions: Daylight
10/18/04 OK to run solid pipe under deck stairs ~3' to 4'
OK to use "drop boxes"

INITIAL SITE SKETCH

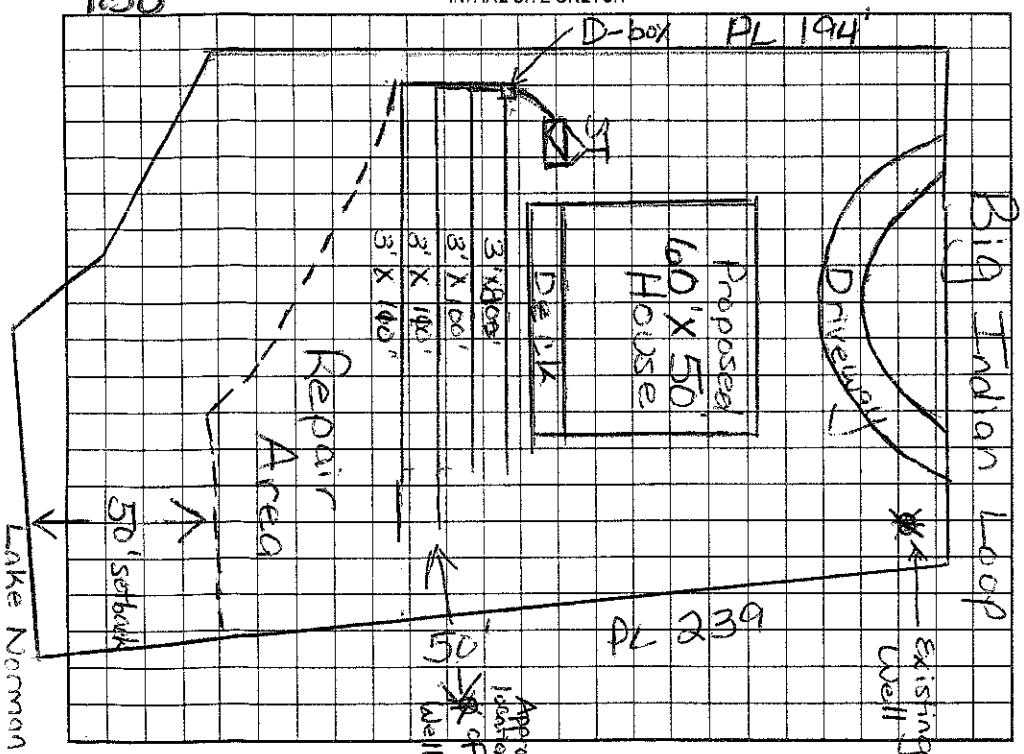

AS BUILT SKETCH

Installed 1-80, 1-100' & 2-110 lines
Used EZ Flow
For Drainfield

Permit can be suspended or revoked if any false information is supplied toward securing the permit/any unauthorized changes are made to the site/any unauthorized changes are made in the installation of the system. Improvement Permit with plat valid without expiration. Improvement Permit with site plan valid for sixty months. Authorization to Construct is valid for a period equal to that of Improvement Permit – not to exceed sixty months.

Signed: date 12/28/03 Installed by: Dennis Willis RS 472-9105 473-3940

Improvement Permit by: Maina M. Dolan RS date 11/5/03 Operation Permit by: Maina M. Dolan RS date 10/19/04

Authorization to Construct by: Maina M. Dolan RS date 11/5/03 Existing System Inspection by: date

HEALTH DEPT. COPY: WHITE OWNER COPY (FINAL): YELLOW OWNER COPY (INITIAL): PINK