C. 361-9708 1.30

IREDELL COUNTY HEALTH DEPARTMENT

STATESVILLE 704-878-5305 MOORESVILLE 704-664-5281

IMPROVEMENT PERMIT / AUTHORIZATION TO CONSTRUCT / OPERATION PERMIT / EXISTING SYSTEM INSPECTION

PERMIT# 080447 PIN# 4648 35 3456 DATE 2/4/00

OWNER OR CONTRACTOR Jerry Horschuck PHONE: Business 814-756-4275 Home

ADDRESS 9235 Point Dr. Allison PA. 16401

LOCATION Big Indian Loop. Bluefield TL Big Indian TR Big Indian, Steep curve to 5 lot on (L)

SUBDIVISION Indian Hill BLOCK / SECTION LOT 5 LOT AREA .86 AC SITE CLASS: PS DESIGN FLOW 360 L.T.A.R. .3

Septic Tank: 1000 Gallons; STB 312 Date 12-11-99
Pump Tank: Gallons; PT Date
Pump Make: Model Serial No.
Nitrification Field: No Fields 1 Square Feet ~~X~~ 900 Linear Feet ~~X~~ 300
No Lines 3 Trench Width 36" Max Trench Bottom Depth ~~36"~~ Gravel Depth SAND


X New System ☐ Repair System Type: I, II, (III), IV, V, VI
System Description: New HAS on C# PLAS.
Repair System Description: SAME
Maintenance Agreement Required: ☐ Yes X No

X House/Mod. Home No. Bedrooms 3
☐ Mobile Home No. Bathrooms 3
☐ Business No. Employees
☐ Other
☐ Slab X Crawl Space ☐ Basement w/plumbing ☐ Basement wo/plumbing

Water Supply: X Individual ☐ Public ☐ Community

Comments:/Conditions:

INITIAL SITE SKETCH

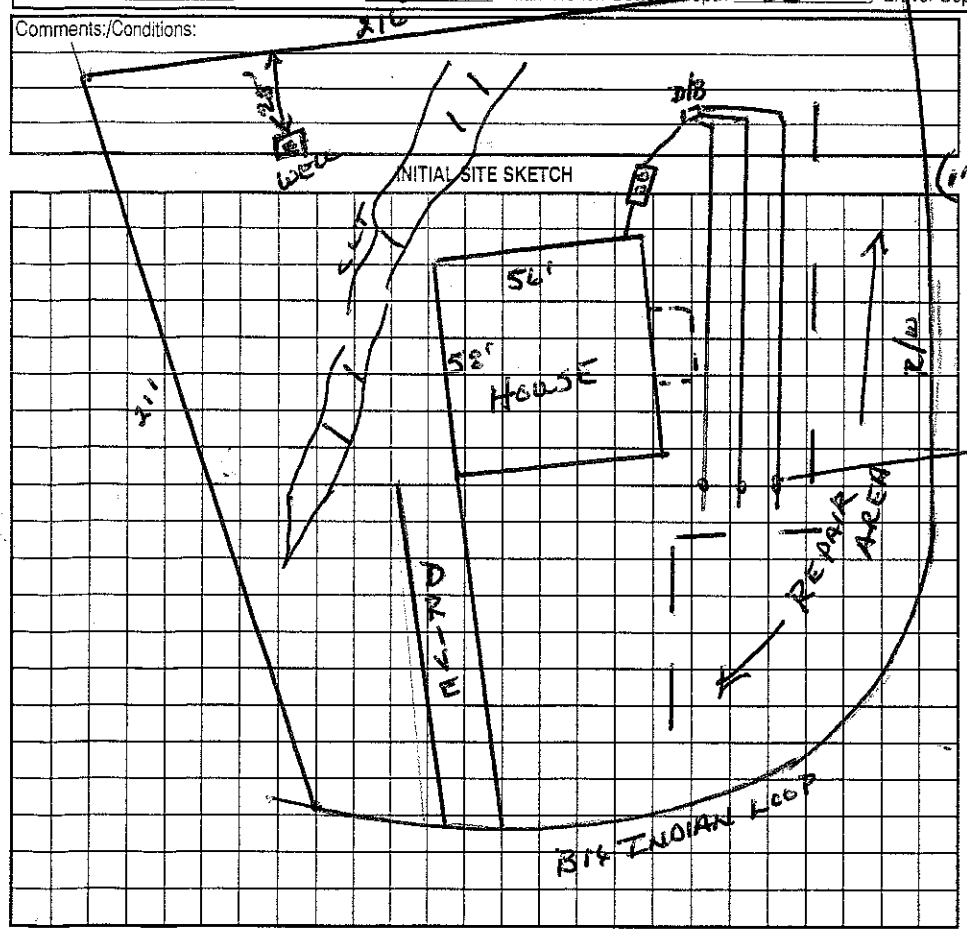

Comments:/Conditions:

AS BUILT SKETCH

Installed at E-Z Lay

Permit can be suspended or revoked if any false information is supplied toward securing the permit/any unauthorized changes are made to the site/any unauthorized changes are made in the installation of the system. Improvement Permit with plat valid without expiration. Improvement Permit with site plan valid for sixty months. Authorization to Construct is valid for a period equal to that of Improvement Permit – not to exceed sixty months.

Signed: ~~X~~ Gail White McKay date 2/4/00 Installed by: Chris Hendrick (Raff?)

Improvement Permit by: Wesley Sparks RS. date 2/4/00 Operation Permit by: Maria H. Hilderbran date 2/9/2000

Authorization to Construct by: Wesley Sparks RS. date 2/4/00 Existing System Inspection by: date

HEALTH DEPT. COPY: WHITE OWNER COPY (FINAL): YELLOW OWNER COPY (INITIAL): PINK