IREDELL COUNTY HEALTH DEPARTMENT

STATESVILLE 704-878-5305 MOORESVILLE 704-664-5281

IMPROVEMENT PERMIT / AUTHORIZATION TO CONSTRUCT / OPERATION PERMIT / EXISTING SYSTEM INSPECTION

PERMIT # 1102725 PIN # 4648354995 DATE 10-25-2010

OWNER or APPLICANT Compass Buildings Realty LLC PHONE: Business 704 483-3633 Home:

OWNER or APPLICANT ADDRESS 3535 N. Hwy 16 Denver, NC 28037

LOCATION / DIRECTIONS Hwy 150 W TR Bluefield TL Big Indian Lp stay to right @ fork on right #731

SUBDIVISION CLATJ BLOCK / SECTION 12 LOT # 79 LOT AREA J DESIGN FLOW 360 gpd. L.T.A/R.

Exist

Septic Tank 1000 Gallons: STB Date

Pump Tank Gallons: P.T Date

Pump Make Model Serial #

Nitrification Field No Fields 1 No Lines 3 Linear Feet 250'

Ex ST Trench Width Bed 74x84 Max. Trench Bottom Depth Gravel Depth 10"

☐ New System ☐ Repair ☐ Expansion System Type I II III IV V VI

System Description: Exist Gravity Gravel Bed

Repair System Description: Modified Conv.

Maintenance Agreement Required ☐ YES ☒ NO

☒ GRAVITY ☐ PRESSURE

☒ Residence No. Bedrooms 3

☐ Business No. Persons

☐ Other No. Employees

☐ Slab ☐ Crawl Space


☐ Basement w/plumbing ☐ Basement w/o plumbing

Water Supply: ☒ Private ☐ Public ☐ Community


Comments / Conditions: ST buried ~5-5.5ft Had to dig up with machine to locate.

Comments / Conditions: Existing Septic System appears to be functioning Okay at time of inspection. Must keep new home at least 5ft from Septic System

INITIAL SITE SKETCH

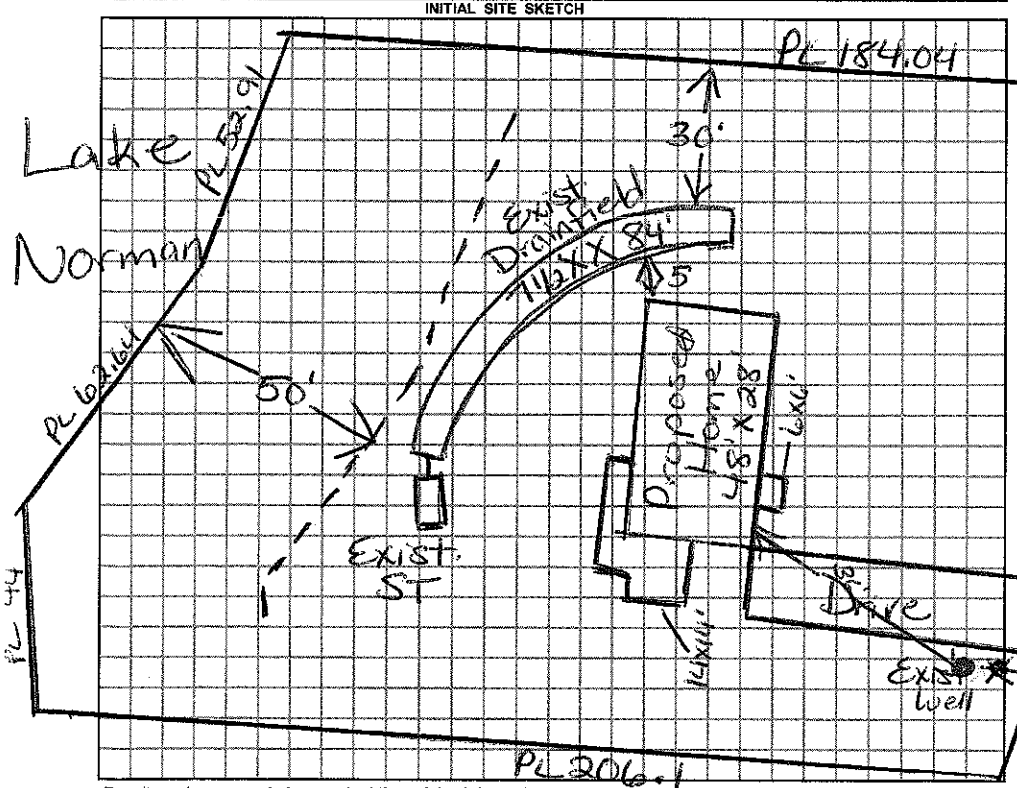

AS BUILT SKETCH

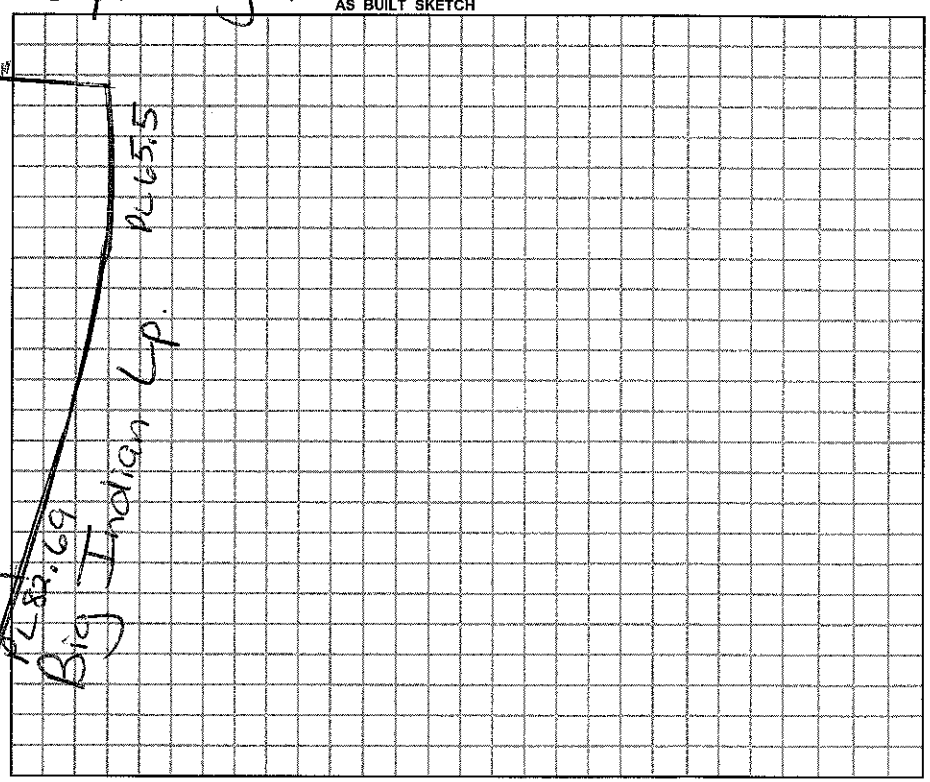

Permit can be suspended or revoked if any false information is supplied toward securing the permit / any unauthorized changes are made to the site / any unauthorized changes are made in the installation of the system.

☐ *IMPROVEMENT PERMIT w / plat valid without expiration.* ☐ *IMPROVEMENT PERMIT w / site plan valid for 60 mos.* ☐ *AUTHORIZATION TO CONSTRUCT valid for period equal to IMPROVEMENT PERMIT-not to exceed 60 mo.*

Owner / Applicant Signature: X [signature] Date 10/27/10

Improvement Permit by: Date

Authorization to Construct by: Date

YOU SHOULD CONTACT A LOCATOR SERVICE PRIOR TO ANY EXCAVATION.

Installed by: FJ Ervin 4-2-75

Operation Permit by: Date:

Existing System Inspected by: [signature] RS Date: 10/25/2010

WHITE COPY Environmental Health YELLOW COPY (Final) Owner / Applicant PINK COPY (Initial) Owner / Applicant