IREDELL COUNTY HEALTH DEPARTMENT

STATESVILLE 704-878-5305 330.00 Paid 3.00 MOORESVILLE 704-664-5281

IMPROVEMENT PERMIT / AUTHORIZATION TO CONSTRUCT / OPERATION PERMIT / EXISTING SYSTEM INSPECTION

PERMIT# 076335 PIN# 4648-35-6667 DATE 2/14/02

OWNER OR CONTRACTOR James McCallum PHONE: Business 704-855-2500 Home

ADDRESS 450 Auction Dr Salisbury NC 28144

LOCATION 150 w, TR Bluefield, TL Big Indian, TR Big Indian, 0.1 Lt 724 Big Indian Loop

SUBDIVISION Indian Hills BLOCK / SECTION LOT 7 LOT AREA 0.90AC SITE CLASS PS DESIGN FLOW 360 L.T.A.R. 0.3

* Septic Tank: 1000 Gallons; STB 794 Date 05/04/01
Pump Tank: 1000 Gallons; PT 763 Date 12/30/01
Pump Make: Little Giant Model 9EHS Serial No.
Nitrification Field: No Fields Square Feet 900 Linear Feet 300' Existing
No Lines 3 Trench Width 36" Max Trench Bottom Depth 36" Gravel Depth —

☒ New System ☐ Repair System Type: I, II, (III), IV, V, VI
System Description: Pump to Existing 25% Red
Repair System Description: Same
Maintenance Agreement Required: ☐ Yes ☒ No

☒ House/Mod. Home No. Bedrooms 3
☐ Mobile Home No. Bathrooms 2
☐ Business No. Employees
☐ Other
☐ Slab ☒ Crawl Space ☐ Basement w/plumbing ☐ Basement wo/plumbing


Water Supply: ☒ Individual ☐ Public ☐ Community

Comments:/Conditions:


* Existing Septic Tank can be Reset Into New Location — Keep well 10 ft. from Septic System

Comments:/Conditions:

INITIAL SITE SKETCH

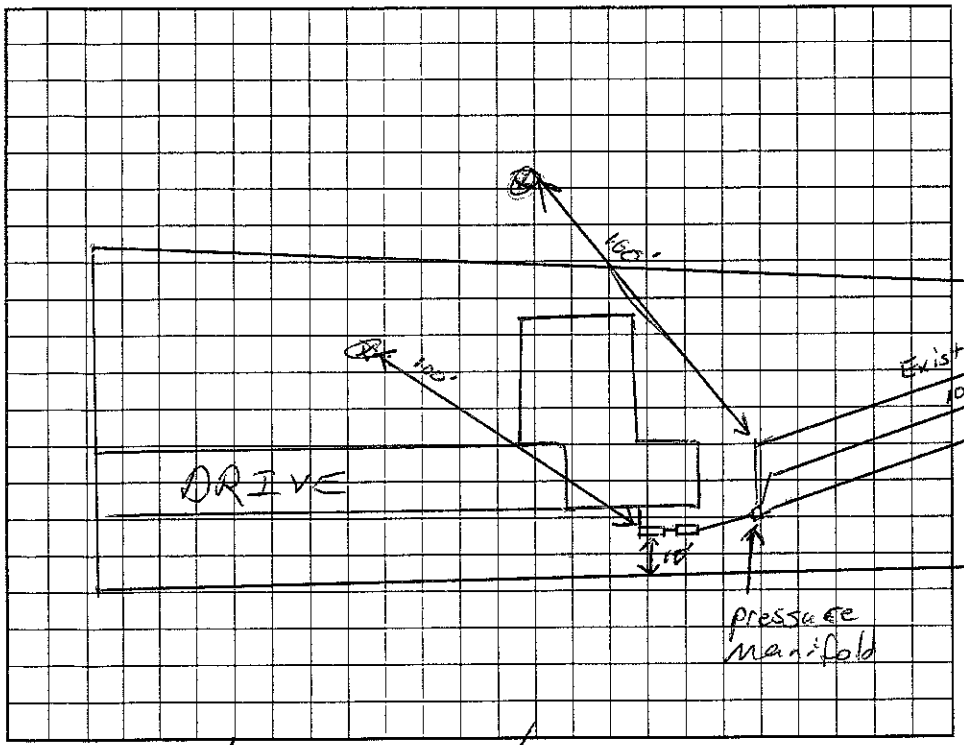

AS BUILT SKETCH

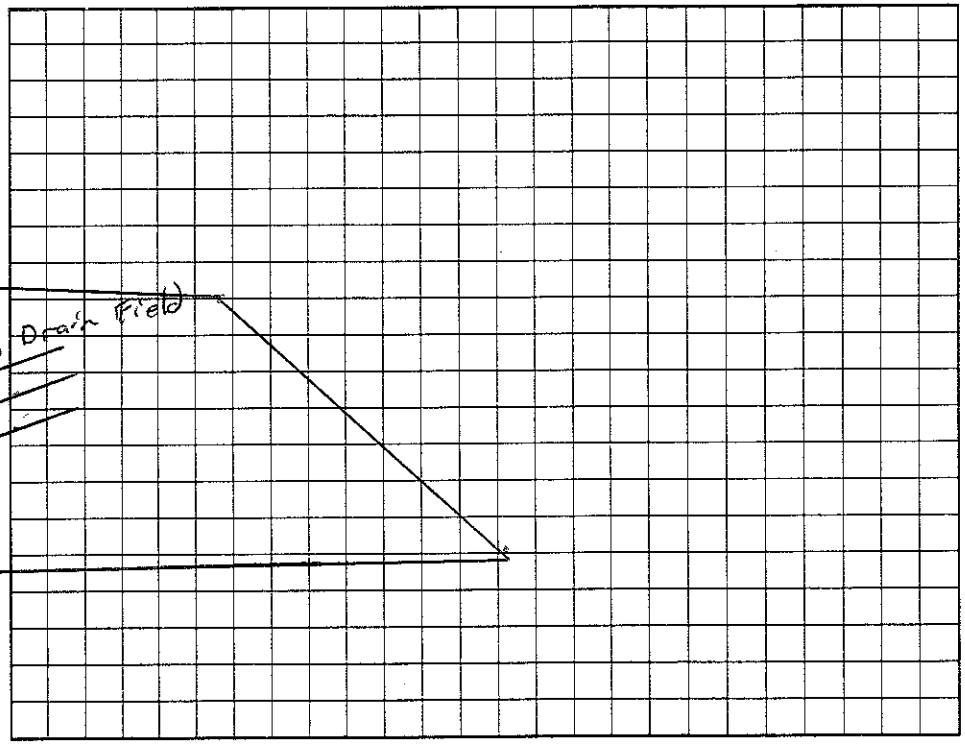

Permit can be suspended or revoked if any false information is supplied toward securing the permit/any unauthorized changes are made to the site/any unauthorized changes are made in the installation of the system. Improvement Permit with plat valid without expiration. Improvement Permit with site plan valid for sixty months. Authorization to Construct is valid for a period equal to that of Improvement Permit – not to exceed sixty months.

Signed: date 19 FEB 02 Installed by: Madison Bros.

Improvement Permit by: RS date 2/14/02 Operation Permit by: date 5/15/02

Authorization to Construct by: RS date 2/14/02 Existing System Inspection by: date

HEALTH DEPT. COPY: WHITE OWNER COPY (FINAL): YELLOW OWNER COPY (INITIAL): PINK

