IREDELL COUNTY HEALTH DEPARTMENT

Authorization to Construct

330 - 400

STATESVILLE 704-878-5305 MOORESVILLE 704-664-5281

IMPROVEMENT PERMIT / ~~CERTIFICATE OF COMPLETION~~ / OPERATION PERMIT / EXISTING SYSTEM INSPECTION

PROPERTY DESCRIPTION NO. 23499 DATE 4/29/96 TAX MAP NO. 2R6-2 Watershed: ☑ Yes ☐ No

OWNER OR CONTRACTOR Robert Wright 4648-35-7361 PHONE: Business _____ Home 663-2941

ADDRESS 649 Big Indian Loop

LOCATION ~~#690~~ Big Indian Loop - Hwy 150 W - TR Bluebird - TL Big Indian Loop - 1st on left - (not lake)

SUBDIVISION Indian Hill BLOCK / SECTION _____ LOT 2 LOT AREA _____ SITE CLASS PS DESIGN FLOW 360 gpd L.T.A.R. 3 gpd/sq ft

Septic Tank: 1000 Gallons; STB 794 Date _____

Pump Tank: _____ Gallons; PT _____ Date _____

Pump Make: _____ Model _____ Serial No. _____

Nitrification Field: No Fields 1 Square Feet 1200 Linear Feet 400

No Lines 4 Trench Width 36" Max Trench Bottom Depth 36" Gravel Depth 12"

☑ New System ☐ Repair System Type: I II III IV V VI

System Description: Gravity Conventional

Repair System Description: Same

Maintenance Agreement Required: ☐ Yes ☑ No

☑ House/Mod. Home No. Bedrooms 5

☐ Mobile Home No. Bathrooms 2

☐ Business No. Employees ____

☐ Other _____


☐ Slab ☐ Crawl Space ☑ Basement w/plumbing ☐ Basement wo/plumbing

Water Supply: ☑ Individual ☐ Community ☐ Public

Comments:

Comments:

INITIAL SITE SKETCH ≈ 1"=60'

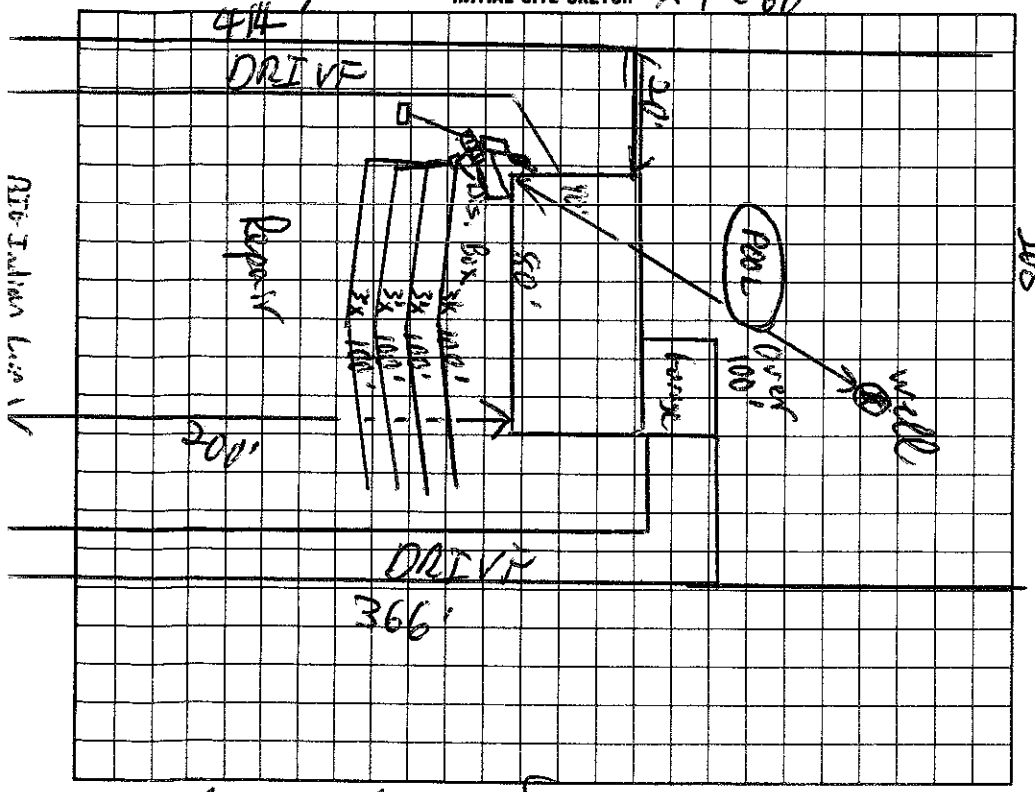

AS BUILT SKETCH

I understand that this permit can be suspended or revoked if any false information is supplied toward securing the permit/any unauthorized changes are made to the site/any unauthorized changes are made in the installation of the system.

Signed: _____

Installed by: Wes Lytton

Improvement Permit by: C. Brad Green EHSI date 4/29/96

Authorization to Construct

Existing System Inspection by: C. Brad Green EHSI date 4/29/96

Certificate of Completion by: _____ date _____

Operation Permit by: Wesley Sparks RS date 6/23/97

HEALTH DEPT. COPY: WHITE INSPECTION COPY (FINAL): GREEN OWNER COPY (FINAL): YELLOW INSPECTION COPY (INITIAL): PINK OWNER COPY (INITIAL): GOLD

Authorization to Construct is valid for 60 months from issue date.