IREDELL COUNTY HEALTH DEPARTMENT

STATESVILLE 704-878-5305 MOORESVILLE 704-664-5281

IMPROVEMENT PERMIT / CERTIFICATE OF COMPLETION / OPERATION PERMIT / EXISTING SYSTEM INSPECTION

PROPERTY DESCRIPTION NO. 18581 DATE 5/4/95 TAX MAP NO. 3A-6-B-8 Watershed: ☐ Yes ☒ No

OWNER OR CONTRACTOR Richard E. Holler Jr. PHONE: Business 4648-35-7748 Home 663-2208

ADDRESS 381 Big Indian Loop. Mooresville, NC.

LOCATION Blue arrow TL on Big Indian Lp. 1ST (R) around curve on (L) above road

SUBDIVISION Indian Hills BLOCK / SECTION _____ LOT 8 LOT AREA ~1.07AC SITE CLASS. P DESIGN FLOW 360 L.T.A.R. .3

Septic Tank: 1000 Gallons; STB 794 Date 3/1/96

Pump Tank: _____ Gallons; PT _____ Date _____

Pump Make: _____ Model _____ Serial No. (300 ✱ ~~400~~)

Nitrification Field: No Fields 1 Square Feet 1200 Linear Feet ~~400~~

No Lines ✱75' Trench Width 36" Max Trench Bottom Depth 36" Gravel Depth 12"

☒ New System ☐ Repair System Type: I, II, III, IV, V, VI

System Description: CONV - DIST Box

Repair System Description: Pres Panel

Maintenance Agreement Required: ☐ Yes ☐ No

☒ House/Mod. Home No. Bedrooms 3

☐ Mobile Home No. Bathrooms 2

☐ Business No. Employees ____

☐ Other _____


☐ Slab ☐ Crawl Space ☒ Basement w/plumbing ☐ Basement wo/plumbing

Water Supply: ☒ Individual ☐ Community ☐ Public


Comments: ✱ May use 300 feet of chamber Plastic chamfield - Hess

Comments: installed as shown on dep. Permit.

INITIAL SITE SKETCH

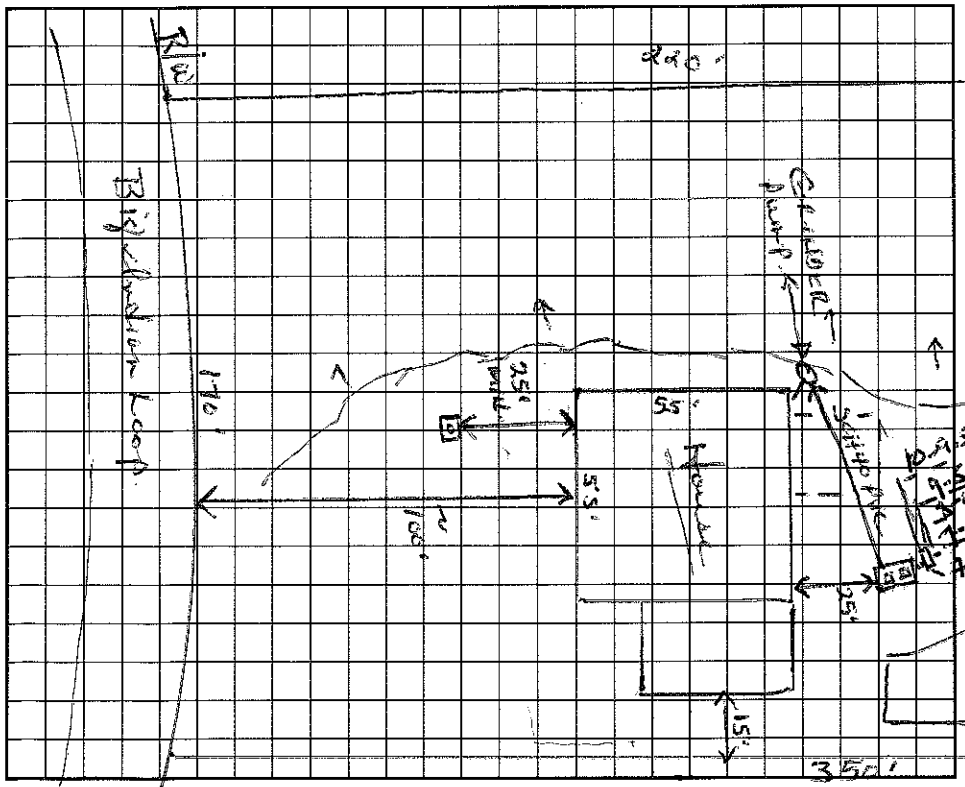

AS BUILT SKETCH

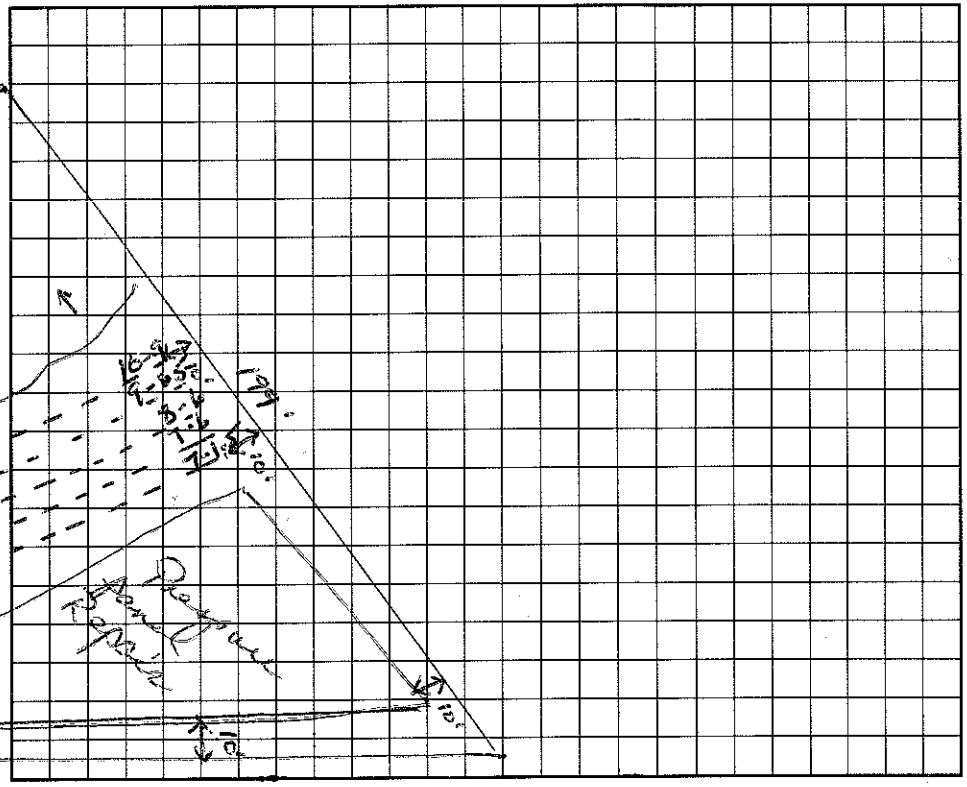

I understand that this permit can be suspended or revoked if any false information is supplied toward securing the permit/any unauthorized changes are made to the site/any unauthorized changes are made in the installation of the system. Improvement Permit is valid for 60 months from date of issuance.

Signed: ✱ Rick Holler

Improvement Permit by: Wesley Sparks RS. date 5/4/95

Existing System Inspection by: _____ date _____

Installed by: Tim Simmons

Certificate of Completion by: _____ date _____

Operation Permit by: Wesley Sparks RS. date 5/2/96

HEALTH DEPT. COPY: WHITE INSPECTION COPY (FINAL): GREEN OWNER COPY (FINAL): YELLOW INSPECTION COPY (INITIAL): PINK OWNER COPY (INITIAL): GOLD