IREDELL COUNTY HEALTH DEPARTMENT

STATESVILLE 704-878-5305 MOORESVILLE 704-664-5281

IMPROVEMENT PERMIT / AUTHORIZATION TO CONSTRUCT / OPERATION PERMIT / EXISTING SYSTEM INSPECTION

PERMIT# 131656 PIN# 4648358105 DATE 10-31-05

OWNER OR APPLICANT John & Joyce Viesta (John Brown) PHONE: Business 704-682-0749 Home

ADDRESS 825 83rd Dr. Vero Beach FL

LOCATION 21 N TL Cornelius TL Bluefield TR Big Indian Loop TR Indian Loop again on left

SUBDIVISION Indian Hill BLOCK / SECTION LOT 1 LOT AREA 1.4 Ac. SITE CLASS PS DESIGN FLOW 360 L.T.A.R. .3 gpd / Ft²

Septic Tank: 1000 Gallons; STB 760 Date 3-20

Pump Tank: 1000 Gallons; PT 863 Date 4-17

Pump Make: Model Serial No.

Nitrification Field: No Fields 1 Square Feet Linear Feet 200

No Lines 5 Trench Width 24" Max Trench Bottom Depth 36" Gravel Depth NA ☐ Gravity ☒ Pressure

☒ New System ☐ Repair ☐ Expansion System Type: I II III IV V VI

System Description: LP Panel

Repair System Description: Same

Maintenance Agreement Required: ☒ Yes ☐ No

☒ House/Mod. Home No. Bedrooms 3

☐ Mobile Home No. Persons

☐ Business No. Employees

☐ Other

Water Supply: ☒ Individual ☐ Public ☐ Community

☐ Slab ☐ Crawl Space ☐ Basement w/plumbing ☒ Basement wo/plumbing

Comments/Conditions: 46 panels in 5 lines


Comments/Conditions:

Keep system 15' from diversion ditch


Fill concave area after installation

1" = 50'

INITIAL SITE SKETCH

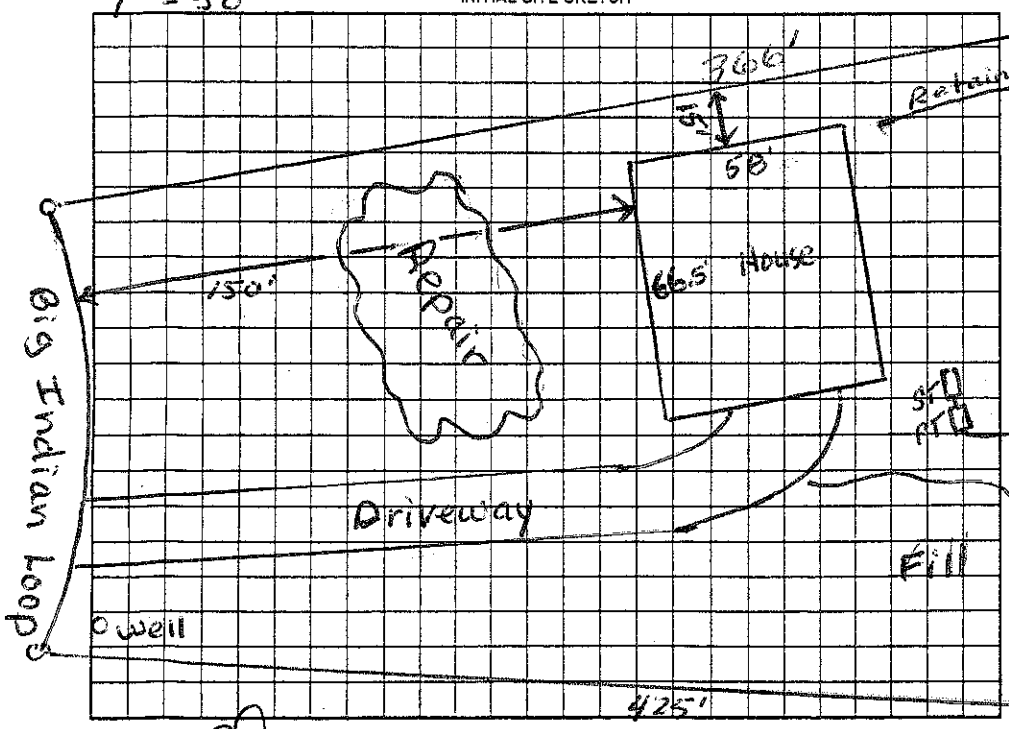

AS BUILT SKETCH

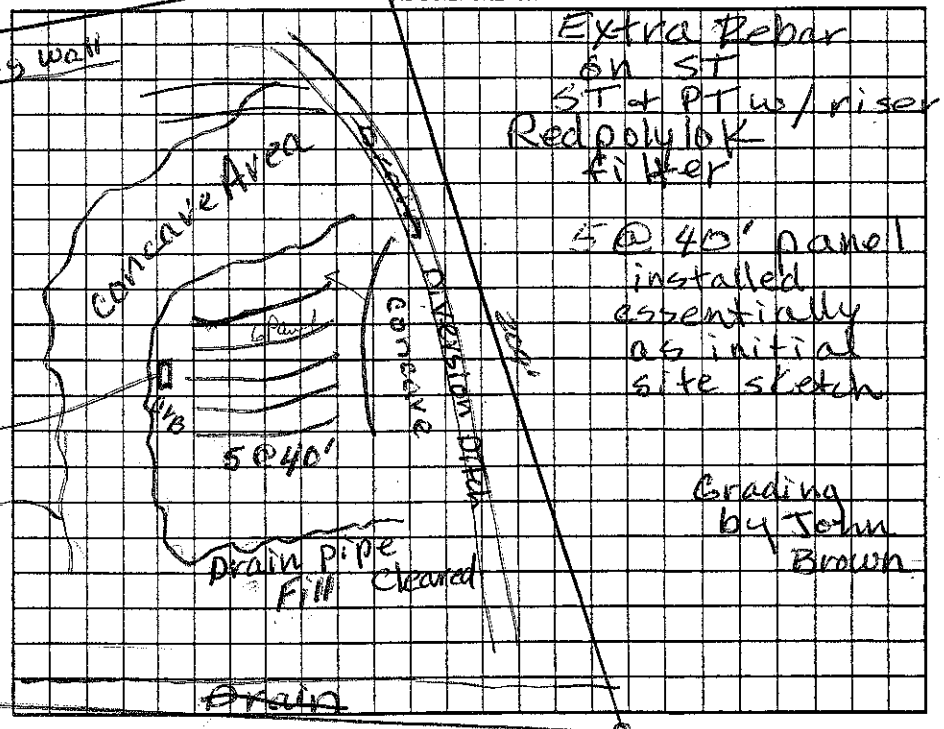

Permit can be suspended or revoked if any false information is supplied toward securing the permit/any unauthorized changes are made to the site/any unauthorized changes are made in the installation of the system. Improvement Permit with plat valid without expiration ☐ Improvement Permit with site plan valid for sixty months ☐ Authorization to Construct is valid for a period equal to that of Improvement Permit – not to exceed sixty months.

Signed: John R Brown date 11-1-05 Installed by: Sammy Reavis

Improvement Permit by: Judy Melville date 11-1-05 Operation Permit by: Judy Melville date 7-20-07

Authorization to Construct by: Judy Melville date 11-1-05 Existing System Inspection by: date

HEALTH DEPT. COPY: WHITE OWNER COPY (FINAL): YELLOW OWNER COPY (INITIAL): PINK