IREDELL COUNTY HEALTH DEPARTMENT

AUTHORIZATION TO CONSTRUCT 881-8165 ~~2150 HED~~ 11:30

STATESVILLE 704-878-5305 MOORESVILLE 704-664-5281

IMPROVEMENT PERMIT / ~~CERTIFICATE OF COMPLETION~~ / OPERATION PERMIT / EXISTING SYSTEM INSPECTION

PROPERTY DESCRIPTION NO. 24005 DATE 8/6/96 TAX MAP NO. 2P-6-B-11 Watershed: ☑ Yes ☐ No

OWNER OR CONTRACTOR RONALD PLUMMER ~~PHONE: Business~~ 4648-3501979 Home 549-5740

ADDRESS 3000 A HIGH GLEN DR. CHARLOTTE 28269

LOCATION 150W - TR BLUEFIELD RD. -TL BIG INDIAN LOOP - TAKE RT - 2ND LOT ON LEFT BEFORE LEFT TURN

SUBDIVISION INDIAN HILL BLOCK / SECTION ____ LOT 11 LOT AREA ____ SITE CLASS. PS DESIGN FLOW 360GPD L.T.A.R. .3GPD/FT

Septic Tank: 1000 Gallons; STB 794 Date 4/~~5~~/97 ☑ New System ☐ Repair System Type: I, II, III, IV, V, VI

Pump Tank: ____ Gallons; PT ____ Date ____ System Description: GRAVITY CHAMBERED

Pump Make: ____ Model ____ Serial No. ____ Repair System Description: PUMP/~~GRAVITY~~ PANEL

Nitrification Field: No Fields 1 Square Feet 900 Linear Feet 300 Maintenance Agreement Required: ☐ Yes ☑ No

No Lines 3 Trench Width 36" Max Trench Bottom Depth 36" Gravel Depth N/A

☑ House/Mod. Home No. Bedrooms 3 ☐ Mobile Home No. Bathrooms 2 ☐ Business No. Employees ____ ☐ Other ____


☐ Slab ☑ Crawl Space ☐ Basement w/plumbing ☐ Basement wo/plumbing

Water Supply: ☑ Individual ☐ Community ☐ Public


Comments: STAY 50' FROM NEIGHBOR'S WELL.

Comments: CHANGED UPPER 2 LINES & TANK CHECKED BECAUSE HOUSE WAS MOVED

INITIAL SITE SKETCH 1"=40'

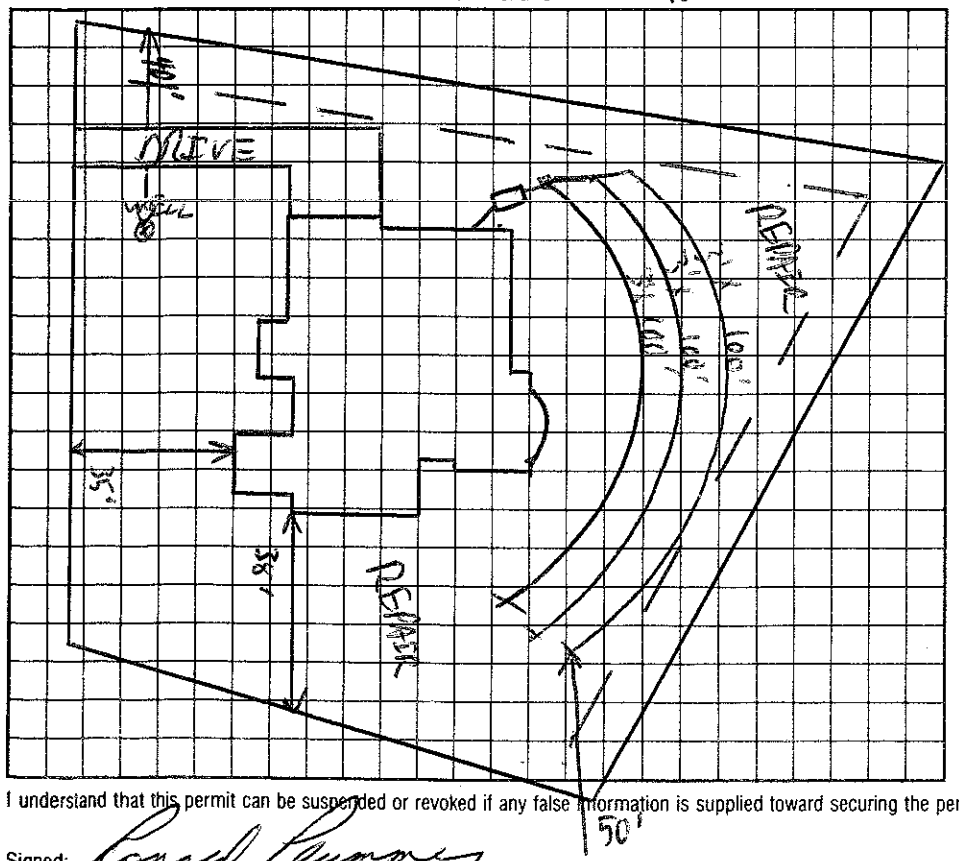

AS BUILT SKETCH

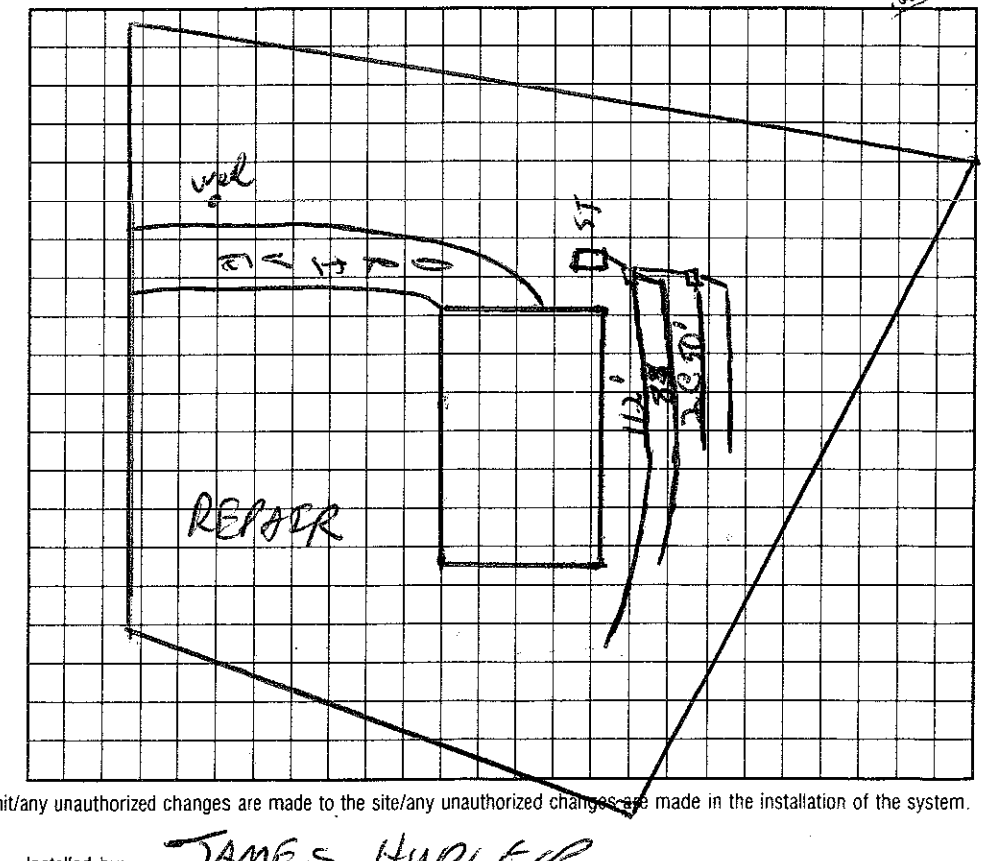

I understand that this permit can be suspended or revoked if any false information is supplied toward securing the permit/any unauthorized changes are made to the site/any unauthorized changes are made in the installation of the system.

Signed: Ronald Plummer Installed by: JAMES HUDLER

Improvement Permit by: C. Blythe EHSE date 8/6/96

CONSTRUCTION AUTHORIZATION Existing System Inspection by: C. Blythe EHSE date 8/6/96 Certificate of Completion by: ____ date ____

Operation Permit by: C. Blythe date 7/10/97

HEALTH DEPT. COPY: WHITE INSPECTION COPY (FINAL): GREEN OWNER COPY (FINAL): YELLOW INSPECTION COPY (INITIAL): PINK OWNER COPY (INITIAL): GOLD

AUTHORIZATION TO CONSTRUCT IS VALID FOR 60 MONTHS FROM ISSUE DATE.