IREDELL COUNTY HEALTH DEPARTMENT

STATESVILLE 704-878-5305 MOORESVILLE 704-664-5281

1:30

IMPROVEMENT PERMIT / AUTHORIZATION TO CONSTRUCT / OPERATION PERMIT / EXISTING SYSTEM INSPECTION

PERMIT# 080446 PIN# 4648 36 8194 DATE 2/3/00

OWNER OR CONTRACTOR Jerry Hoboschuck PHONE: Business 814-756-4275 Home

ADDRESS 9235 Pond Dr. Albion, PA 16401

LOCATION 150 W TR 15 Mansfield Rd. TL Big Indian Loop TR Big Indian Loop on (L) in first sharp curve

SUBDIVISION Indian Hill BLOCK / SECTION LOT 10 LOT AREA .67 Ac SITE CLASS PS DESIGN FLOW 360 L.T.A.R. .3

Septic Tank: 1000 Gallons; STB 7964 Date 12-16-99
Pump Tank: Gallons; PT Date
Pump Make: Model Serial No.
Nitrification Field: No Fields 1 Square Feet 900 ± Linear Feet 300 ±
No Lines 3 Trench Width 36" Max Trench Bottom Depth 36" Gravel Depth SAND.

[X] New System [ ] Repair System Type: I, II, (III) IV, V, VI
System Description: CH PLAS on NDS
Repair System Description: 16" PPBS
Maintenance Agreement Required: [ ] Yes [X] No


[X] House/Mod. Home No. Bedrooms 3
[ ] Mobile Home No. Bathrooms 3
[ ] Business No. Employees
[ ] Other
[ ] Slab [X] Crawl Space [ ] Basement w/plumbing [ ] Basement wo/plumbing

Water Supply: [X] Individual [ ] Public [ ] Community


Comments:/Conditions: * Inspection Ports and Spot Levelers Required

Comments:/Conditions: Riser & Filter installed

INITIAL SITE SKETCH (1"=50')

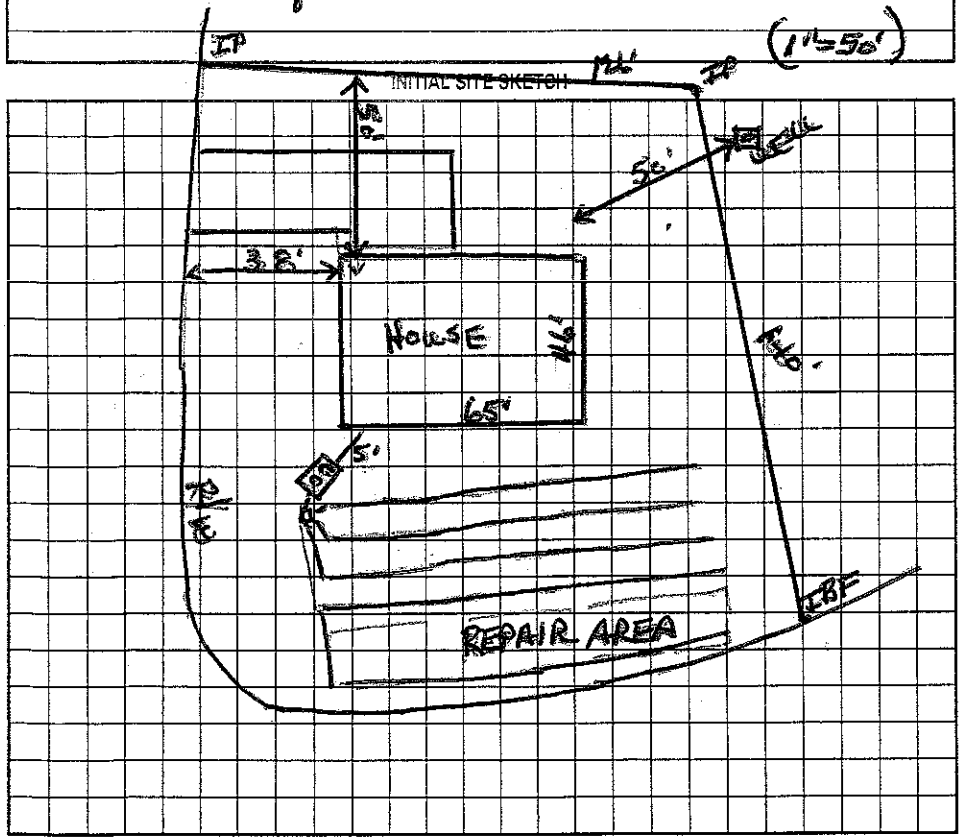

AS BUILT SKETCH

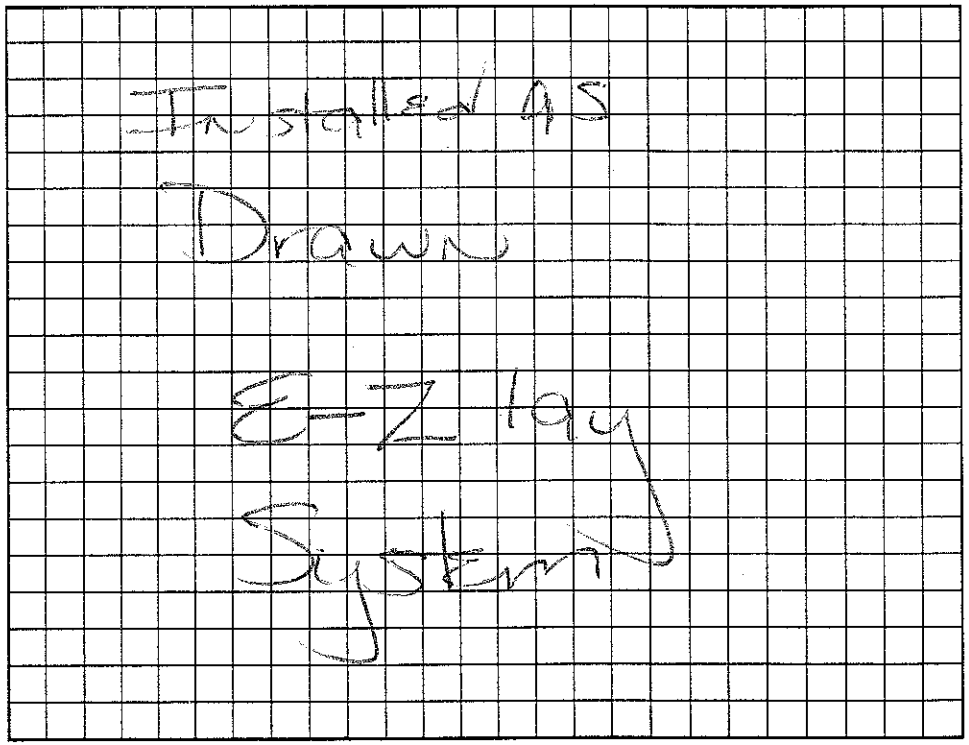

Permit can be suspended or revoked if any false information is supplied toward securing the permit/any unauthorized changes are made to the site/any unauthorized changes are made in the installation of the system. Improvement Permit with plat valid without expiration. Improvement Permit with site plan valid for sixty months. Authorization to Construct is valid for a period equal to that of Improvement Permit – not to exceed sixty months.

Signed: K C Carlo McElroy date 2/7/00

Improvement Permit by: Wesley Sparks R.S. date 2/3/00

Authorization to Construct by: Wesley Sparks R.S. date 2/3/00

Installed by: R&H Construction

Operation Permit by: Marion H. Dalton R.S. date 2/9/2000

Existing System Inspection by: date

HEALTH DEPT. COPY: WHITE OWNER COPY (FINAL): YELLOW OWNER COPY (INITIAL): PINK