IREDELL COUNTY HEALTH DEPARTMENT

Mid 175.00 PT Last - 350-400

STATESVILLE 704-878-5305 MOORESVILLE 704-664-5281 900

IMPROVEMENT PERMIT / AUTHORIZATION TO CONSTRUCT / OPERATION PERMIT / EXISTING SYSTEM INSPECTION

PERMIT# 091650 PIN# 4646483926401670 DATE 9-12-2000

OWNER OR CONTRACTOR New Concept Dev./Brian Stephenson PHONE: Business 663-2590 Home

ADDRESS P.O. Box 1335 Troutman, NC 28166

LOCATION Cornelios TL Judas TR Meigs

SUBDIVISION Shade BLOCK / SECTION 5 LOT 6 LOT AREA .57 Acre SITE CLASS. PS DESIGN FLOW 480gpd L.T.A.R. .3

Septic Tank: 1000 Gallons; STB 1012 Date 6-26-2000

Pump Tank: Gallons; PT Date

Pump Make: Model Serial No.

Nitrification Field: No Fields 1 Square Feet 1197 Linear Feet 399

No Lines 7 at 57' Trench Width 36" Max Trench Bottom Depth 36" Gravel Depth N/A

☒ New System ☐ Repair System Type: I, II, III, IV, V, VI

System Description: Gravity - 25% Reduction

Repair System Description: Pump - 50% Panel

Maintenance Agreement Required: ☐ Yes ☐ No

☐ House/Mod. Home ☒ Mobile Home ☐ Business ☐ Other

No. Bedrooms 4 No. Bathrooms 3 No. Employees


☐ Slab ☒ Crawl Space ☐ Basement w/plumbing ☐ Basement wo/plumbing

Water Supply: ☒ Individual ☐ Public ☐ Community


Comments:/Conditions: Keep Septic System at least 10' From PL, 50' From Well (any well) & 5' From House

Comments:/Conditions: MH not set up yet. Well not installed at time of inspection

INITIAL SITE SKETCH Scale 1:50'

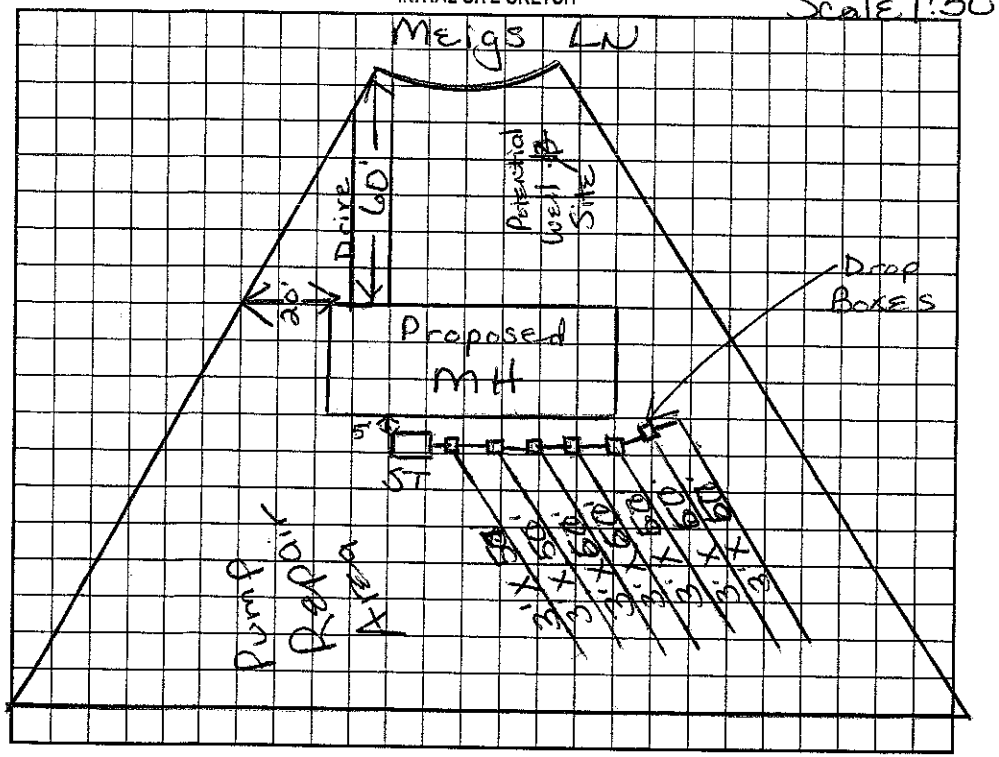

AS BUILT SKETCH

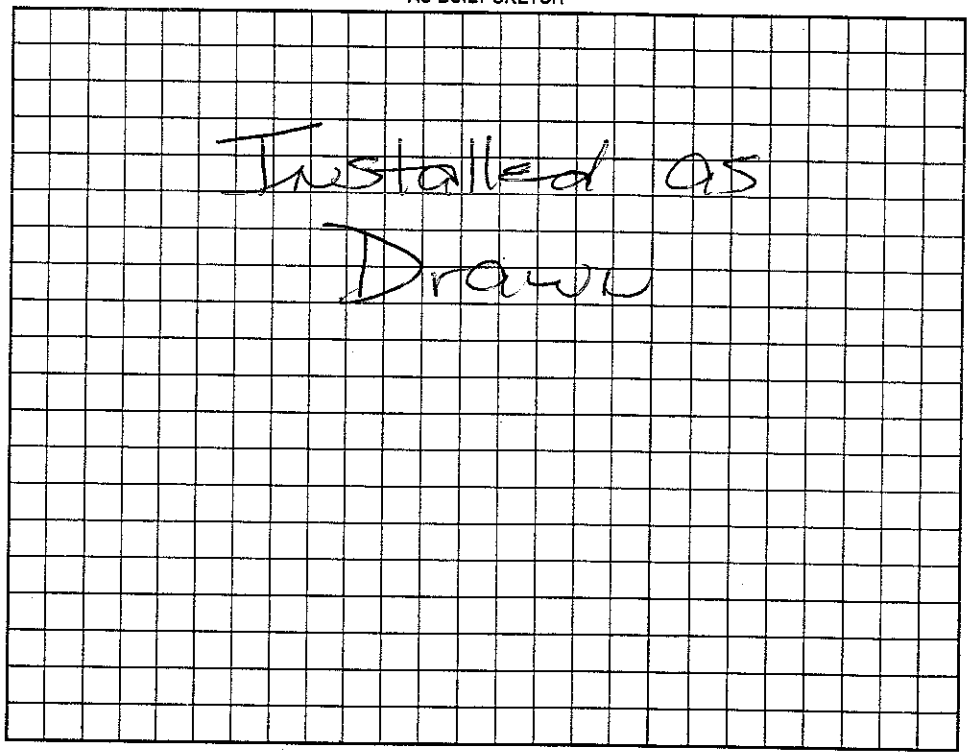

Permit can be suspended or revoked if any false information is supplied toward securing the permit/any unauthorized changes are made to the site/any unauthorized changes are made in the installation of the system. Improvement Permit with plat valid without expiration. Improvement Permit with site plan valid for sixty months. Authorization to Construct is valid for a period equal to that of Improvement Permit – not to exceed sixty months.

Signed: [signature] date 9-12-2000 Installed by: Craig Thompson

Improvement Permit by: Maisie H. Dotson date 9/12/00 Operation Permit by: Maisie H. Dotson RS date 9/28/2000

Authorization to Construct by: Maisie H. Dotson date 9/12/00 Existing System Inspection by: date

HEALTH DEPT. COPY: WHITE OWNER COPY (FINAL): YELLOW OWNER COPY (INITIAL): PINK