IREDELL COUNTY HEALTH DEPARTMENT

STATESVILLE 704-878-5305 MOORESVILLE 704-664-5281

IMPROVEMENT PERMIT / AUTHORIZATION TO CONSTRUCT / OPERATION PERMIT / EXISTING SYSTEM INSPECTION

PERMIT# 088215 PIN# 4648 39 ~~2646~~ Pt. DATE 4/3/00

OWNER OR CONTRACTOR Usvaldo DeLeon 2575 PHONE: Business Home 664-9884

ADDRESS 207 Talbert Rd. Mooresville, NC. 28117

LOCATION Cornelius Rd. TR Judas Rd. Tr Meigs Lane, ct cul de sac straight ahead

SUBDIVISION SHADE BLOCK / SECTION LOT 7 LOT AREA .57 Ac SITE CLASS PS DESIGN FLOW 360 L.T.A.R. .3

Septic Tank: 1000 Gallons; STB 32 Date 2/27/00

Pump Tank: Gallons; PT Date

Pump Make: Model Serial No.

Nitrification Field: No Fields 1 Square Feet 900 Linear Feet 300

No Lines 4 @ 75' x 3' Trench Width 3' Max Trench Bottom Depth 36"

☒ New System ☐ Repair System Type: I, II, (III), IV, V, VI

System Description: GRAVITY - HOS on CA. Plastic

Repair System Description: Same

Maintenance Agreement Required: ☐ Yes ☒ No

~~Gravel Depth~~ SAND ☐ Slab ☒ Crawl Space ☐ Basement w/plumbing ☐ Basement wo/plumbing

☐ House/Mod. Home No. Bedrooms 3

☒ Mobile Home No. Bathrooms 3

☐ Business No. Employees


☐ Other

Water Supply: ☒ Individual ☐ Public ☐ Community

Comments:/Conditions:

Comments:/Conditions:

INITIAL SITE SKETCH 1"=50'

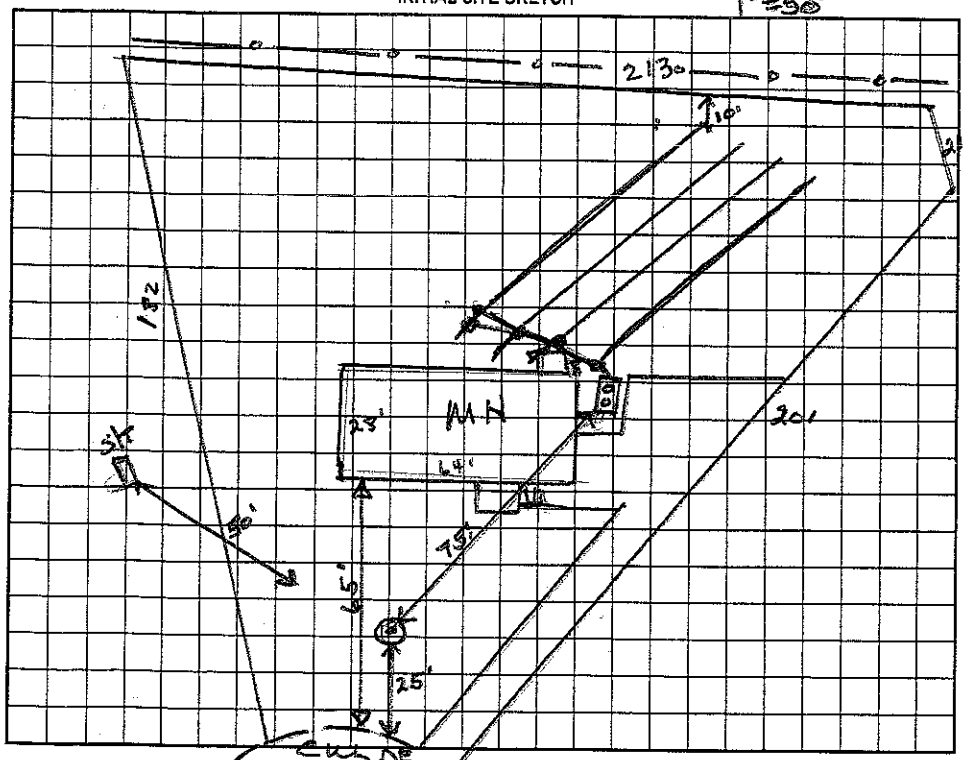

AS BUILT SKETCH

Permit can be suspended or revoked if any false information is supplied toward securing the permit/any unauthorized changes are made to the site/any unauthorized changes are made in the installation of the system. Improvement Permit with plat valid without expiration. Improvement Permit with site plan valid for sixty months. Authorization to Construct is valid for a period equal to that of Improvement Permit – not to exceed sixty months.

Signed: ✕ date 4/4/00

Improvement Permit by: Wesley Sparks RS. date 4/3/00

Authorization to Construct by: Wesley Sparks RS. date 4/3/00

Installed by: D+M Construction

Operation Permit by: Wesley Sparks RS. date 4/12/00

Existing System Inspection by: date

HEALTH DEPT. COPY: WHITE OWNER COPY (FINAL): YELLOW OWNER COPY (INITIAL): PINK