4648394517 1:30

IREDELL COUNTY HEALTH DEPARTMENT

STATESVILLE 704-878-5305 MOORESVILLE 704-664-5281

IMPROVEMENT PERMIT / AUTHORIZATION TO CONSTRUCT / OPERATION PERMIT / EXISTING SYSTEM INSPECTION

PERMIT# 084311 PIN# ~~4648 38 3634 PT~~ DATE 11/8/99

OWNER OR CONTRACTOR Rufus Love PHONE: Business 892-4249 Home

ADDRESS PO Box 11 Davidson, NC. 28036

LOCATION Cornelius Rd. TR Judah Rd. TL Meigs Ln. 1st lot on (L)

SUBDIVISION SHADE BLOCK / SECTION IV LOT 8 LOT AREA .58 SITE CLASS. P3 DESIGN FLOW 360 L.T.A.R. .3

Septic Tank: 1000 Gallons; STB 1012 Date 10/17/99
Pump Tank: Gallons; PT Date
Pump Make: Model Serial No.
Nitrification Field: No Fields 1 Square Feet 1200 Linear Feet 400
No Lines 5 Trench Width 36" Max Trench Bottom Depth 36" Gravel Depth 12"

[X] New System [ ] Repair System Type: I, (II), III, IV, V, VI
System Description: GRAV - CONVENTIONAL
Repair System Description:
Maintenance Agreement Required: [ ] Yes [ ] No

[X] House/Mod. Home No. Bedrooms 3
[ ] Mobile Home No. Bathrooms 2
[ ] Business No. Employees
[ ] Other


[ ] Slab [X] Crawl Space [ ] Basement w/plumbing [ ] Basement wo/plumbing

Water Supply: [X] Individual [ ] Public [ ] Community

Comments:/Conditions:

(1" = 50')

INITIAL SITE SKETCH

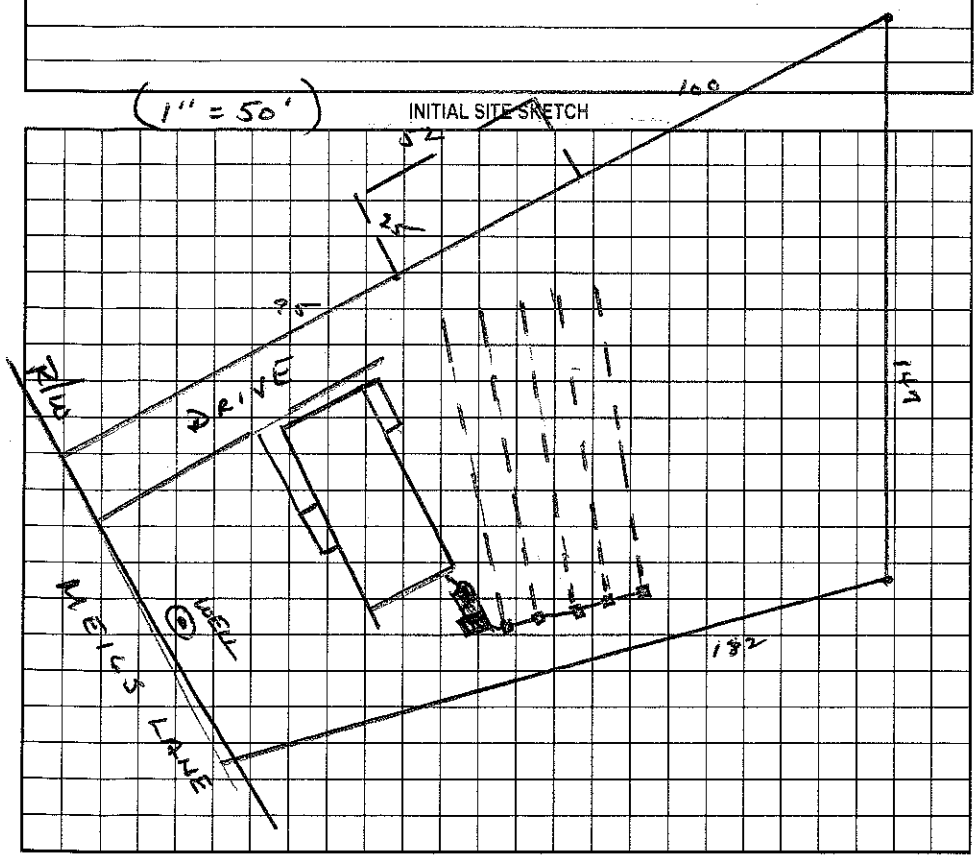

Comments:/Conditions:

AS BUILT SKETCH

Permit can be suspended or revoked if any false information is supplied toward securing the permit/any unauthorized changes are made to the site/any unauthorized changes are made in the installation of the system. Improvement Permit with plat valid without expiration. Improvement Permit with site plan valid for sixty months. Authorization to Construct is valid for a period equal to that of Improvement Permit – not to exceed sixty months.

Signed: [signature] date 11-15-99 Installed by: A-1 Backhoe

Improvement Permit by: Wesley Sparks RS. date 11/8/99 Operation Permit by: Wesley Sparks R.S. date 12/8/99

Authorization to Construct by: Wesley Sparks RS date 11/8/99 Existing System Inspection by: date

HEALTH DEPT. COPY: WHITE OWNER COPY (FINAL): YELLOW OWNER COPY (INITIAL): PINK