IREDELL COUNTY HEALTH DEPARTMENT

STATESVILLE 704-878-5305 MOORESVILLE 704-664-5281

IMPROVEMENT PERMIT / AUTHORIZATION TO CONSTRUCT / OPERATION PERMIT / EXISTING SYSTEM INSPECTION

PERMIT# 073443 PIN# 4648 39 ~~3639~~ (PT) DATE 9/16/98

OWNER OR CONTRACTOR Terry R. Alexander 4822 PHONE: Business Home 896-5251

ADDRESS PO Box 513 Mt Mourney NC. 28123

LOCATION Judys Rd. Connelius Rd TR Judes Rd ~ .5 mile on (L)

SUBDIVISION Shade BLOCK / SECTION LOT 2 LOT AREA .5 SITE CLASS. PS DESIGN FLOW 360 L.T.A.R. .3

Septic Tank: 1000 Gallons; STB 101 2 Date 7/28/98
Pump Tank: Gallons; PT Date
Pump Make: Model Serial No.
Nitrification Field: No Fields 1 Square Feet 900* Linear Feet 300*
No Lines 4 Trench Width 36" Max Trench Bottom Depth 36" Gravel Depth SAND

[X] New System [ ] Repair System Type: I, II, III, IV, V, VI
System Description: GRAV - CH PLASTIC
Repair System Description: SAME
Maintenance Agreement Required: [ ] Yes [X] No


[ ] House/Mod. Home No. Bedrooms 3
[ ] Mobile Home No. Bathrooms 2
[ ] Business No. Employees
[ ] Other
[ ] Slab [X] Crawl Space [ ] Basement w/plumbing [ ] Basement wo/plumbing

Water Supply: [X] Individual [ ] Public [ ] Community

Comments:/Conditions:

Comments:/Conditions:

INITIAL SITE SKETCH

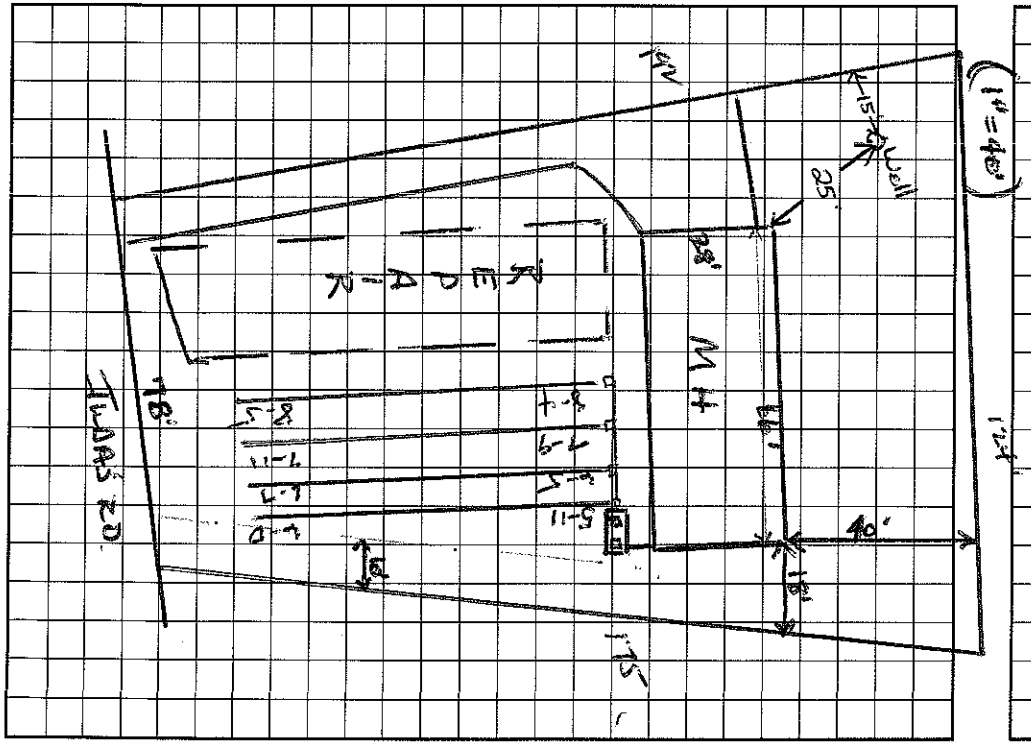

AS BUILT SKETCH

I understand that this permit can be suspended or revoked if any false information is supplied toward securing the permit/any unauthorized changes are made to the site/any unauthorized changes are made in the installation of the system. Improvement Permit with plat valid without expiration. Improvement Permit with site plan valid for sixty months. Authorization to Construct is valid for a period equal to that of Improvement Permit – not to exceed sixty months.

Signed: X Julian Burke date

Improvement Permit by: J Wesley Sparks RS. date 9/16/98

Authorization to Construct by: Wesley Sparks RS. date 9/16/98

Installed by: A-1

Operation Permit by: Wesley Sparks RS. date 9/29/98

Existing System Inspection by: date

HEALTH DEPT. COPY: WHITE INSPECTION COPY (FINAL): GREEN OWNER COPY (FINAL): YELLOW INSPECTION COPY (INITIAL): PINK OWNER COPY (INITIAL): GOLD