2 3c

IREDELL COUNTY HEALTH DEPARTMENT

STATESVILLE 704-878-5305 MOORESVILLE 704-664-5281

IMPROVEMENT PERMIT / AUTHORIZATION TO CONSTRUCT / OPERATION PERMIT / EXISTING SYSTEM INSPECTION

PERMIT# 075 984 PIN# 4648393508 PT DATE 9/25/98

OWNER OR CONTRACTOR Robert Lynch 5608 PHONE: Business 528-9449 Home Freedom Home

ADDRESS 1018 Charlotte Hwy Troutman, NC 28166

LOCATION Hwy 21 N TL Conelius TR Judas Rd 1/2 mile on left

SUBDIVISION Shade BLOCK / SECTION 1 LOT 1 LOT AREA 23,064 SITE CLASS PS DESIGN FLOW 360gpd L.T.A.R. .3

Septic Tank: 1000 Gallons; STB 1012 Date 7/3/98
Pump Tank: ____ Gallons; PT ____ Date ____
Pump Make: ____ Model ____ Serial No. ____
Nitrification Field: No Fields 1 Square Feet 900' Linear Feet 300'
No Lines 4 at 75' Trench Width 36" Max Trench Bottom Depth 36" Gravel Depth N/A

☒ New System ☐ Repair System Type: I, II, III, IV, V, VI
System Description: Gravity - 25% Reduction
Repair System Description: Pump / Gravity - Modified
Maintenance Agreement Required: ☐ Yes ☐ No


☐ House/Mod. Home ☒ Mobile Home ☐ Business ☐ Other
No. Bedrooms 3 No. Bathrooms 2 No. Employees ____
☐ Slab ☒ Crawl Space ☐ Basement w/plumbing ☐ Basement wo/plumbing

Water Supply: ☒ Individual ☐ Public ☐ Community

Comments:/Conditions: Keep Septic System at least 10' from PL, 5' from House & at least 50' from well.
★ Divert Stormwater/Surfacewater around Drainfield - Septic Area

Comments:/Conditions:

INITIAL SITE SKETCH Scale 1:50

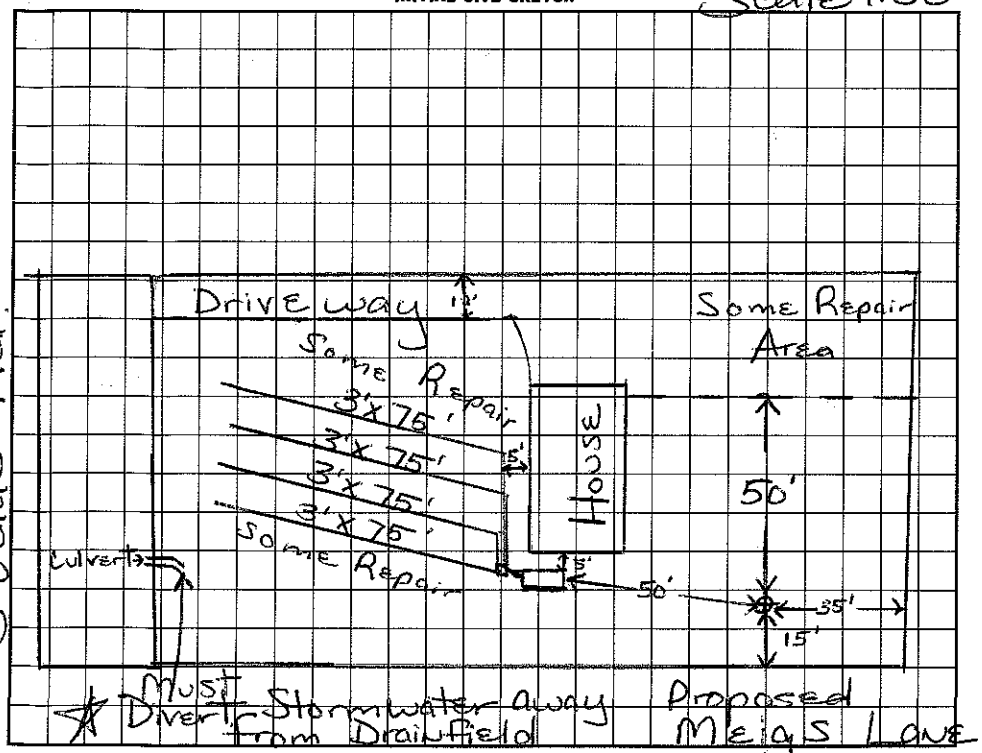

AS BUILT SKETCH

I understand that this permit can be suspended or revoked if any false information is supplied toward securing the permit/any unauthorized changes are made to the site/any unauthorized changes are made in the installation of the system. Improvement Permit with plat valid without expiration. Improvement Permit with site plan valid for sixty months. Authorization to Construct is valid for a period equal to that of Improvement Permit – not to exceed sixty months.

Signed: Robert Lynch date 9/25/98 Installed by: A+1 Backhoe

Improvement Permit by: Maina H. Dotson R.S. date 9/25/98 Operation Permit by: Wesley Sparkman date 9/28/98

Authorization to Construct by: Maina H. Dotson R.S. date 9/25/98 Existing System Inspection by: ____ date ____

HEALTH DEPT. COPY: WHITE INSPECTION COPY (FINAL): GREEN OWNER COPY (FINAL): YELLOW INSPECTION COPY (INITIAL): PINK OWNER COPY (INITIAL): GOLD