IREDELL COUNTY HEALTH DEPARTMENT

STATESVILLE 704-878-5305 MOORESVILLE 704-664-5281

4648396978

IMPROVEMENT PERMIT / AUTHORIZATION TO CONSTRUCT / OPERATION PERMIT / EXISTING SYSTEM INSPECTION

PERMIT# 22027 PIN# 2564 DATE 12/23/97

OWNER OR CONTRACTOR Rufus Love PHONE: Business 892-4249 Home

ADDRESS PO Box 11 Davidson, NC. 28036

LOCATION Judas Rd, Cornelius Rd. TR Judas Rd. on (R) Appt 2ND driveway

SUBDIVISION SHADE BLOCK / SECTION 1 LOT 4 LOT AREA .92 AC SITE CLASS PS DESIGN FLOW 480 L.T.A.R. .3

Septic Tank: 1000 Gallons; STB 1012 Date 5/19/98

Pump Tank: Gallons; PT Date

Pump Make: Model Serial No.

Nitrification Field: No Fields 1 Square Feet 1200 Linear Feet 400*

No Lines 5 Trench Width 36" Max Trench Bottom Depth 30"

[X] New System [ ] Repair System Type: I, II, (III), IV, V, VI

System Description: GRAVITY - CH PLASTIC

Repair System Description: SAME

Maintenance Agreement Required: [ ] Yes [X] No

Gravel Depth SAND

[X] House/Mod. Home [ ] Mobile Home [ ] Business [ ] Other

No. Bedrooms 4 No. Bathrooms 3 No. Employees


[ ] Slab [X] Crawl Space [ ] Basement w/plumbing [ ] Basement wo/plumbing

Water Supply: [X] Individual [ ] Public [ ] Community


Comments:/Conditions: * 25% Reduction in Linear footage

Comments:/Conditions:

INITIAL SITE SKETCH

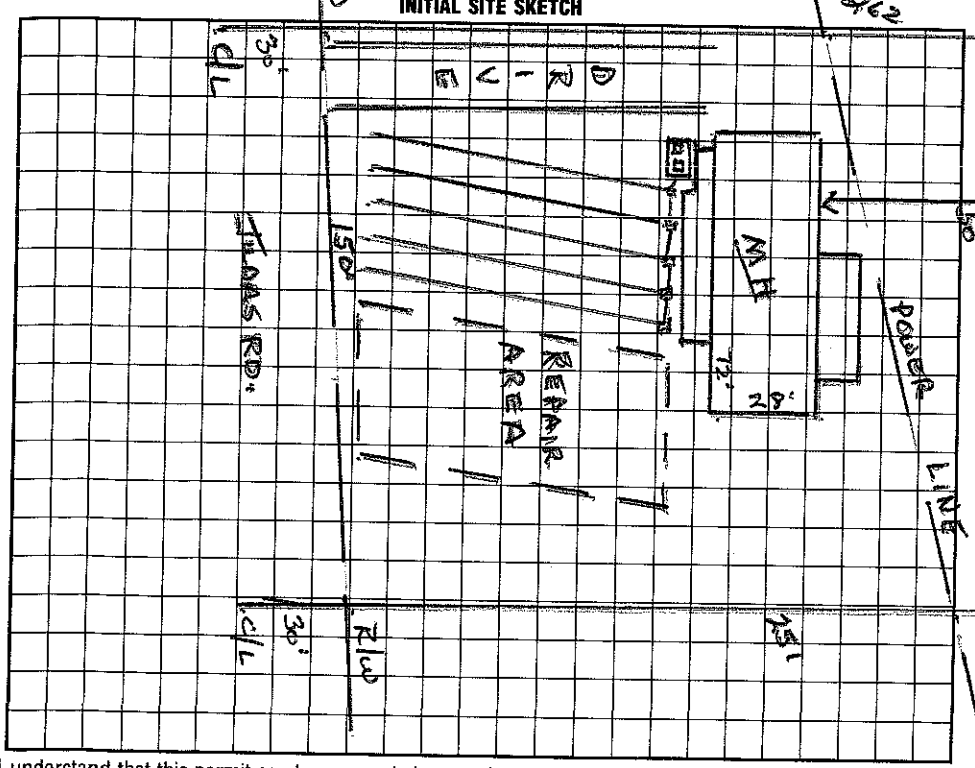

AS BUILT SKETCH

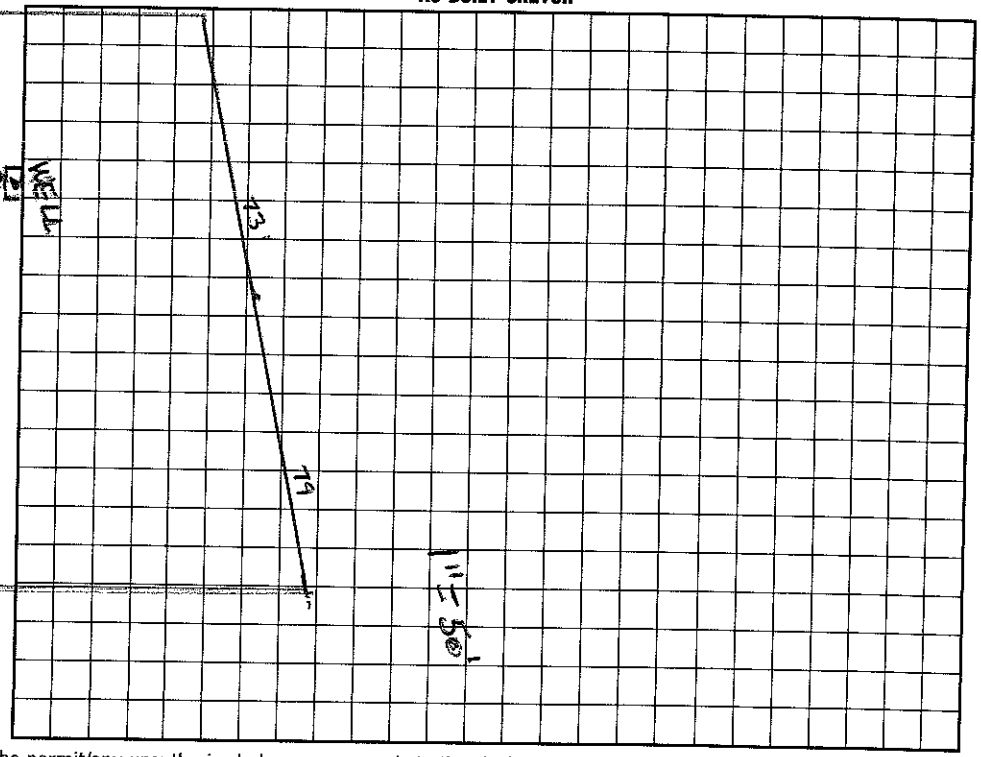

I understand that this permit can be suspended or revoked if any false information is supplied toward securing the permit/any unauthorized changes are made to the site/any unauthorized changes are made in the installation of the system. Improvement Permit with plat valid without expiration. Improvement Permit with site plan valid for sixty months. Authorization to Construct is valid for a period equal to that of Improvement Permit – not to exceed sixty months.

Signed: * Pamela O Douglas date 1/6/98

Improvement Permit by: Wesley Sparks RS. date 12/23/97

Authorization to Construct by: Wesley Sparks RS. date 12/23/97

Installed by: A-1 BACKHOE

Operation Permit by: C. [signature] date 7/16/98

Existing System Inspection by: date

HEALTH DEPT. COPY: WHITE INSPECTION COPY (FINAL): GREEN OWNER COPY (FINAL): YELLOW INSPECTION COPY (INITIAL): PINK OWNER COPY (INITIAL): GOLD