IREDELL COUNTY HEALTH DEPARTMENT

Authorization to Construct 4648398703

STATESVILLE 704-878-5305 MOORESVILLE 704-664-5281

IMPROVEMENT PERMIT / ~~CERTIFICATE OF COMPLETION~~ / OPERATION PERMIT / EXISTING SYSTEM INSPECTION

PROPERTY DESCRIPTION NO. 24256 DATE 8/1/96 TAX MAP NO. 2564 2 Watershed: ☒ Yes ☐ No

OWNER OR CONTRACTOR Shirley Knowlton PHONE: Business _____ Home _____

ADDRESS 125 Magnolia Ave Floral PK, NC

LOCATION Judson Rd., lot on (L) of first D/W on (R)

SUBDIVISION Shade BLOCK / SECTION 1 LOT 2 LOT AREA 1.0 AC SITE CLASS PS DESIGN FLOW 360 L.T.A.R. .3

Septic Tank: 1000 Gallons; STB _____ Date _____

Pump Tank: _____ Gallons; PT _____ Date _____

Pump Make: _____ Model _____ Serial No. _____

Nitrification Field: No Fields 1 Square Feet 1200 Linear Feet 400

No Lines 4 Trench Width 36" Max Trench Bottom Depth 36" Gravel Depth 12"

☒ New System ☐ Repair System Type: I (II) III. IV. V. VI

System Description: Gravel Conv.

Repair System Description: Gravel Conv.

Maintenance Agreement Required: ☐ Yes ☒ No

☒ House/Mod. Home No. Bedrooms 3

☐ Mobile Home No. Bathrooms 2

☐ Business No. Employees _____

☐ Other _____


☐ Slab ☒ Crawl Space ☐ Basement w/plumbing ☐ Basement wo/plumbing

Water Supply: ☒ Individual ☐ Community ☐ Public


Comments: Trailer location shifted back to 120' from road R/W.

Comments:

INITIAL SITE SKETCH

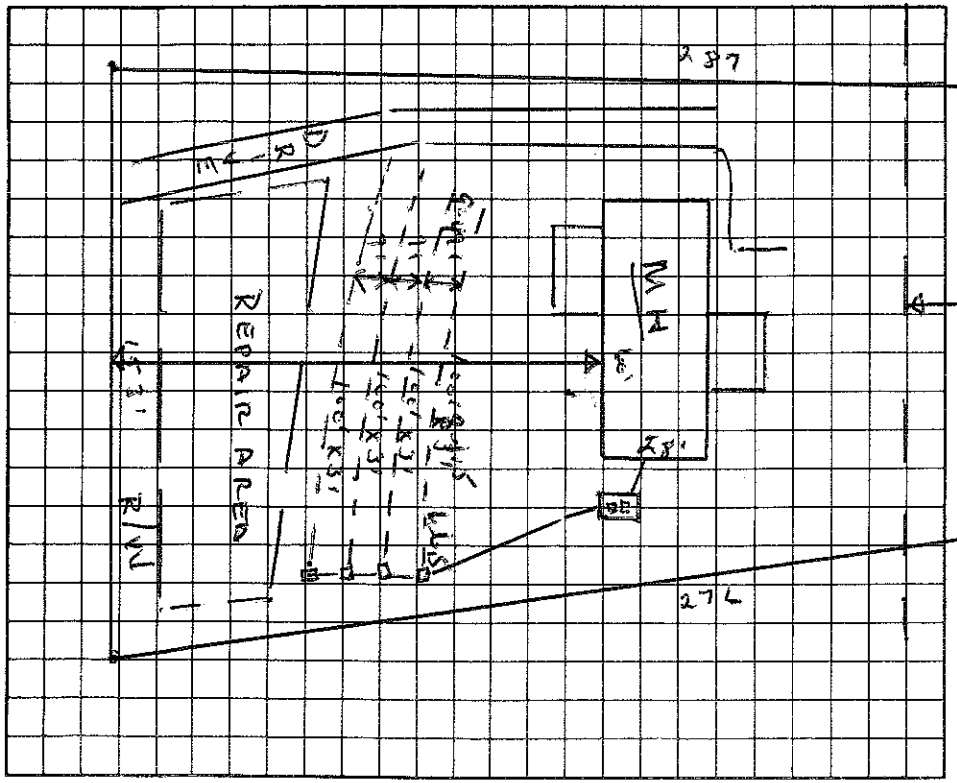

AS BUILT SKETCH

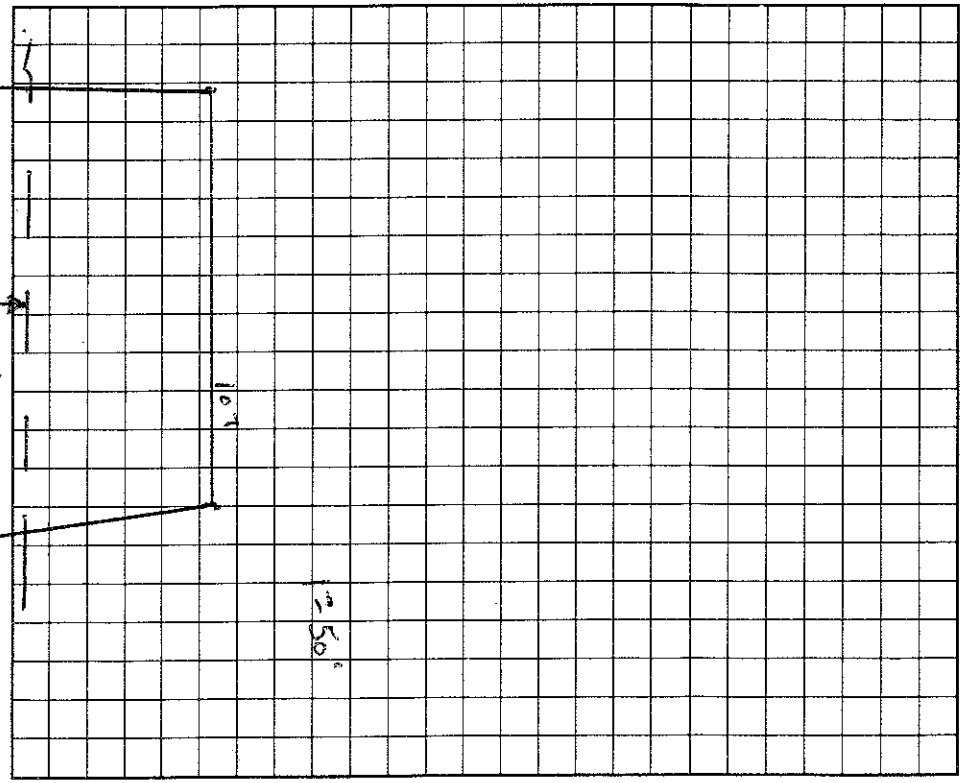

I understand that this permit can be suspended or revoked if any false information is supplied toward securing the permit/any unauthorized changes are made to the site/any unauthorized changes are made in the installation of the system.

Authorization to Construct valid 12 months.

Signed: ~~Shirley J. Knowlton~~ by Carey Knowlton attorney-in-fact Installed by: Chip Bridges

Improvement Permit by: Wesley Sparks R.S. date 8/1/96 Certificate of Completion by: _____ date _____

Authorization to Construct Existing System Inspection by: Wesley Sparks R.S. date 8/1/96 Operation Permit by: Wesley Sparks R.S. date 8/16/96

HEALTH DEPT. COPY: WHITE INSPECTION COPY (FINAL): GREEN OWNER COPY (FINAL): YELLOW INSPECTION COPY (INITIAL): PINK OWNER COPY (INITIAL): GOLD