(522-1948)

IREDELL COUNTY HEALTH DEPARTMENT

STATESVILLE 704-878-5305 MOORESVILLE 704-664-5281

IMPROVEMENT PERMIT / AUTHORIZATION TO CONSTRUCT / OPERATION PERMIT / EXISTING SYSTEM INSPECTION

PERMIT# No PIN# 4648 39 8703 DATE 3/15/01

OWNER OR CONTRACTOR Jerry + Tina Wright PHONE: Business Home 660-7749

ADDRESS 335 Judas Rd. Mooresville, NC. 28117

LOCATION 21N to Connelly Rd. TR Judas Rd. to 2nd trailer on (R)

SUBDIVISION SHADE BLOCK / SECTION 1 LOT 2 LOT AREA ~1.0 AC SITE CLASS. PS DESIGN FLOW 360 L.T.A.R. .3

Septic Tank: EXISTING Gallons; STB Date

Pump Tank: Gallons; PT 107 Date

Pump Make: Model Serial No.

Nitrification Field: No Fields 1 Square Feet 900 Linear Feet 300

No Lines 3 Trench Width 9' Max Trench Bottom Depth 3' Gravel Depth No

☐ New System ☒ Repair System Type: I, II, (III), IV, V, VI

System Description:

Repair System Description: CH PLASTIC OR EZ FLOW

Maintenance Agreement Required: ☐ Yes ☒ No

☒ House/Mod. Home No. Bedrooms 3

☐ Mobile Home No. Bathrooms 2

☐ Business No. Employees

☐ Other


☐ Slab ☒ Crawl Space ☐ Basement w/plumbing ☐ Basement wo/plumbing

Water Supply: ☒ Individual ☐ Public ☐ Community


Comments/Conditions:

Comments/Conditions: (14 x 75') Bed with Ch. Plastic

INITIAL SITE

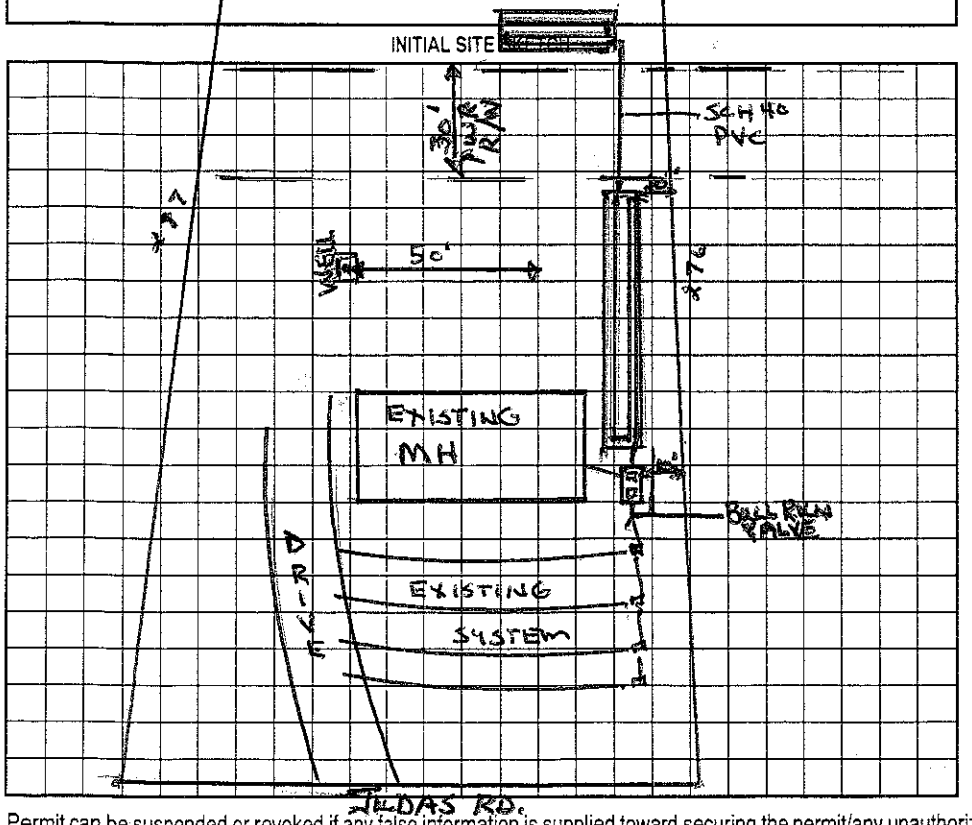

AS BUILT SKETCH

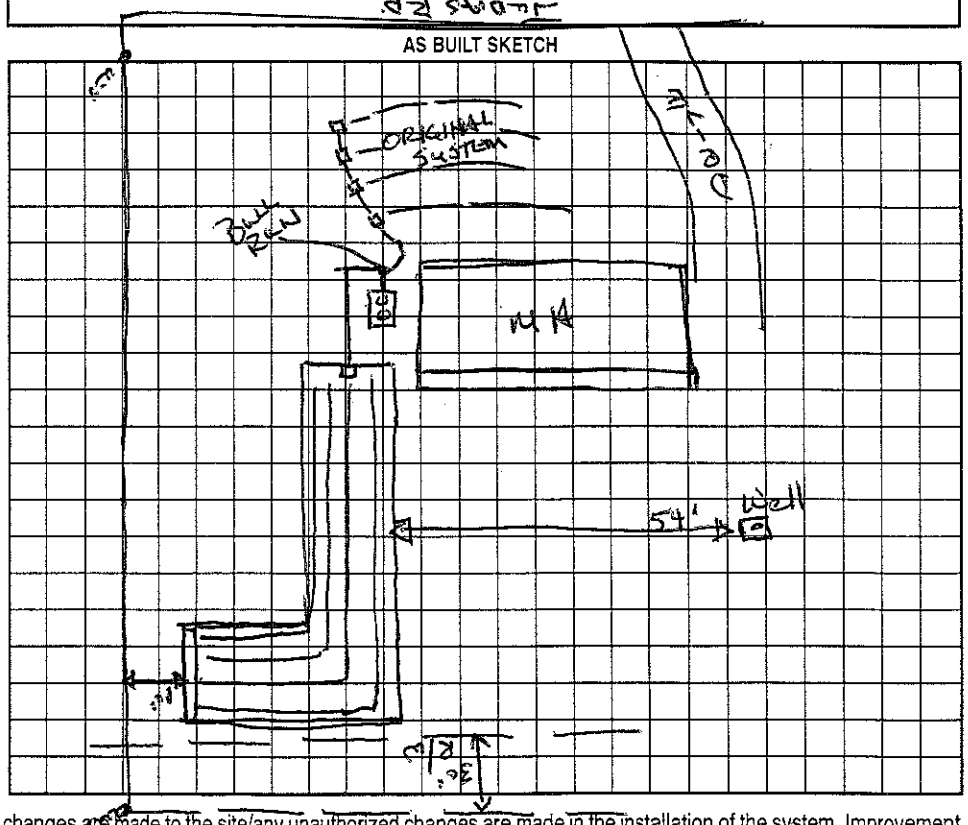

Permit can be suspended or revoked if any false information is supplied toward securing the permit/any unauthorized changes are made to the site/any unauthorized changes are made in the installation of the system. Improvement Permit with plat valid without expiration. Improvement Permit with site plan valid for sixty months. Authorization to Construct is valid for a period equal to that of Improvement Permit – not to exceed sixty months.

Signed: X date

Improvement Permit by: Wesley Sparks RS. date 3/15/01

Authorization to Construct by: Wesley Sparks RS date 3/15/01

Installed by: Richard Abernathy

Operation Permit by: Wesley Sparks RS. date 4/6/01

Existing System Inspection by: date

HEALTH DEPT. COPY: WHITE OWNER COPY (FINAL): YELLOW OWNER COPY (INITIAL): PINK