IREDELL COUNTY HEALTH DEPARTMENT

Statesville Office (704) 878-5305 Mooresville Office (704) 660-3625

PERMIT # 3:30 11851

IMPROVEMENT PERMIT / AUTHORIZATION TO CONSTRUCT / OPERATION PERMIT / EXISTING SYSTEM

PIN # 4648328497

APPLICANT: Chad Goodin / IQ Custom Homes APPLICANT ADDRESS: 915 River Hwy Ste A Mooresville, NC 28117

SITE ADDRESS: 135 Cedar Woods Dr. Mooresville, NC PHONE: ALT. PHONE:

SITE DIRECTIONS: Hwy 150 W. TR Bluefield TR Big Indian Loop TL Cedar Woods at end on left


SUBDIVISION: Cedar Woods SECTION: LOT# 6 LOT AREA: 1.60 Ac. DESIGN FLOW: 480 gpd L.T.A.R.: ~.3

Septic Tank 1000 (gal)	STB 825	Date 8-15-14	☒ New System ☐ Repair ☐ Expansion	System Type: I II III IV V VI	☒ Residence	No. Bedrooms 4	Water Supply
Pump Tank (gal)	PT	Date	System Description: Gravity PPBPS		☐ Business	No. Persons	☒ Private
Pump Make	Model	Serial #	Repair System Description: Grav/Pump PPBPS		☐ Other	No. Employees	☐ Public
# Nitrification Fields 1	# Lines 6	Linear Ft: 270	Maintenance Agreement Required: ☐ YES	☒ NO	☐ Slab	☒ Crawl Space	☐ Community
Trench Width min 24"	Max. Trench Bottom Depth 29"-30"	Gravel Depth N/A	☒ GRAVITY	☐ PRESSURE	☐ Basement w/ plumbing	☐ Basement w/o plumbing	

Comments / Conditions: Note: Start drainlines 10ft off back Property line
*Stub out plumbing high.
Scale 1:50

*Any future pool must be at least 15ft off Septic System.

INITIAL SITE SKETCH

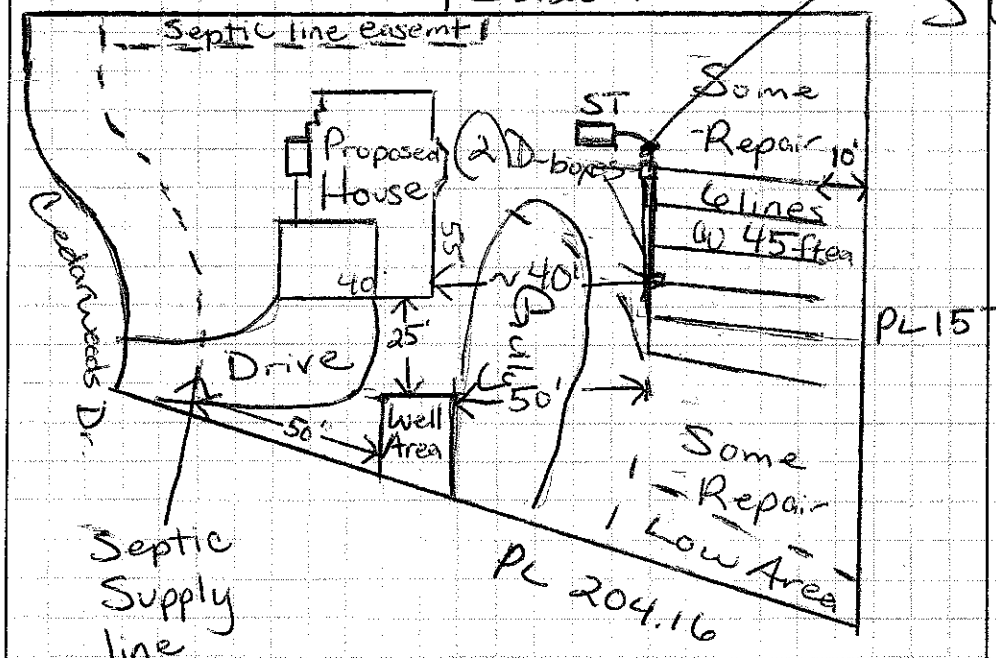

AS BUILT SKETCH

Scale 1:50

Installed as Drawn

Permit can be suspended or revoked if any false information is supplied toward securing the permit / any unauthorized changes are made to the site / any unauthorized changes are made in the installation of the system. **CONTACT A LOCATOR SERVICE PRIOR TO ANY EXCAVATION**

☐ **IMPROVEMENT PERMIT** *with plat valid without expiration.* ☐ **IMPROVEMENT PERMIT** *with site plan valid for 60 mos.* ☐ **AUTHORIZATION TO CONSTRUCT** *valid for period equal to IMPROVEMENT PERMIT--not to exceed 60 mo.*

Owner / Applicant Signature: Fred Roney Date: 2/15/13 Installed by: Rowan Septic RS

IMPROVEMENT PERMIT by: Marie H. Dotson RS Date: 2/13/13 OPERATION PERMIT by: Marie H. Dotson Date: 10/1/14

AUTHORIZATION TO CONSTRUCT by: Date: 2/7/14 Existing System Inspected by: Date:

Health Dept. Copy - WHITE Applicant (Final Approval) - YELLOW Applicant (Conditional Approval) - PINK