ELL COUNTY HEALTH DEPARTMENT

STATESVILLE 704-878-5305 375.00 Paid MOORESVILLE 704-664-5231 1100

ROVEMENT PERMIT / AUTHORIZATION TO CONSTRUCT / OPERATION PERMIT / EXISTING SYSTEM INSPECTION

Permit # 116513 PIN# 4648-32-8497.8 DATE March 3, 2004

OWNER OR CONTRACTOR Bredell Three LLC // Peter Denicola PHONE: Business Pete Denicola Home 235-8480

ADDRESS 6000 Old Pineville Rd., Charlotte, N.C. 28217

LOCATION 150 West TR Bluefield Rd. TL Big Indian Loop TL Cedar Woods DR at end

SUBDIVISION Cedar Woods BLOCK / SECTION _____ LOT 8 LOT AREA 1.33ac SITE CLASS. PS DESIGN FLOW 480gpd L.T.A.R. .25

Septic Tank: 1000 Gallons; STB 394 Date 6-30-04
Pump Tank: 1000 Gallons; PT 283 Date 4-21-04
Pump Make: Goulds Model PE5IM Serial No. _____
Nitrification Field: No Fields 1 Square Feet 640/960 Linear Feet 320
No Lines 4-5 Trench Width 24" MIN 36" Max Trench Bottom Depth 36"

☐ New System ☐ Repair System Type: I, II, III, IV, V, VI
System Description: LPP PPBS
Repair System Description: LPP
Maintenance Agreement Required: ☑ Yes ☐ No
Gravel Depth N/A


☑ House/Mod. Home No. Bedrooms 4
☐ Mobile Home No. Bathrooms 4
☐ Business No. Employees _____
☐ Other _____
☐ Slab ☑ Crawl Space ☐ Basement w/plumbing ☐ Basement wo/plumbing

Water Supply: ☑ Individual ☐ Public ☐ Community


Comments:/Conditions: @ 36" MAX 9'cc
House Site will Require use of fill soil in qualified AREAS.
12-1-06 Client to locate front of house approx 110' closer than shown on ISSketch. Driveway OK to be on right side. Tanks may need lift for adjustment on location.

Comments:/Conditions: 8/8/07 Tanks, lines & pressure Checked
265.36' 11/7/07 Electric Alarm Checked
Note: Tanks location Changed, Approved by owner 6/5/08 Set pressure 3' on upper 2 lines
2' on lower 2 lines

1"=50' INITIAL SITE SKETCH

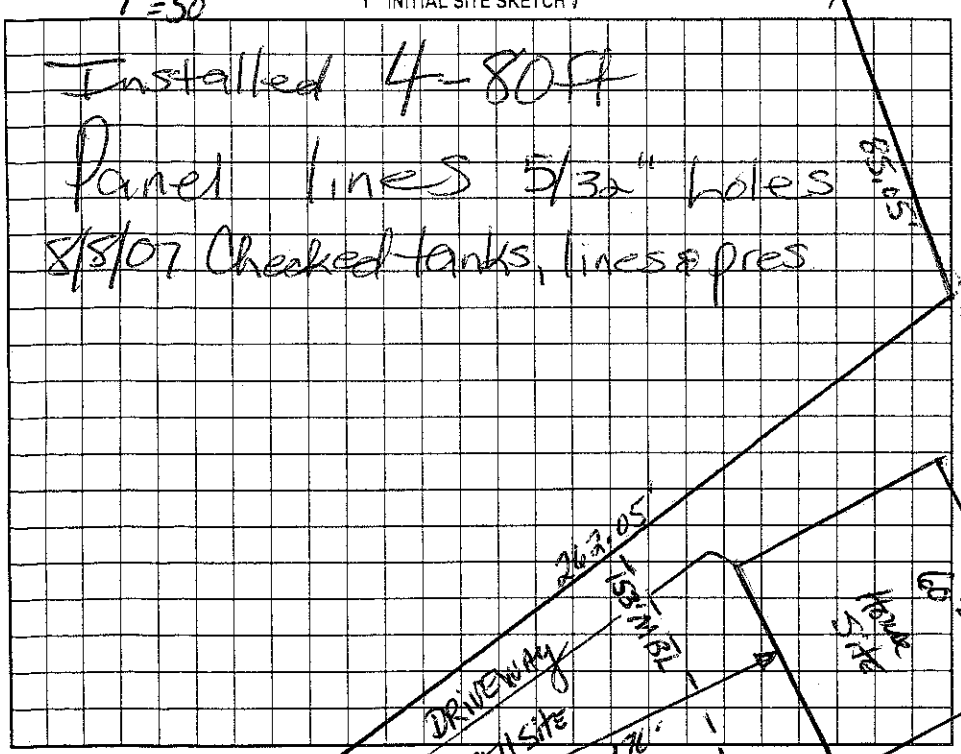

AS BUILT SKETCH

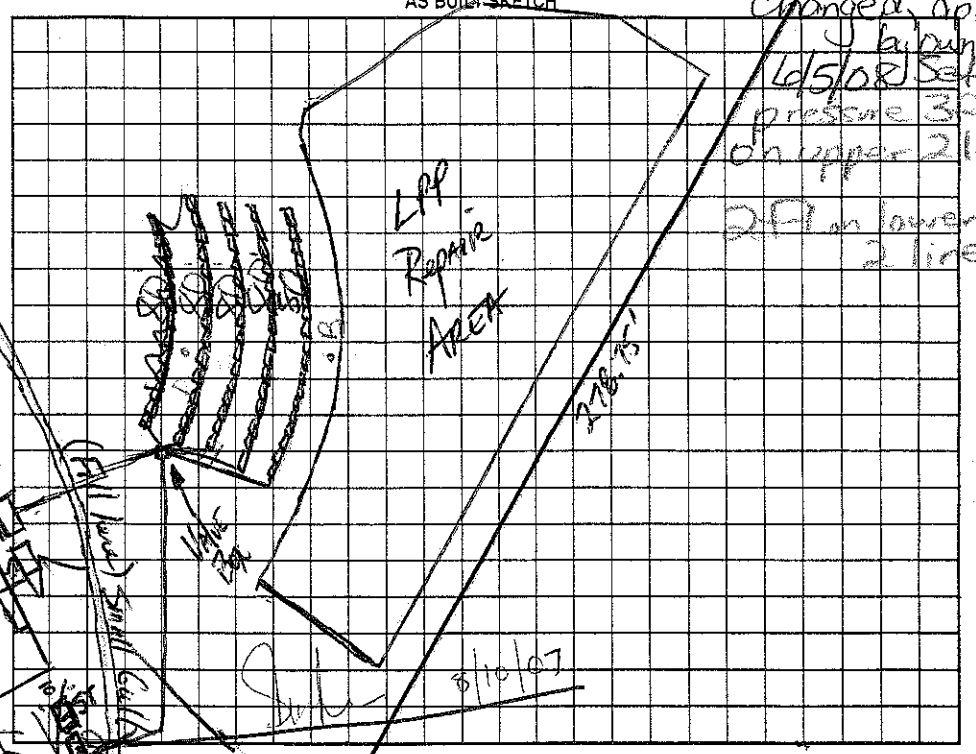

Permit can be suspended or revoked if any false information is supplied toward securing the permit/any unauthorized changes are made to the site/any unauthorized changes are made in the installation of the system. Improvement Permit with plat valid without expiration. Improvement Permit with site plan valid for sixty months. Authorization to Construct is valid for a period equal to that of Improvement Permit - not to exceed sixty months.

Signed: Paul J. Allen date 4-21-04 Installed by: Richard Abernathy

Improvement Permit by: DR Hinson, RS date 3-3-04 Operation Permit by: Marie Hall Dotson, RS date 11/8/07

Authorization to Construct by: DR Hinson, RS date 12-1-06 Existing System Inspection by: _____ date _____

HEALTH DEPT. COPY: WHITE OWNER COPY (FINAL): YELLOW OWNER COPY (INITIAL): PINK