IREDELL COUNTY HEALTH DEPARTMENT

Authorization To Construct

STATESVILLE 704-878-5305 MOORESVILLE 704-664-5281 558-5944

IMPROVEMENT PERMIT / ~~CERTIFICATE OF COMPLETION~~ / OPERATION PERMIT / EXISTING SYSTEM INSPECTION

PROPERTY DESCRIPTION NO. 066784 DATE 6/5/97 TAX MAP NO. 4648443886 Watershed: X Yes ☐ No

OWNER OR CONTRACTOR Wm C Brown PHONE: Business _____ Home _____

ADDRESS 5707 Nevin Rd. Charlotte, NC. 28269

LOCATION Big Indian Loop - Bluefield Rd, TL Big Indian Loop, on (L) before sharp curve

SUBDIVISION Indian Hill BLOCK / SECTION 2 LOT 22 LOT AREA 1.16 SITE CLASS. PS DESIGN FLOW 360 L.T.A.R. .3

Septic Tank: 1000 Gallons; STB 794 Date 9/11/97
Pump Tank: _____ Gallons; PT _____ Date _____
Pump Make: _____ Model _____ Serial No. _____
Nitrification Field: No Fields 1 Square Feet 1200 Linear Feet 400
No Lines 5 Trench Width 36" Max Trench Bottom Depth 36" Gravel Depth 12"

X New System ☐ Repair System Type: I, II, III, IV, V, VI
System Description: GRAV - CONVENTIONAL
Repair System Description: CH. PLASTIC
Maintenance Agreement Required: ☐ Yes X No


X House/Mod. Home No. Bedrooms 3
☐ Mobile Home No. Bathrooms 3.5
☐ Business No. Employees _____
☐ Other _____
☐ Slab X Crawl Space ☐ Basement w/plumbing ☐ Basement wo/plumbing

Water Supply:
X Individual
☐ Community
☐ Public


Comments:

Comments:

INITIAL SITE SKETCH

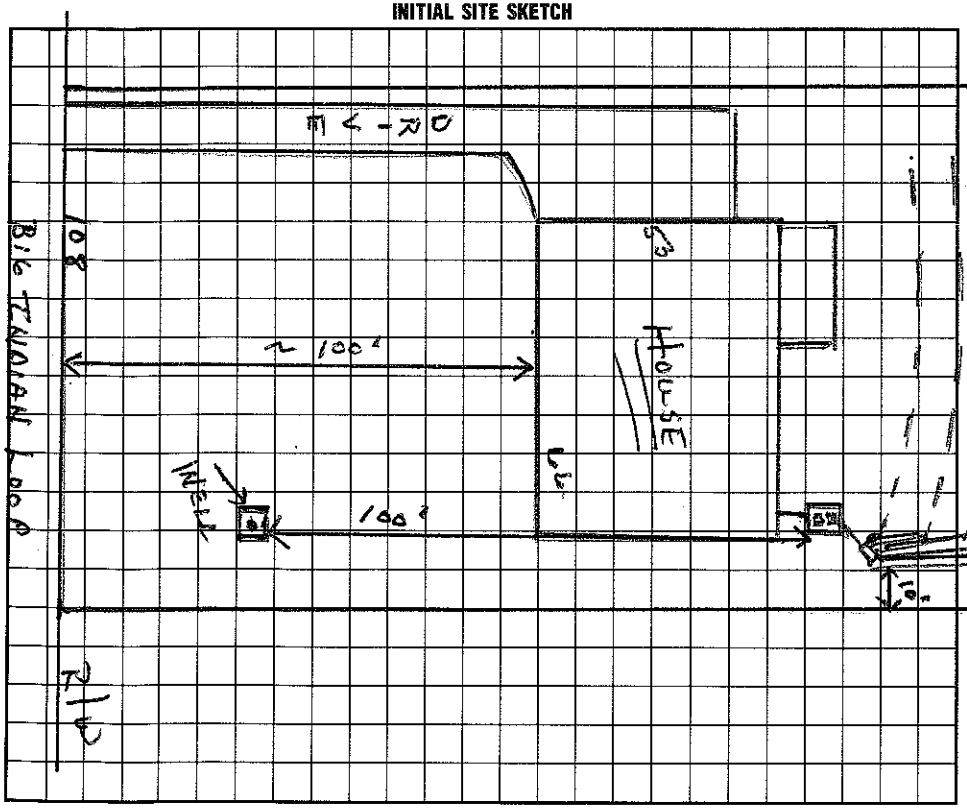

AS BUILT SKETCH

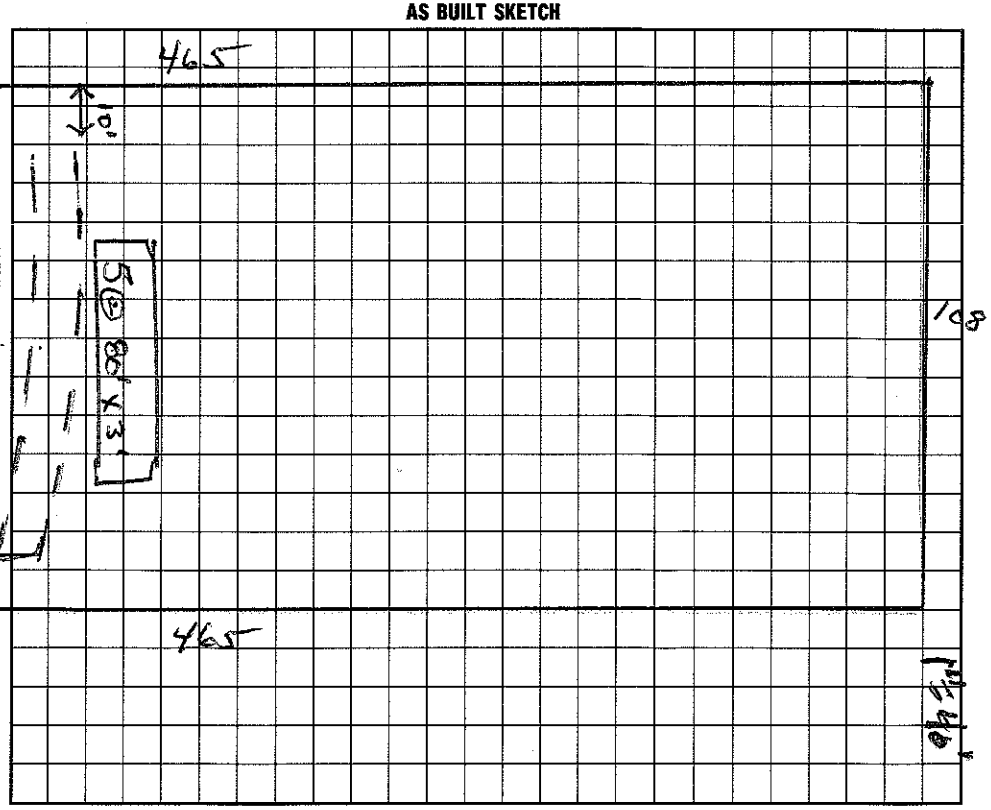

I understand that this permit can be suspended or revoked if any false information is supplied toward securing the permit/any unauthorized changes are made to the site/any unauthorized changes are made in the installation of the system. Improvement Permit is valid for 60 months from date of issuance.

Signed: _____

Improvement Permit by: Wesley Sparks RS. date 6/5/97

Existing System Inspection by: Wesley Sparks RS. date 6/5/97

Installed by: MAYHEW

Certificate of Completion by: _____ date _____

Operation Permit by: C. Brady Thomas date 11/12/97

HEALTH DEPT. COPY: WHITE INSPECTION COPY (FINAL): GREEN OWNER COPY (FINAL): YELLOW INSPECTION COPY (INITIAL): PINK OWNER COPY (INITIAL): GOLD