IREDELL COUNTY HEALTH DEPARTMENT

→ AUTHORIZATION TO CONSTRUCT

STATESVILLE 704-878-5305 MOORESVILLE 704-664-5281

IMPROVEMENT PERMIT / ~~CERTIFICATE OF COMPLETION~~ / OPERATION PERMIT / EXISTING SYSTEM INSPECTION

PROPERTY DESCRIPTION NO. 065 706 DATE 4/11/97 TAX MAP NO. 464 8443915 Watershed: ☐ Yes ☐ No

OWNER OR CONTRACTOR STEVEN BAKER PHONE: Business Home

ADDRESS PO BOX 6067

LOCATION BLUEFIELD RD - TL BIG INDIAN LOOP - TR AGAIN BIG INDIAN - LOT ON LT.

SUBDIVISION INDIAN HILLS BLOCK / SECTION 2 LOT 21 LOT AREA 1.12 AC SITE CLASS. PS DESIGN FLOW 360 GPD L.T.A.R. .36 GPD/FT

Septic Tank: 1000 Gallons; STB 794 Date 9/2/97

Pump Tank: Gallons; PT Date

Pump Make: Model Serial No.

Nitrification Field: No Fields 1 Square Feet 900 Linear Feet 300

No Lines 5 @ 60' Trench Width 36" Max Trench Bottom Depth 24" Gravel Depth N/A

☑ New System ☐ Repair System Type: I, II, (III) IV, V, VI

System Description: GRAVITY CHAMBERED

Repair System Description: SAME

Maintenance Agreement Required: ☐ Yes ☑ No

☑ House/Mod. Home No. Bedrooms 3

☐ Mobile Home No. Bathrooms 2

☐ Business No. Employees

☐ Other


☐ Slab ☑ Crawl Space ☐ Basement w/plumbing ☐ Basement wo/plumbing

Water Supply: ☑ Individual ☐ Community ☐ Public


Comments:

Comments:

INITIAL SITE SKETCH

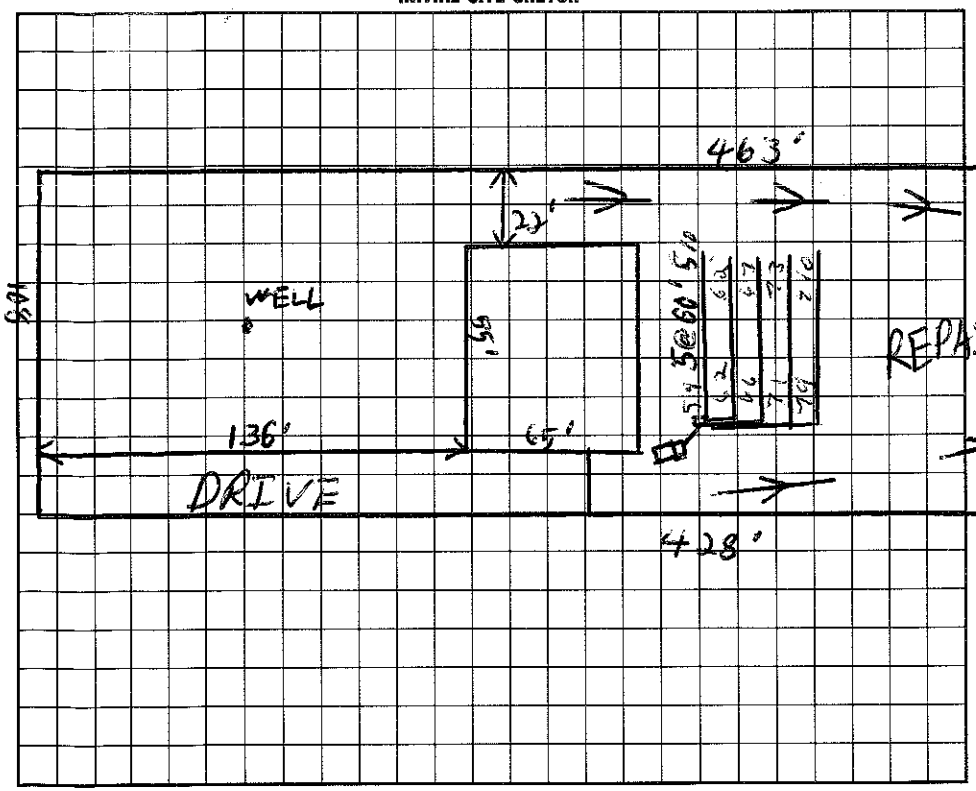

AS BUILT SKETCH

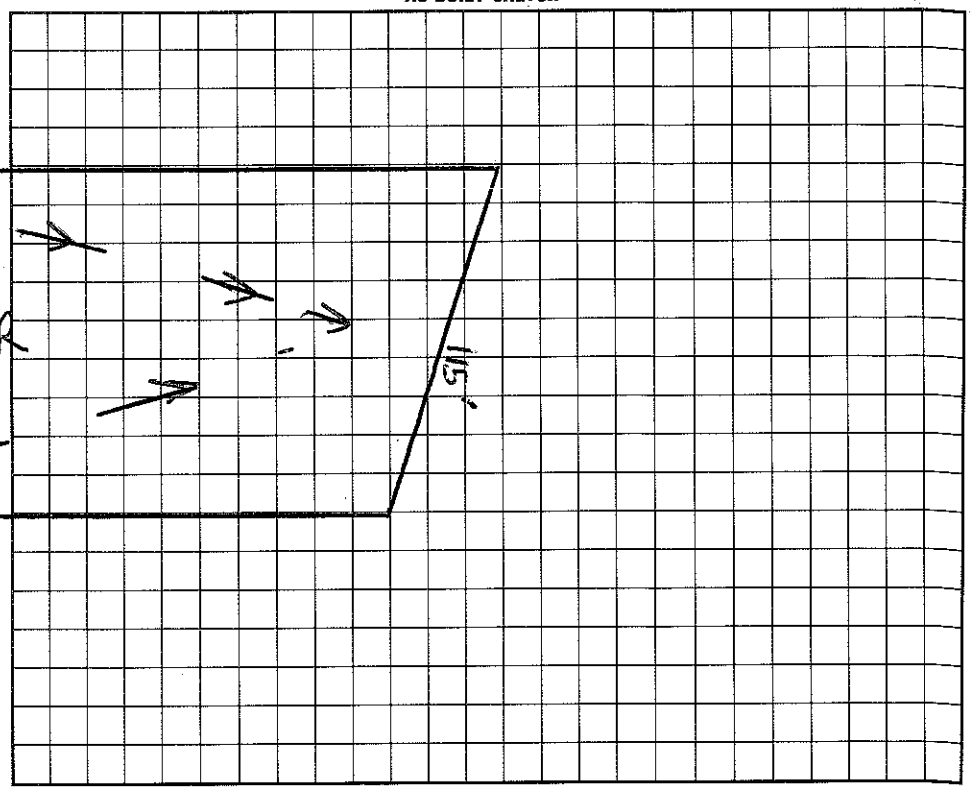

BIG INDIAN Loop

I understand that this permit can be suspended or revoked if any false information is supplied toward securing the permit/any unauthorized changes are made to the site/any unauthorized changes are made in the installation of the system. Improvement Permit is valid for 60 months from date of issuance.

Signed: Steven Todd Baker

Installed by: CURT DUNNING

Improvement Permit by: C. Ray Freeman date 4/11/97

Certificate of Completion by: date

AUTHORIZATION TO CONSTRUCT Existing System Inspection by: C. Ray Freeman date 4/11/97

Operation Permit by: C. Ray Freeman date 11/12/97

HEALTH DEPT. COPY: WHITE INSPECTION COPY (FINAL): GREEN OWNER COPY (FINAL): YELLOW INSPECTION COPY (INITIAL): PINK OWNER COPY (INITIAL): GOLD