IREDELL COUNTY HEALTH DEPARTMENT

STATESVILLE 704-878-5305 MOORESVILLE 704-664-5281

IMPROVEMENT PERMIT / AUTHORIZATION TO CONSTRUCT / OPERATION PERMIT / EXISTING SYSTEM INSPECTION

PERMIT# 073494 PIN# 4648 44 5505 DATE 5/27/98

OWNER OR CONTRACTOR Joel J Kendrick PHONE: Business 875-0680 Home

ADDRESS C/O PO Box 682 Huntersville, NC. 28078

LOCATION 840 Big Indian Loop, TR 1st Big Indian on (L) before sharp curve

SUBDIVISION BLOCK / SECTION LOT 25+26 LOT AREA 1.16 Ac SITE CLASS. PS DESIGN FLOW 360 L.T.A.R. .3

Septic Tank: 1000 Gallons; STB 794 Date 12/5/97
Pump Tank: Gallons; PT Date
Pump Make: Model Serial No.
Nitrification Field: No Fields 1 Square Feet 1440 Linear Feet 480
No Lines 6 Trench Width 36" Max Trench Bottom Depth 36" Gravel Depth

[X] New System [ ] Repair System Type: I, II, (III) IV, V, VI
System Description: GRAVITY - CH PLASTIC
Repair System Description: SAME
Maintenance Agreement Required: [ ] Yes [X] No


[X] House/Mod. Home No. Bedrooms 3
[ ] Mobile Home No. Bathrooms 3
[ ] Business No. Employees
[ ] Other
[ ] Slab [X] Crawl Space [ ] Basement w/plumbing [ ] Basement wo/plumbing

Water Supply: [X] Individual [ ] Public [ ] Community


Comments:/Conditions:

Comments:/Conditions:

INITIAL SITE SKETCH

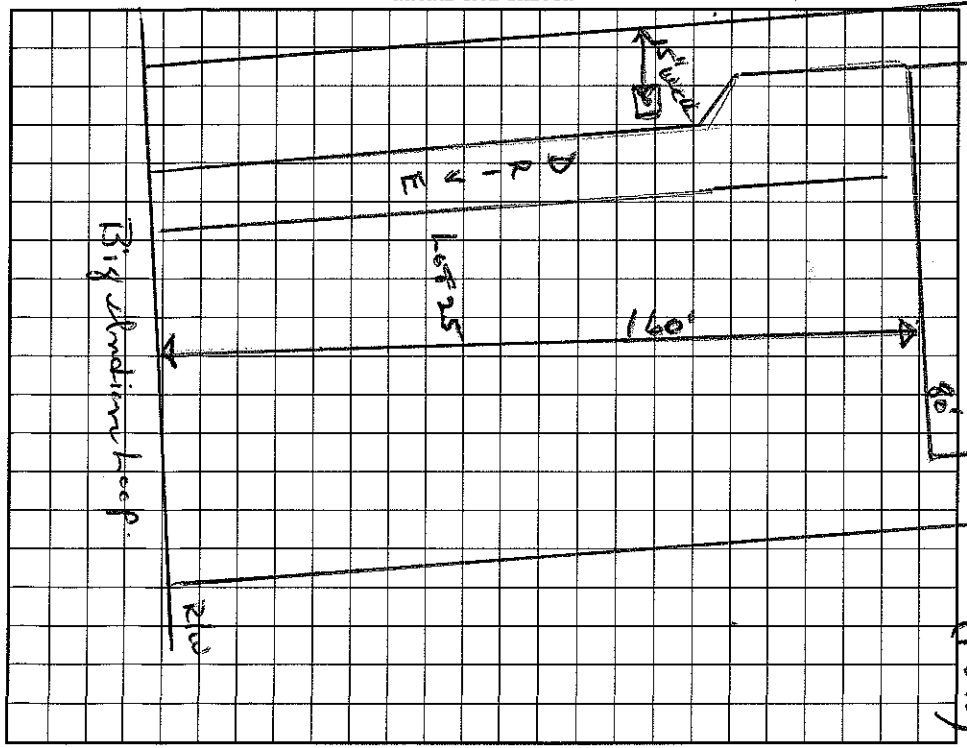

AS BUILT SKETCH

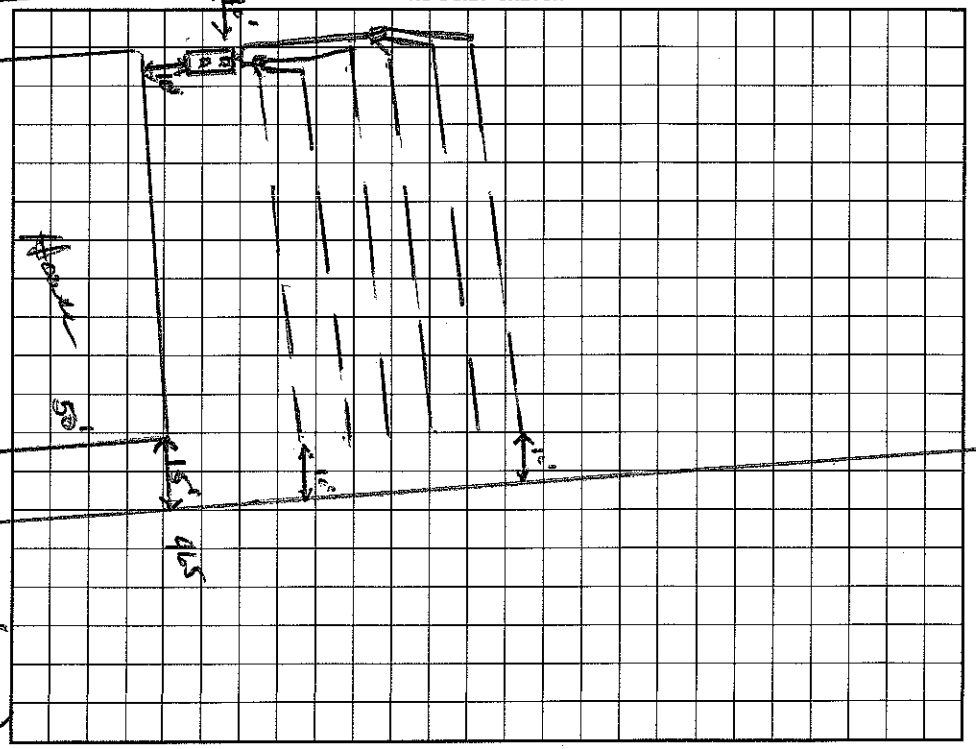

I understand that this permit can be suspended or revoked if any false information is supplied toward securing the permit/any unauthorized changes are made to the site/any unauthorized changes are made in the installation of the system. Improvement Permit with plat valid without expiration. Improvement Permit with site plan valid for sixty months. Authorization to Construct is valid for a period equal to that of Improvement Permit – not to exceed sixty months.

Signed: * date 5-27-98

Improvement Permit by: Wesley Sparks RS. date 5/27/98

Authorization to Construct by: Wesley Sparks RS. date 5/27/98

Installed by: Bobby Mathew

Operation Permit by: C. [illegible] RS date 2/10/99

Existing System Inspection by: date

HEALTH DEPT. COPY: WHITE INSPECTION COPY (FINAL): GREEN OWNER COPY (FINAL): YELLOW INSPECTION COPY (INITIAL): PINK OWNER COPY (INITIAL): GOLD