IREDELL COUNTY HEALTH DEPARTMENT

→ Authorization to Construct

3:30

STATESVILLE 704-878-5305 MOORESVILLE 704-664-5281

IMPROVEMENT PERMIT / ~~CERTIFICATE OF COMPLETION~~ / OPERATION PERMIT / EXISTING SYSTEM INSPECTION

PROPERTY DESCRIPTION NO. 24147 DATE 6/25/96 TAX MAP NO. 2 2F-6-B-14 Watershed: ☑ Yes ☐ No WSIV-CA

OWNER OR CONTRACTOR Mark Pope PHONE: Business 528-5113 Home 4648-45-0507

ADDRESS PO Box 1363 Trustown NC 28166

LOCATION Bluefield - TL Big Indian Loop - Take first Turn ~ .5 mile on left.

SUBDIVISION Indian Hill BLOCK / SECTION LOT 14 LOT AREA .85ac SITE CLASS. PS DESIGN FLOW 360gpd L.T.A.R. .3gpd/ft²

Septic Tank: 1000 Gallons; STB 794 Date 8/25/97

Pump Tank: Gallons; PT Date

Pump Make: Model Serial No.

Nitrification Field: No Fields 1 Square Feet 1200 Linear Feet 400

No Lines 5 Trench Width 36" Max Trench Bottom Depth 36" Gravel Depth 12"

☑ New System ☐ Repair System Type: I, II, III, IV, V, VI

System Description: Gravity Conventional

Repair System Description: Gravity Panel

Maintenance Agreement Required: ☐ Yes ☑ No

☑ House/Mod. Home No. Bedrooms 3

☐ Mobile Home No. Bathrooms 2

☐ Business No. Employees

☐ Other

☐ Slab ☑ Crawl Space ☐ Basement w/plumbing ☐ Basement wo/plumbing


Water Supply: ☑ Individual ☐ Community ☐ Public

Comments:


Comments:

INITIAL SITE SKETCH

1:60

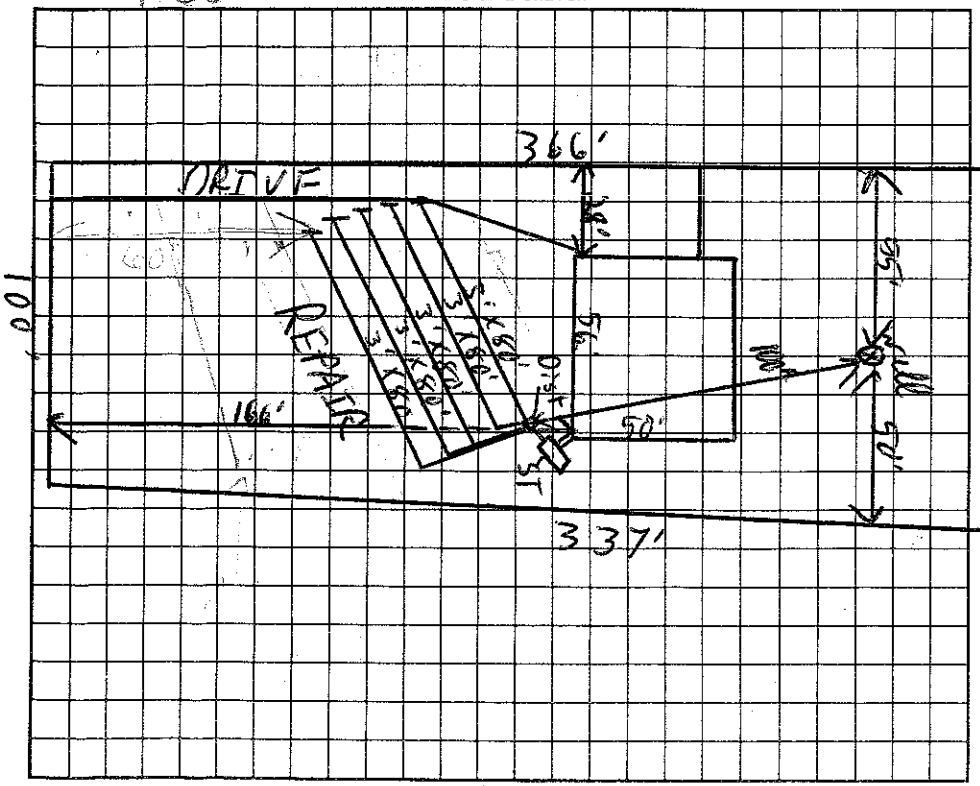

AS BUILT SKETCH

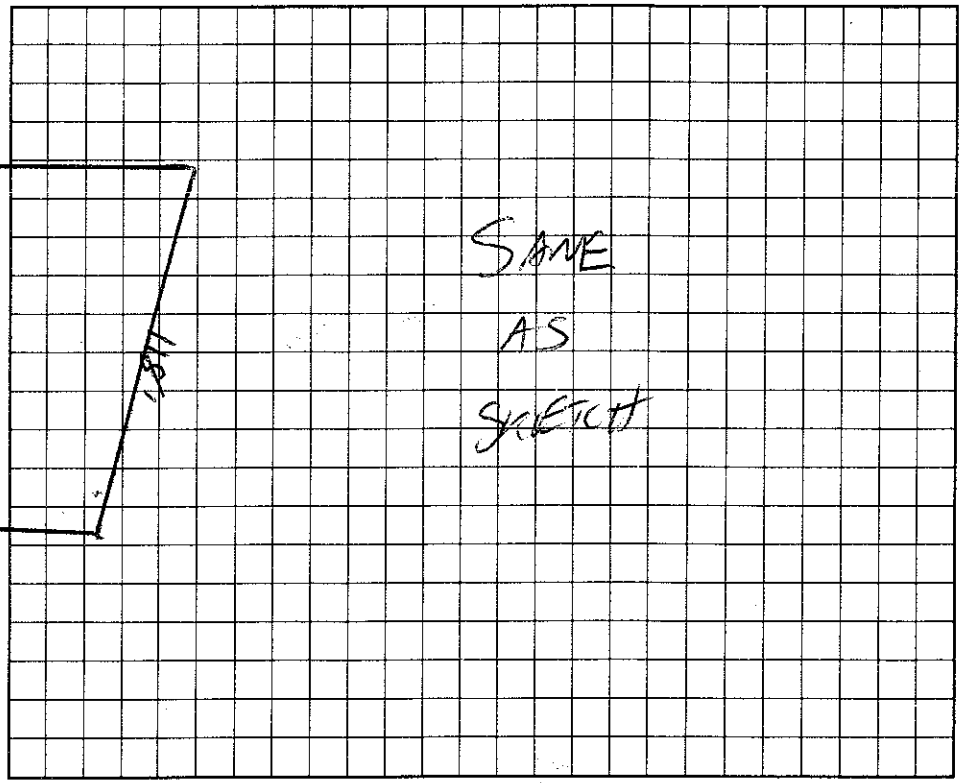

I understand that this permit can be suspended or revoked if any false information is supplied toward securing the permit/any unauthorized changes are made to the site/any unauthorized changes are made in the installation of the system.

Signed: Mark Pope

Installed by: WES LYTTON

Improvement Permit by: C. Ruby Freeman EHSE date 6/25/96

Existing System Inspection by: C. Ruby Freeman EHSE date 6/25/96

Authorization to Construct

Certificate of Completion by: date

Operation Permit by: C. Ruby Freeman RS date 11/19/97

HEALTH DEPT. COPY: WHITE INSPECTION COPY (FINAL): GREEN OWNER COPY (FINAL): YELLOW INSPECTION COPY (INITIAL): PINK OWNER COPY (INITIAL): GOLD

Authorization to Construct is valid for 60 months from issue date.