IREDELL COUNTY HEALTH DEPARTMENT

STATESVILLE 704-878-5305 MOORESVILLE 704-664-5281

IMPROVEMENT PERMIT / AUTHORIZATION TO CONSTRUCT / OPERATION PERMIT / EXISTING SYSTEM INSPECTION

PERMIT# 072398 PIN# 4648 45 2031 4648-45-2031 DATE ~~1/25/98~~ 1/26/99

OWNER OR CONTRACTOR WILLIAM HAMRICK PHONE: Business Home

ADDRESS 2370 HARRISON AVE ST ALBANS WV 25177

LOCATION BLUEFIELD TL BEGINNING - PT AT FORK - ON LT

SUBDIVISION INDIAN HILL BLOCK / SECTION 2 LOT 30 LOT AREA 1.054C SITE CLASS ES DESIGN FLOW 300GPD T.A.R. .30 GPD/FT²

Septic Tank: 1000 Gallons; STB 1012 Date 12-16-98
Pump Tank: Gallons; PT Date
Pump Make: Model Serial No.
Nitrification Field: No Fields 1 Square Feet 900 Linear Feet 300
No Lines 4@75 Trench Width 36" Max Trench Bottom Depth 36" Gravel Depth N/A

☑ New System ☐ Repair System Type: I, II, (III) IV, V, VI
System Description: GRAVITY CHAMBERS ORHS
Repair System Description: PANEL
Maintenance Agreement Required: ☐ Yes ☑ No


☑ House/Mod. Home No. Bedrooms 3
☐ Mobile Home No. Bathrooms 2
☐ Business No. Employees
☐ Other
☐ Slab ☑ Crawl Space ☐ Basement w/plumbing ☐ Basement wo/plumbing

Water Supply: ☑ Individual ☐ Public ☐ Community


Comments:/Conditions: Well not installed at time of inspection. MD.

Comments:/Conditions: Installed-filter & risers.

INITIAL SITE SKETCH 1"=60'

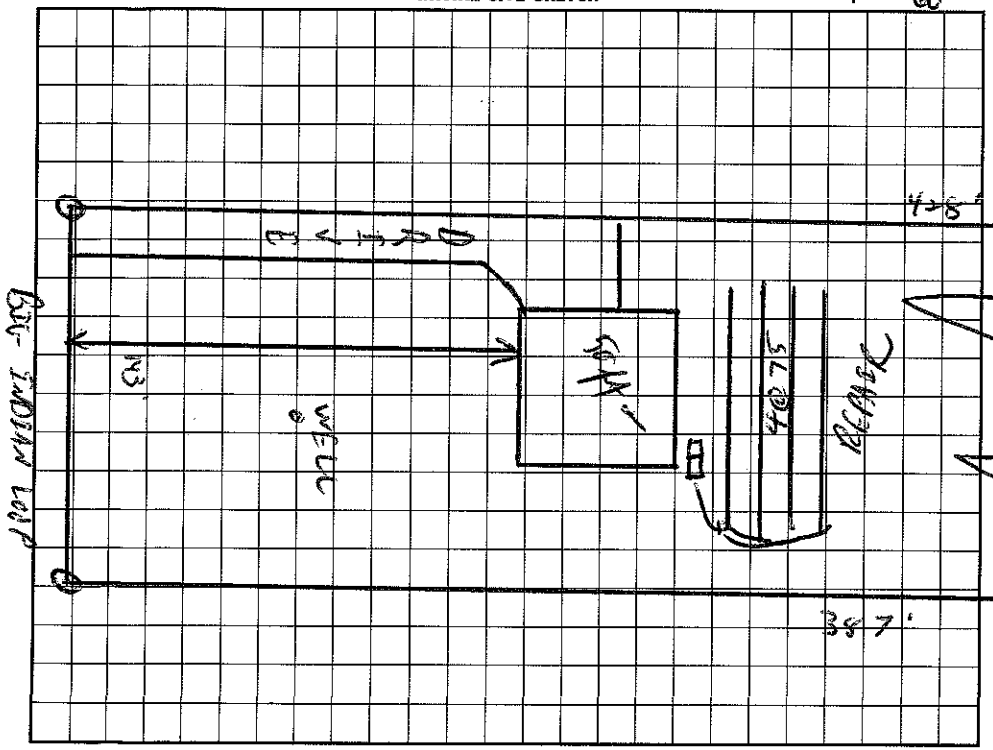

AS BUILT SKETCH

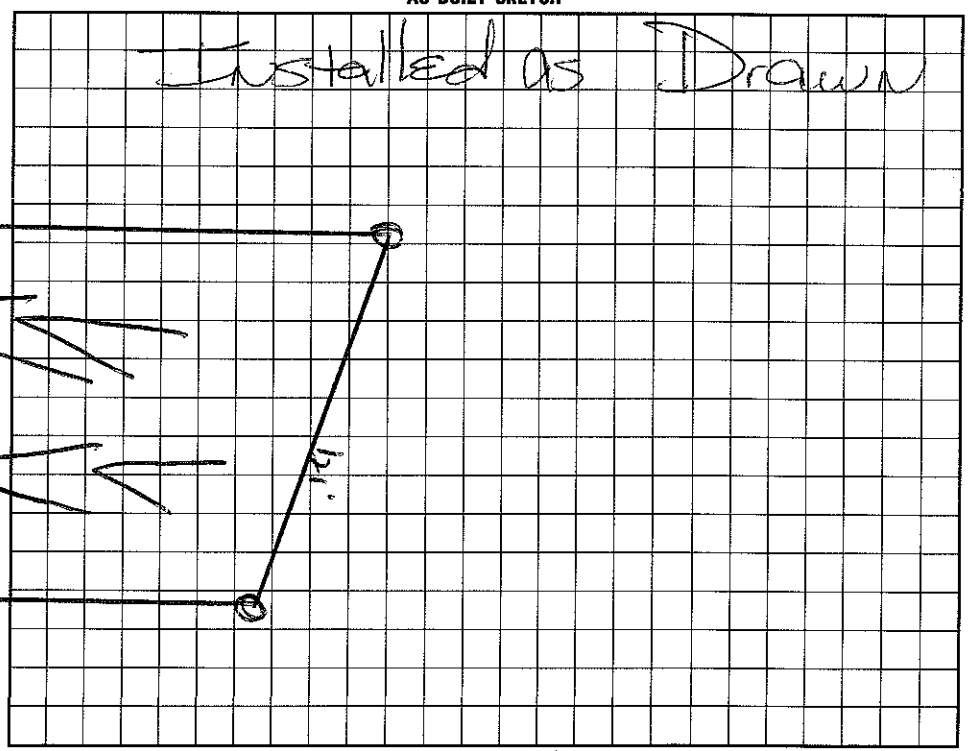

I understand that this permit can be suspended or revoked if any false information is supplied toward securing the permit/any unauthorized changes are made to the site/any unauthorized changes are made in the installation of the system. Improvement Permit with plat valid without expiration. Improvement Permit with site plan valid for sixty months. Authorization to Construct is valid for a period equal to that of Improvement Permit – not to exceed sixty months.

Signed: David Cain date 1/26/99

Improvement Permit by: C. [illegible] date 1/21/99

Authorization to Construct by: C. [illegible] date 1/21/99

Installed by: Johnson Complete Landscaping

Operation Permit by: Maria H. Johnson RS date 1/27/99

Existing System Inspection by: date

HEALTH DEPT. COPY: WHITE INSPECTION COPY (FINAL): GREEN OWNER COPY (FINAL): YELLOW INSPECTION COPY (INITIAL): PINK OWNER COPY (INITIAL): GOLD