3150

IREDELL COUNTY HEALTH DEPARTMENT

Statesville Office (704) 878-5305 Mooresville Office (704) 660-3625 PERMIT # 212006

IMPROVEMENT PERMIT / AUTHORIZATION TO CONSTRUCT / OPERATION PERMIT / EXISTING SYSTEM

PIN # 4648-48-~~2151~~-2173

APPLICANT: Sisters Cove LKN APPLICANT ADDRESS: PO Box 3965 Mooresville

SITE ADDRESS: 110 Sisters Cove Court - Mooresville PHONE: 704-267-6480 ALT. PHONE: 704-208-4251 x1004

SITE DIRECTIONS: Hwy 150W, TR on Perth, TR on Cornelius, TR on Sisters Cove Ct, Lot on R

SUBDIVISION: Sisters Cove SECTION: 5 LOT # 10 LOT AREA: 0.156 DESIGN FLOW: 360 gpd L.T.A.R.:

Septic Tank 2000 (gal) STB 74 Date 11-1-15
Pump Tank (gal) PT Date
Pump Make Model Serial #
Nitrification Fields 1 # Lines Linear Ft:
Trench Width Max. Trench Bottom Depth Gravel Depth

☑ New System ☐ Repair ☐ Expansion System Type: I II III IV ⓥ VI
System Description: Community TS-11 Drip Irr.
Repair System Description: Community TS-11 Drip Irr.
Maintenance Agreement Required: ☑ YES ☐ NO
☐ GRAVITY ☑ PRESSURE


☑ Residence No. Bedrooms 3
☐ Business No. Persons 6
☐ Other No. Employees
☑ Slab ☐ Crawl Space
☐ Basement w/plumbing ☐ Basement w/o plumbing

Water Supply: ☐ Private ☐ Public ☑ Community

Comments / Conditions: Install pump package, control panel and connect to collection line as specified by Piedmont Design

BA checked tank
4/21/16 Ran pump

INITIAL SITE SKETCH

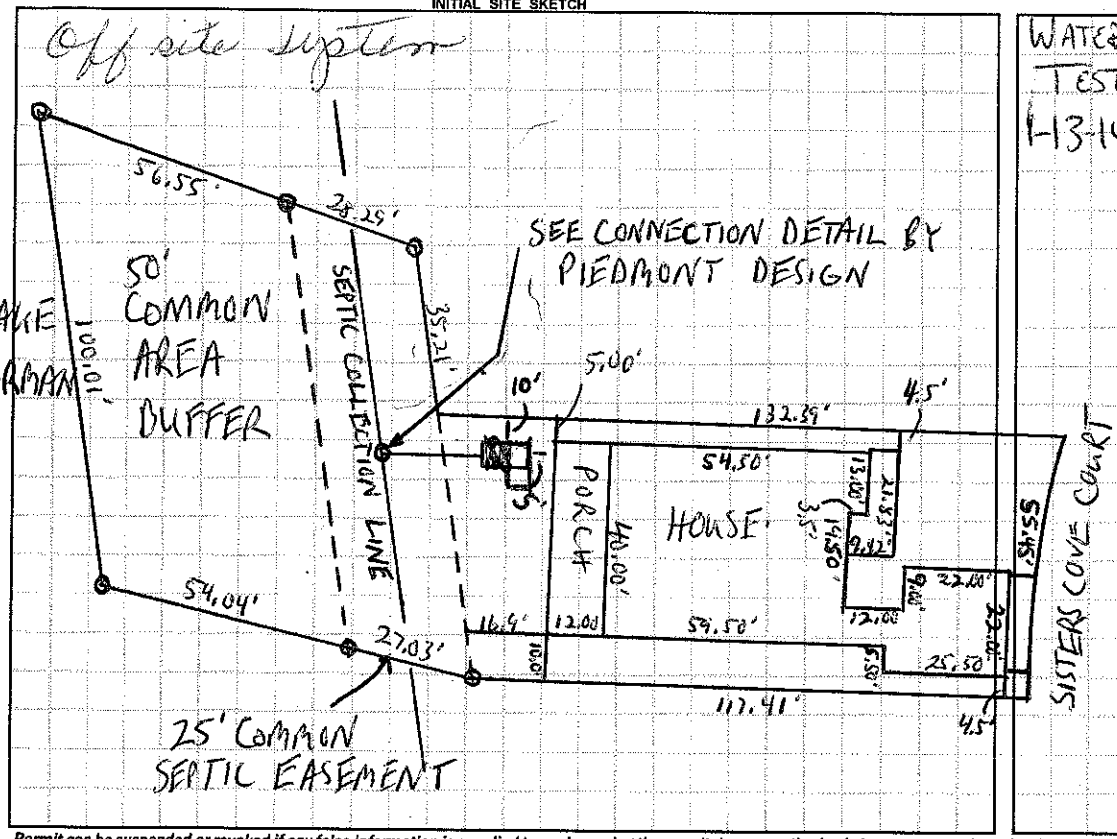

AS BUILT SKETCH

WATER TEST 1-13-16 15 1/4 / 15 3/4 1-14-16

Permit can be suspended or revoked if any false information is supplied toward securing the permit / any unauthorized changes are made to the site / any unauthorized changes are made in the installation of the system. **CONTACT A LOCATOR SERVICE PRIOR TO ANY EXCAVATION**


☐ **IMPROVEMENT PERMIT** *with plat valid without expiration.* ☐ **IMPROVEMENT PERMIT** *with site plan valid for 60 mos.* ☑ **AUTHORIZATION TO CONSTRUCT** *valid for period equal to IMPROVEMENT PERMIT--not to exceed 60 mo.*

Owner / Applicant Signature: Heather Cook Date: 7/28/15 Installed by: R&H

IMPROVEMENT PERMIT by: Date: OPERATION PERMIT by: Maria Dolson RS Date: 4/21/16

AUTHORIZATION TO CONSTRUCT by: Date: 7-22-15 Existing System Inspected by: Date:

Health Dept. Copy - WHITE Applicant (Final Approval) - YELLOW Applicant (Conditional Approval) - PINK

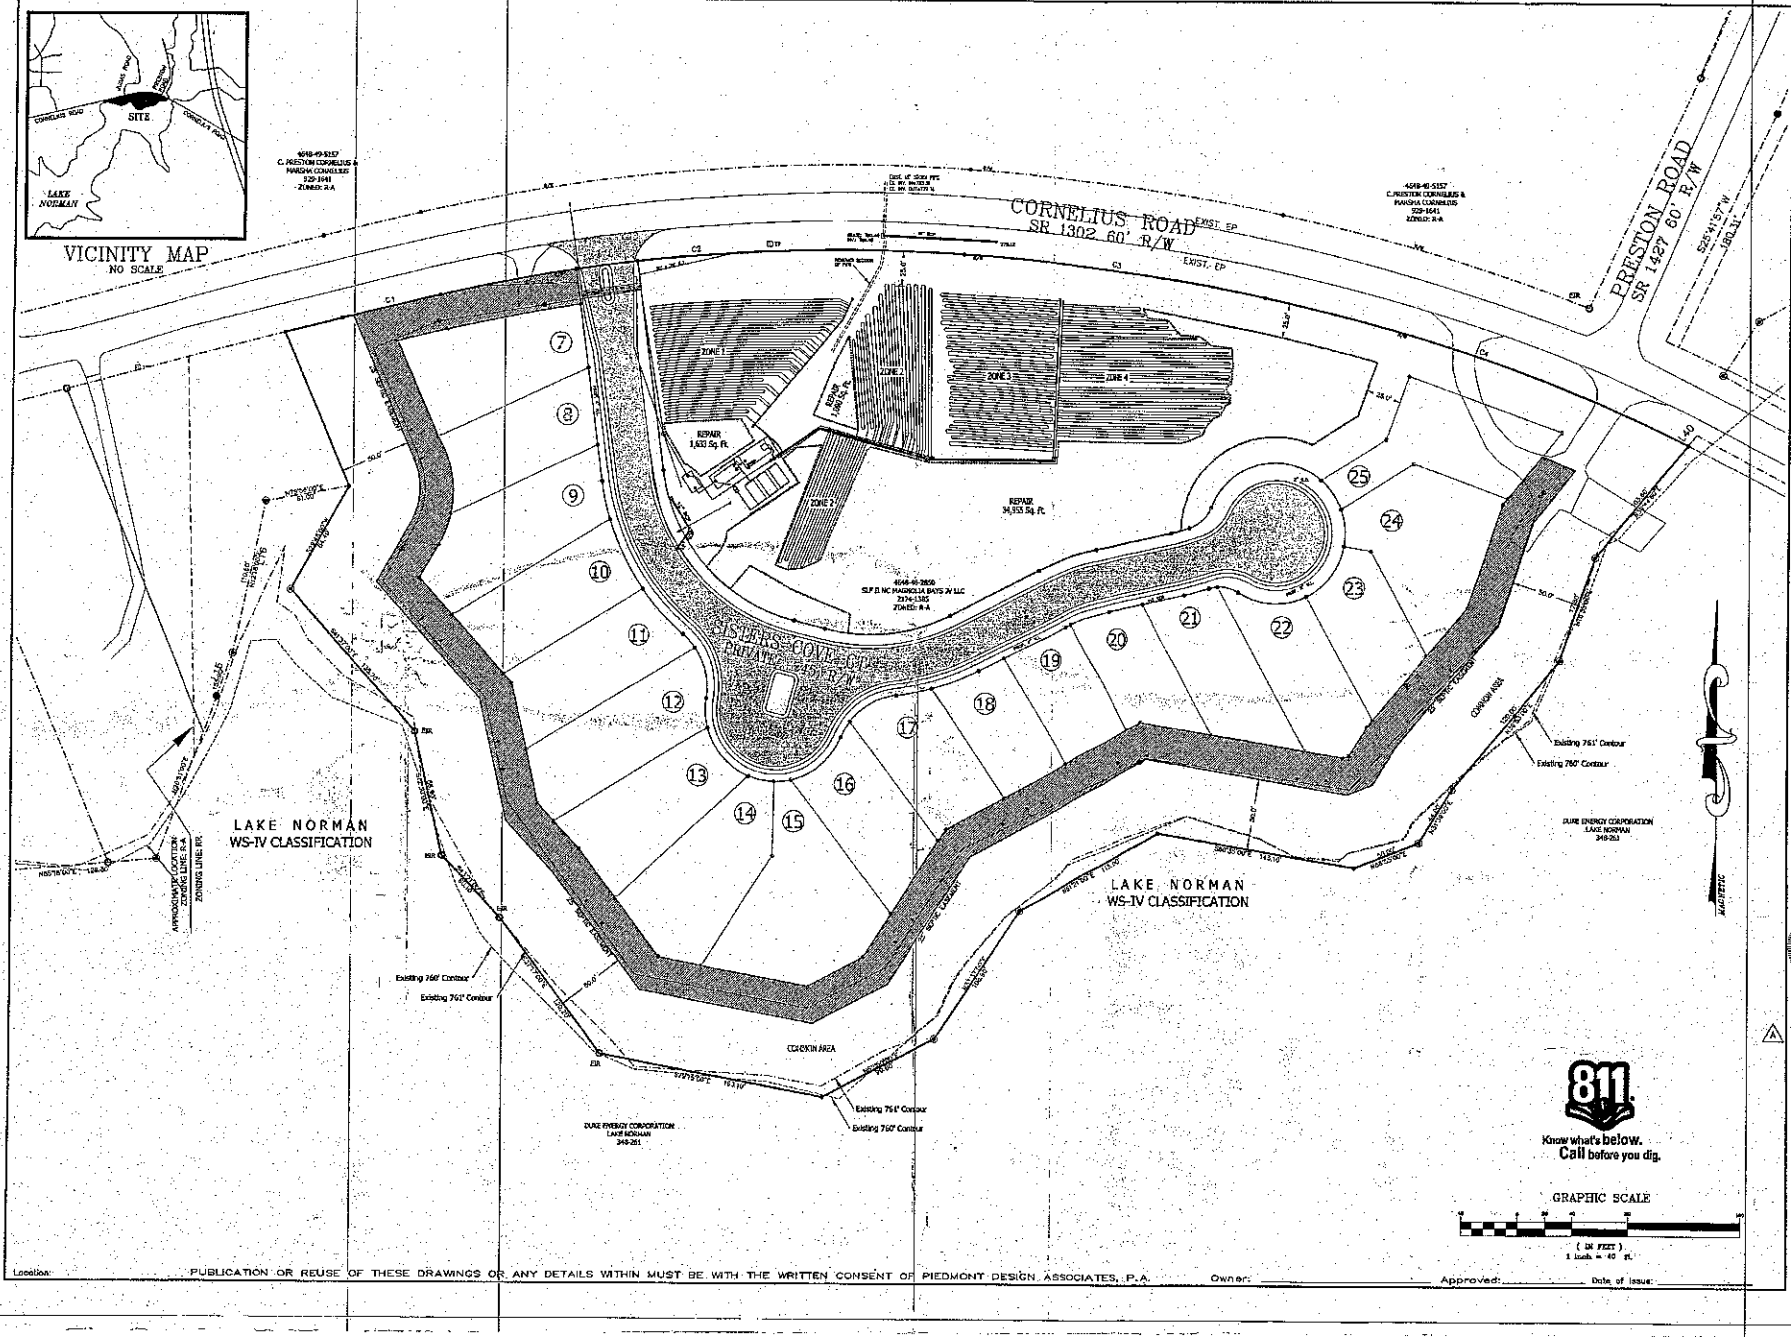

PIEDMONT DESIGN
ENGINEERING SURVEYING PLANNING
Associates, P.A.
Suite 101 Westfield Center, 125 East Plaza Drive
Mooresville, NC 28115
Phone: (704) 664-7755 Fax: (704) 664-7756 www.pdpa.com
NC Firm # C-1267 SC Firm # C-2367

PREPARED FOR:
HINKLEY GAUVAIN
PO BOX 3965
MOORESVILLE, NC 28117
704-202-1524

SEPTIC SYSTEM SITE PLAN
SISTERS COVE PHASE V
CORNELIUS ROAD
MOORESVILLE, IREDELL Co., NORTH CAROLINA

REVISIONS	BY	DATE
AS REQ'D BY PLANNING		

Date: 4/17/14
Scale: 1"=40 Ft
1' Contours
Drawn: DMD
Checked: DLM
Project: 2013-10-01
Job: 2013-10-01
Sheet
U-1
4/21/15
Sheets

Location:

PUBLICATION OR REUSE OF THESE DRAWINGS OR ANY DETAILS WITHIN MUST BE WITH THE WRITTEN CONSENT OF PIEDMONT DESIGN ASSOCIATES, P.A.

Owner: _____ Approved: _____ Date of Issue: _____