IREDELL COUNTY HEALTH DEPARTMENT

Statesville Office (704) 878-5305 Mooresville Office (704) 660-3625 PERMIT # 218251

IMPROVEMENT PERMIT / AUTHORIZATION TO CONSTRUCT / OPERATION PERMIT / EXISTING SYSTEM

PIN # 4648487038

APPLICANT: Nest Homes LLC APPLICANT ADDRESS: P.O. Box 3965 Mooresville, NC 28117

SITE ADDRESS: 130 Sister Cove Ct. Mooresville, NC 28117 PHONE: 704 433-9417 ALT. PHONE:

SITE DIRECTIONS: I-521 N. TL Cornelius Rd TL Sisters Cove Ct

SUBDIVISION: Sisters Cove SECTION: 5 LOT # 20 LOT AREA: .153Ac. DESIGN FLOW: 360gpd L.T.A.R.:

Septic Tank 2000 (gal) STB 74 Date
Pump Tank (gal) PT Date
Pump Make Model Serial #
Nitrification Fields # Lines Linear Ft:
Trench Width Max. Trench Bottom Depth Gravel Depth

☒ New System ☐ Repair ☐ Expansion System Type: I II III IV (V) VI
System Description: Community TS II Drip Irrg.
Repair System Description: Same
Maintenance Agreement Required: ☒ YES ☐ NO
☐ GRAVITY ☒ PRESSURE


☒ Residence No. Bedrooms 3
☐ Business No. Persons 6
☐ Other No. Employees
☐ Slab ☐ Crawl Space
☒ Basement w/plumbing ☐ Basement w/o plumbing

Water Supply: ☐ Private ☐ Public ☒ Community

Comments / Conditions: Install Pump Package, Control panel and Connect to Collection line as specified by Piedmont Design.

Do Not grade down for basement

INITIAL SITE SKETCH

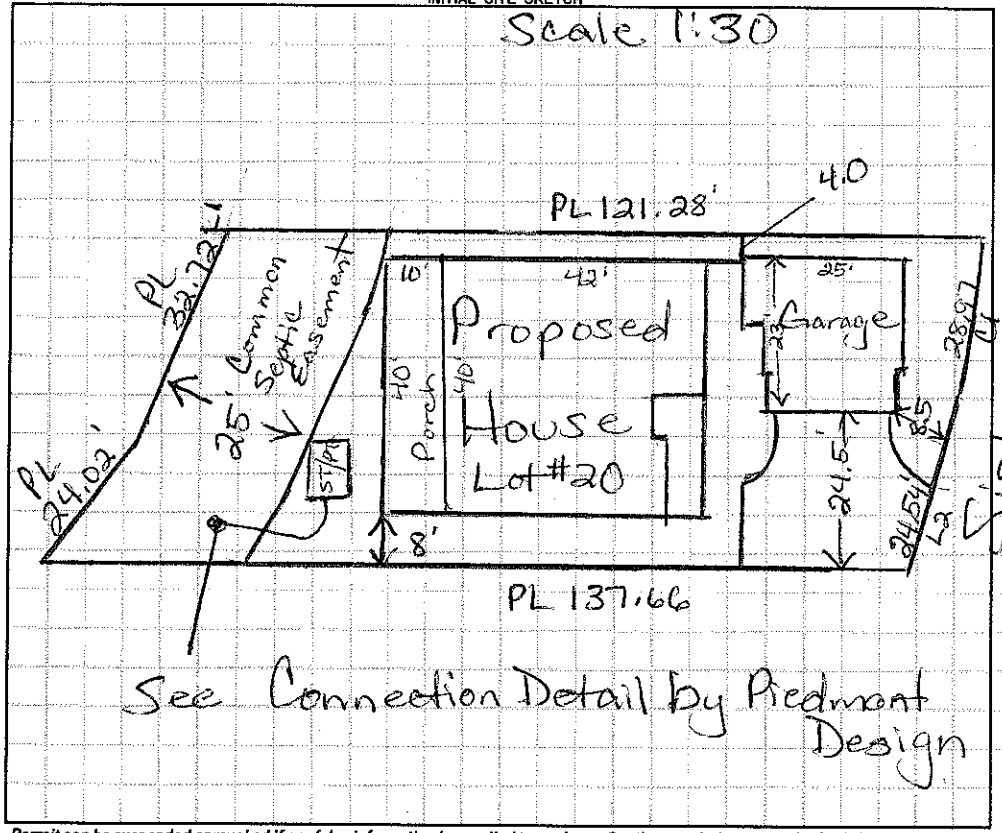

AS BUILT SKETCH

(Off site system)

	Date	Initials
Drain Lines Checked		
Tanks Checked	11/23	ws
Pressure Manifold or Valve Box Checked		
Pressure Head Set		
Electrical Checked	1-25	RA
Floats Set		
Alarm Checked	1-25	RA
Maintenance Contract Y / N		
Comments 11/16 Tank Leaky		

Permit can be suspended or revoked if any false information is supplied toward securing the permit / any unauthorized changes are made to the site / any unauthorized changes are made in the installation of the system. **CONTACT A LOCATOR SERVICE PRIOR TO ANY EXCAVATION**


☐ **IMPROVEMENT PERMIT** *with plat valid without expiration.* ☐ **IMPROVEMENT PERMIT** *with site plan valid for 60 mos.* ☐ **AUTHORIZATION TO CONSTRUCT** *valid for period equal to IMPROVEMENT PERMIT--not to exceed 60 mo.*

Owner / Applicant Signature: Date: 4/29/16 Installed by: R&H

IMPROVEMENT PERMIT by: RS Date: 4/27/16 OPERATION PERMIT by: RA Date: 1-25-17

AUTHORIZATION TO CONSTRUCT by: RS Date: 4/27/16 Existing System Inspected by: Date:

Health Dept. Copy - WHITE Applicant (Final Approval) - YELLOW Applicant (Conditional Approval) - PINK

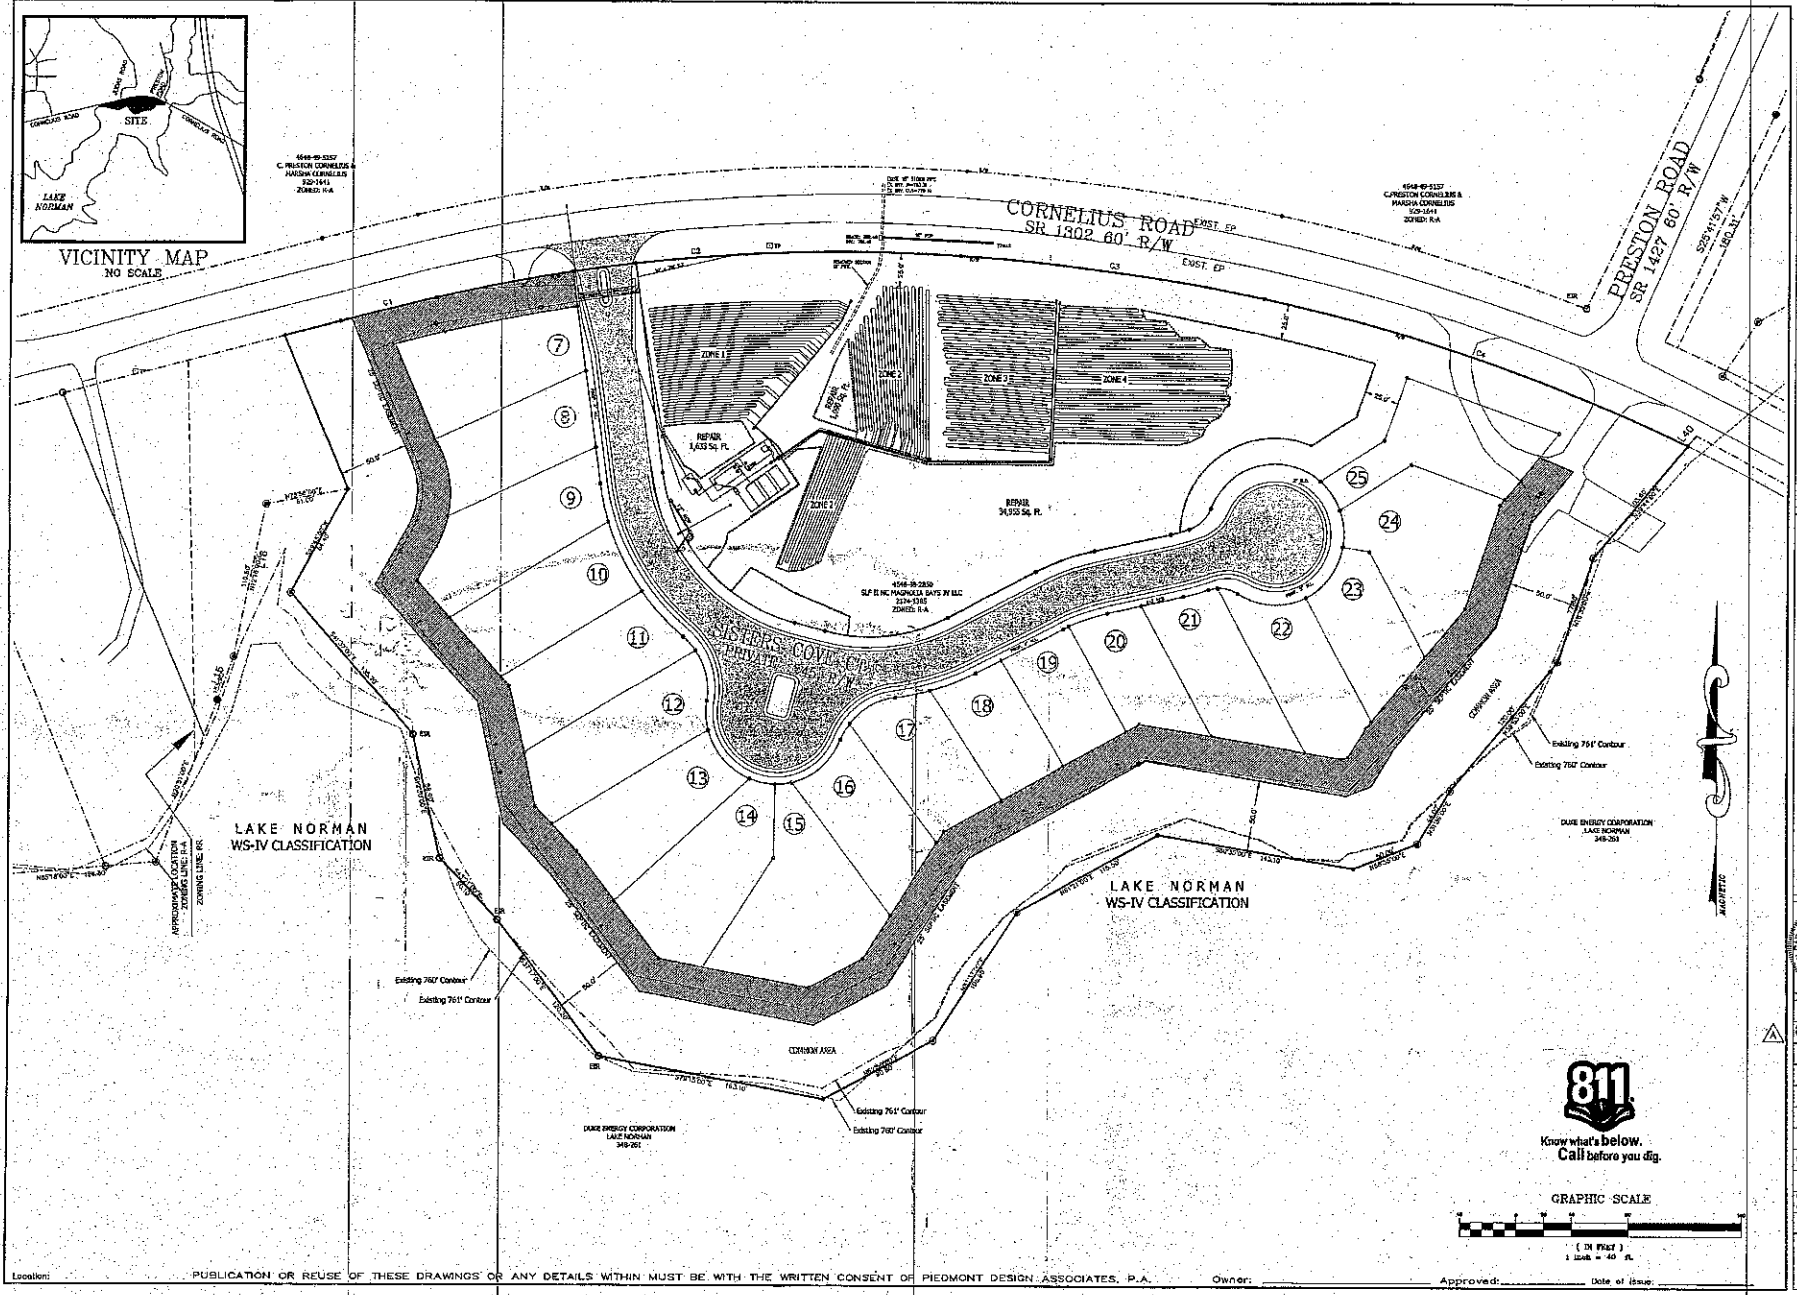

PIEDMONT DESIGN
ASSOCIATES, P.A.

PREPARED FOR:
HINKLEY GAUVAIN
PO BOX 3965
MOORESVILLE, NC 28117
704-202-1524

SEPTIC SYSTEM SITE PLAN
SISTERS COVE PHASE V
CORNELIUS ROAD
MOORESVILLE, IREDELL Co., NORTH CAROLINA

REVISIONS	BY
AS BUILT 11/20/15	DMD

Date: 4/17/14
Scale: 1"=40 Ft
1' Contours
Drawn: DMD
Checked: DLM
Project: 2013-10-01
Job: 2013-10-01
Sheet
U-1
4/21/15
Sheet

PUBLICATION OR REUSE OF THESE DRAWINGS OR ANY DETAILS WITHIN MUST BE WITH THE WRITTEN CONSENT OF PIEDMONT DESIGN ASSOCIATES, P.A.

Location: Owner: Approved: Date of Issue: