IREDELL COUNTY HEALTH DEPARTMENT

Statesville Office (704) 878-5305 Mooresville Office (704) 660-3625 PERMIT # 206046

IMPROVEMENT PERMIT / AUTHORIZATION TO CONSTRUCT / OPERATION PERMIT / EXISTING SYSTEM

PIN # 4648-48-~~9101~~9059

APPLICANT: Nest Homes APPLICANT ADDRESS: 236 Raceway Dr, Suite 7 Mooresville NC 28117

SITE ADDRESS: 136 Sisters Cove Ct PHONE: 704-660-0292 ALT. PHONE:


SITE DIRECTIONS: Hwy 115 N, before Hwy 21/Hwy 115 merge turn L on cut through, TL on Hwy 21 S, TR on Connelly's Rd, TL on Sisters Cove Ct

SUBDIVISION: Sisters Cove SECTION: 5 LOT # 23 LOT AREA: 0.125 ac DESIGN FLOW: 360 gpd L.T.A.R.: Lot@End

Septic Tank 2000 (gal)	STB 99	Date 7-13-15	☑ New System ☐ Repair ☐ Expansion	System Type: I II III IV (V) VI	☑ Residence	No. Bedrooms 3	Water Supply
Pump Tank (gal)	PT	Date	System Description: Community TS11 Drip Irr.		☐ Business	No. Persons 6	☐ Private
Pump Make	Model	Serial #	Repair System Description: Community TS11 Drip Irr.		☐ Other	No. Employees	☐ Public
# Nitrification Fields	# Lines	Linear Ft:	Maintenance Agreement Required:	☐ YES ☐ NO	☐ Slab	☐ Crawl Space	☑ Community
Trench Width	Max. Trench Bottom Depth	Gravel Depth		☐ GRAVITY ☐ PRESSURE	☑ Basement w/plumbing		☐ Basement w/o plumbing

Comments / Conditions: Install pump package, control panel and connect to collection line as specified by Piedmont Design's design.

INITIAL SITE SKETCH

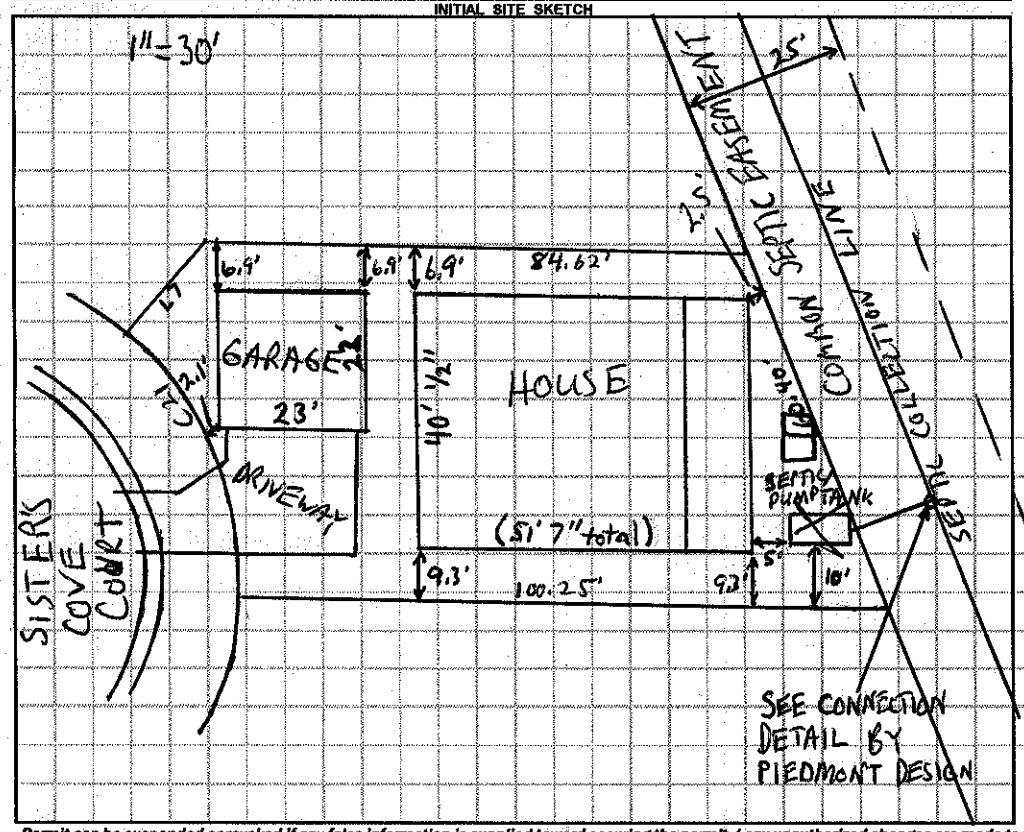

AS BUILT SKETCH

CHECKED TANK 4-10-15 RA

CHECKED PUMP RA

Permit can be suspended or revoked if any false information is supplied toward securing the permit / any unauthorized changes are made to the site / any unauthorized changes are made in the installation of the system. **CONTACT A LOCATOR SERVICE PRIOR TO ANY EXCAVATION**

☐ **IMPROVEMENT PERMIT** *with plat valid without expiration.* ☐ **IMPROVEMENT PERMIT** *with site plan valid for 60 mos.* ☑ **AUTHORIZATION TO CONSTRUCT** *valid for period equal to IMPROVEMENT PERMIT--not to exceed 60 mo.*

Owner / Applicant Signature: Date: Installed by:

IMPROVEMENT PERMIT by: [redacted] Date: [redacted] OPERATION PERMIT by: R&H BA Date: 7-29-15

AUTHORIZATION TO CONSTRUCT by: [signature] Date: 10-27-14 Existing System Inspected by: Date:

Health Dept. Copy - WHITE Applicant (Final Approval) - YELLOW Applicant (Conditional Approval) - PINK