S/D: WSH Investment Properties

IREDELL COUNTY HEALTH DEPARTMENT

Statesville Office (704) 878-5305 Mooresville Office (704) 660-3625 PERMIT # 214268

IMPROVEMENT PERMIT / AUTHORIZATION TO CONSTRUCT / OPERATION PERMIT / EXISTING SYSTEM

PIN # 4648-53-2807 0877

APPLICANT: NEST HOMES APPLICANT ADDRESS: Po Box 3965 Mville 28117

SITE ADDRESS: 168 BIG INDIAN LOOP - Mooresville PHONE: 704-208-4251 ALT. PHONE:

SITE DIRECTIONS: BLUEFIELD, BIG INDIAN, ON R

SUBDIVISION: MARY HELEN COLLINS PROPERTY SECTION: - LOT # 1 LOT AREA: .69 AC DESIGN FLOW: 480 L.T.A.R.: .3

Septic Tank 1000 (gal) STB 794 Date 3-22-16
Pump Tank (gal) PT Date
Pump Make Model Serial #
Nitrification Fields 1 # Lines 4 Linear Ft: 400
Trench Width 36" Max. Trench Bottom Depth 36" Gravel Depth -

☒ New System ☐ Repair ☐ Expansion System Type: I II (III) IV V VI
System Description: 25% REDUCTION
Repair System Description: PANEL BLOCK
Maintenance Agreement Required: ☐ YES ☒ NO
☒ GRAVITY ☐ PRESSURE

☒ Residence ☐ Business ☐ Other ☐ Slab ☐ Basement w/plumbing
No. Bedrooms 4 No. Persons No. Employees ☒ Crawl Space
Water Supply: ☒ Private ☐ Public ☐ Community ☐ Basement w/o plumbing

Comments / Conditions: DO NOT ISSUE AC UNTIL LOT IS RECORDED
Recorded 12-22-2015 -SL

Installed Quick 4, essentially as drawn

INITIAL SITE SKETCH

SEE PLAN FROM PENNINGER SOIL CONSULTING PLLC

AS BUILT SKETCH

Permit can be suspended or revoked if any false information is supplied toward securing the permit / any unauthorized changes are made to the site / any unauthorized changes are made in the installation of the system. **CONTACT A LOCATOR SERVICE PRIOR TO ANY EXCAVATION**


☐ **IMPROVEMENT PERMIT** *with plat valid without expiration.* ☒ **IMPROVEMENT PERMIT** *with site plan valid for 60 mos.* ☐ **AUTHORIZATION TO CONSTRUCT** *valid for period equal to IMPROVEMENT PERMIT--not to exceed 60 mo.*

Owner / Applicant Signature: Date: 11/2/15 Installed by: R & H

IMPROVEMENT PERMIT by: APPROVED OCT 22 2015 OPERATION PERMIT by: Maria Dotson RS Date: 7/21/16

AUTHORIZATION TO CONSTRUCT by: Date: 2-9-16 Existing System Inspected by: Date:

Health Dept. Copy - WHITE Applicant (Final Approval) - YELLOW Applicant (Conditional Approval) - PINK

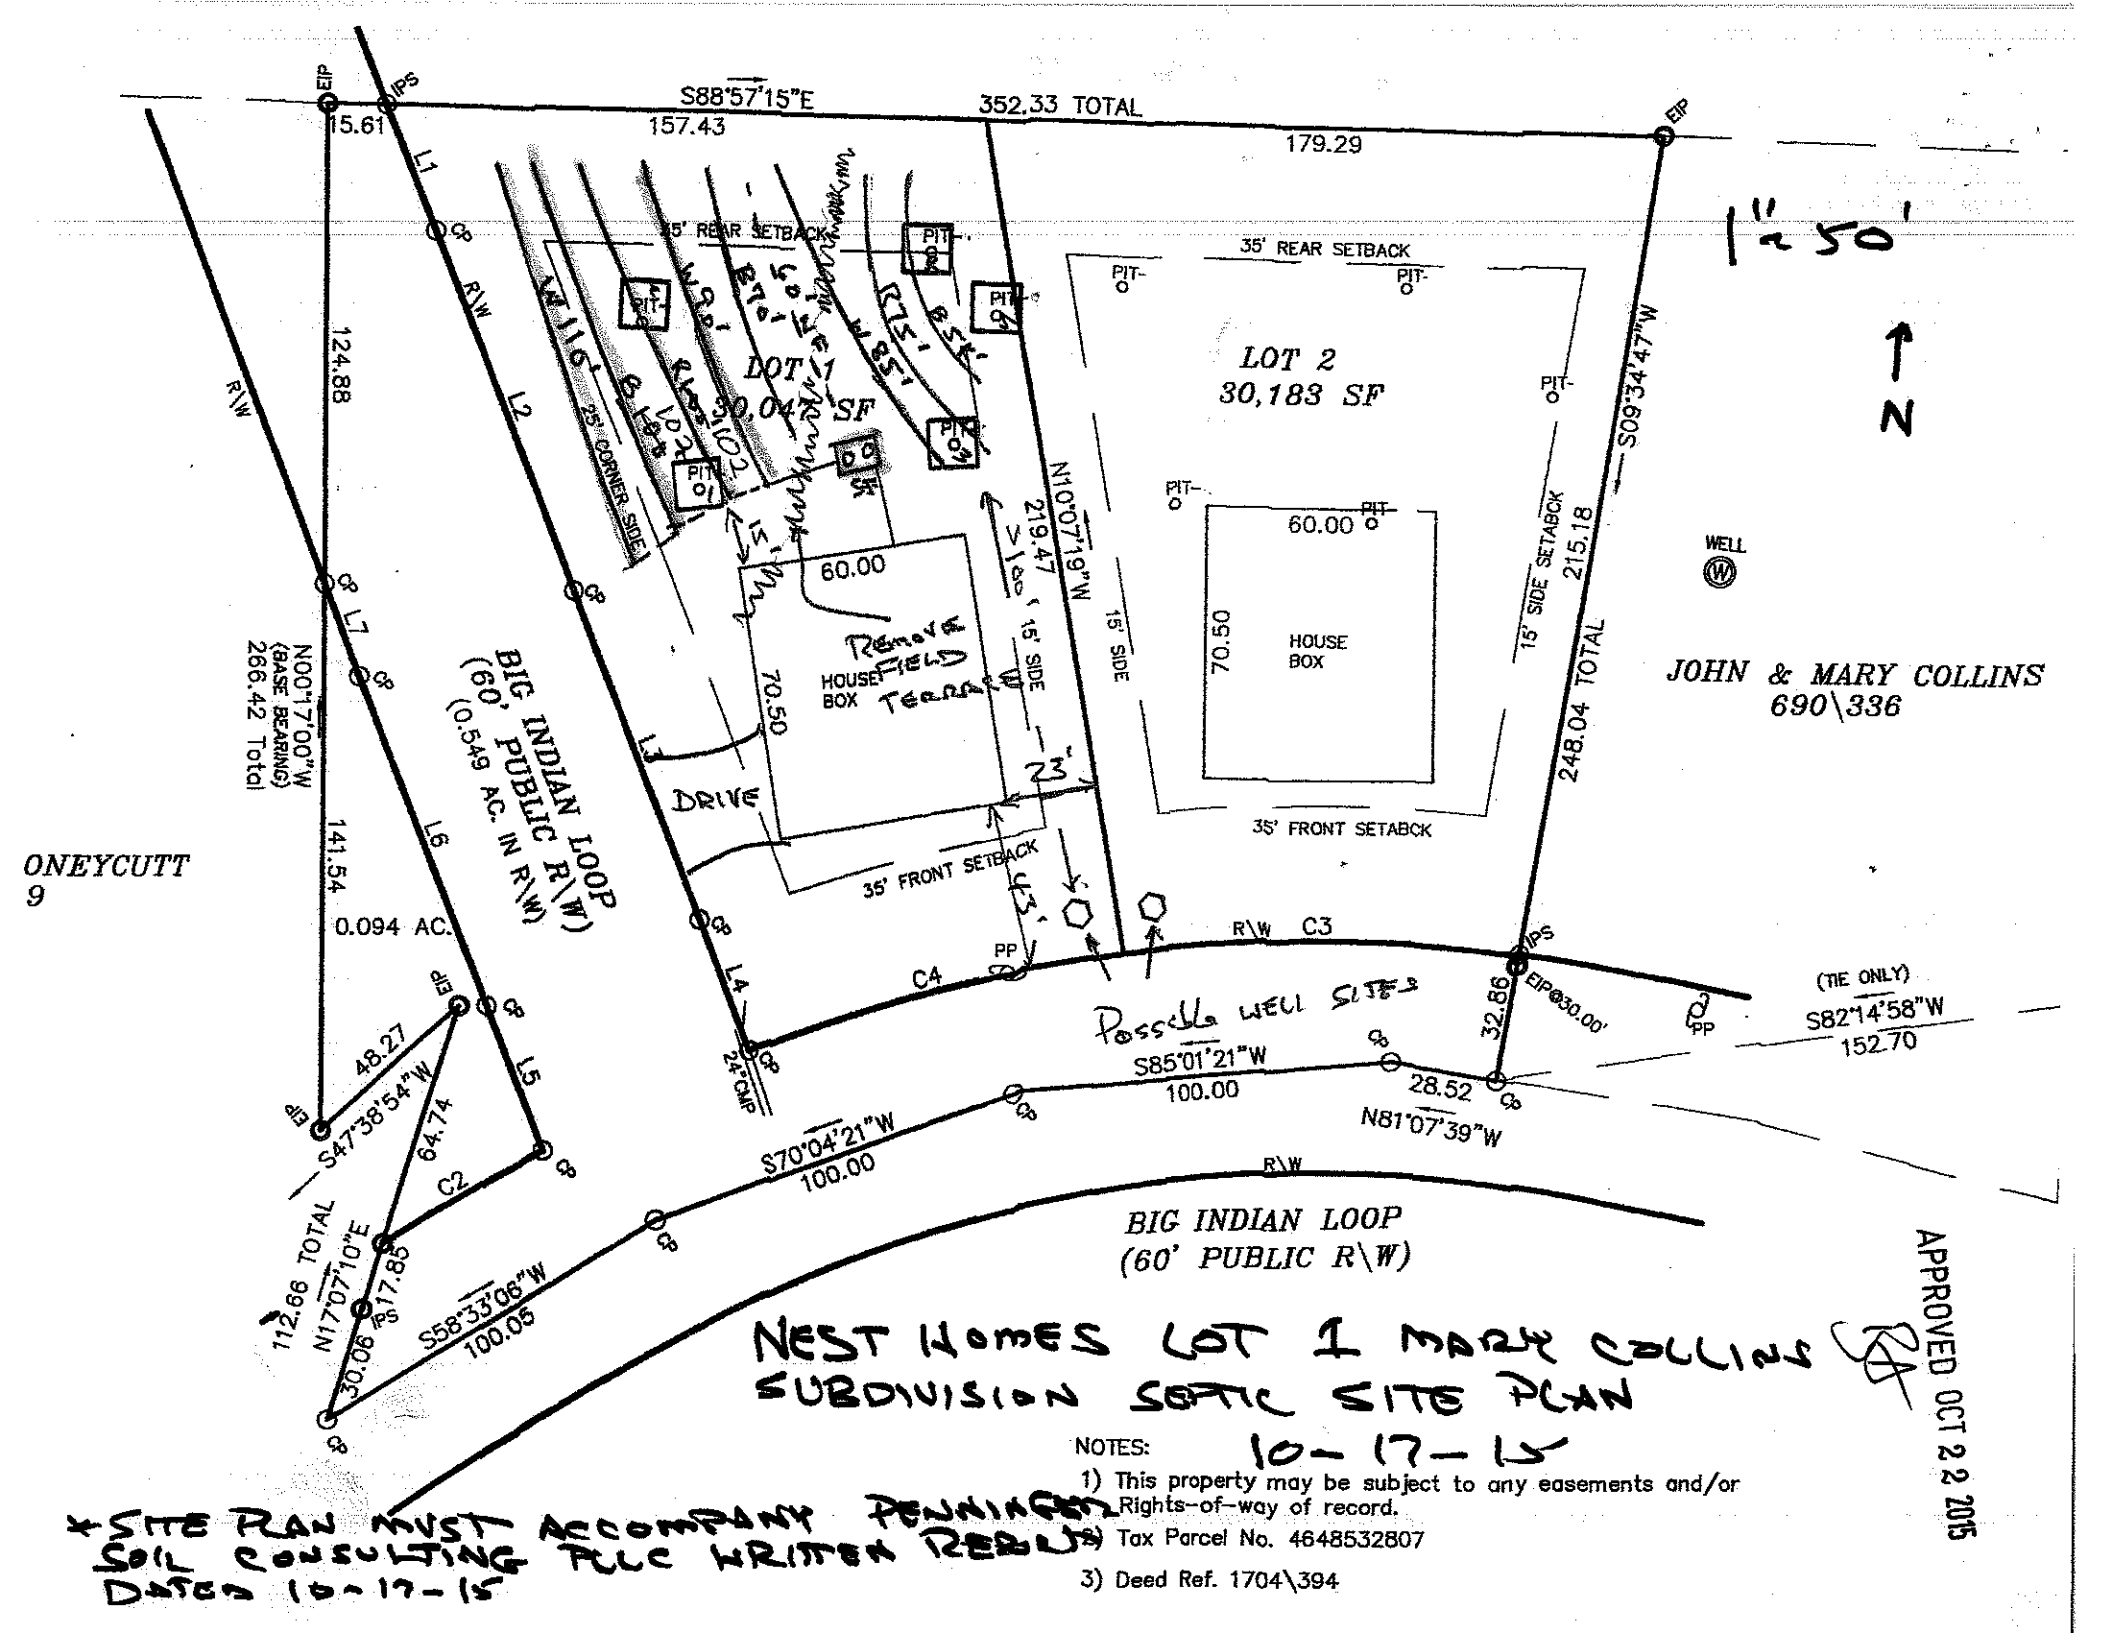

NEST HOMES LOT 1 MARY COLLINS SUBDIVISION SEPTIC SITE PLAN

10-17-15

NOTES:

1) This property may be subject to any easements and/or Rights-of-way of record.
2) Tax Parcel No. 4648532807
3) Deed Ref. 1704\394

APPROVED OCT 22 2015

DATED 10-17-15