IREDELL COUNTY HEALTH DEPARTMENT

Statesville Office (704) 878-5305 Mooresville Office (704) 660-3625 PERMIT # 177114 (12.20)

IMPROVEMENT PERMIT / AUTHORIZATION TO CONSTRUCT / OPERATION PERMIT / EXISTING SYSTEM

PIN # 4648 56 2727

APPLICANT: Magnolia Lakes Partners APPLICANT ADDRESS: P.O. Box 3965, Mooresville, NC 28117

SITE ADDRESS: 160 Pinto Road, Mooresville, N.C. PHONE: ALT. PHONE:

SITE DIRECTIONS: From Mooresville, US 21 North, TL Cornelius Road TL Pinto Road on Right near end

SUBDIVISION: Sisters Cove SECTION: 3 LOT # 62 LOT AREA: ½ ac DESIGN FLOW: 360 gpd L.T.A.R.: .25


Septic Tank	1000 (gal)	STB	825	Date	5-20-14	☒ New System	☐ Repair	☐ Expansion	System Type: I II III ⓘ V VI	☒ Residence	No. Bedrooms 3
Pump Tank	1000 (gal)	PT	302	Date	4-18-14	System Description:	LP PPBPS			☐ Business	No. Persons
Pump Make		Model		Serial #		Repair System Description:	LP PPBPS			☐ Other	No. Employees
# Nitrification Fields	1	# Lines	4	Linear Ft:	240	Maintenance Agreement Required:	☒ YES	☐ NO		☐ Slab	☒ Crawl Space
Trench Width	24", 8' OC	Max. Trench Bottom Depth	36"	Gravel Depth	N/A		☐ GRAVITY	☒ PRESSURE		☐ Basement w/plumbing	☐ Basement w/o plumbing

Water Supply: ☐ Private ☐ Public ☒ Community

Comments / Conditions: Permit may be suspended or Revoked if buried materials from prior usage are encountered which compromise the initial or Repair AREA of the septic system. Community WATER Line to Run within 50' Lake setback according to Engineer. Use ONE 5/32" hole per panel, 285 panels total. Water + Sewer Lines to be installed in accordance w/ 15A NCAC 18A .1950

5/32" hole drilled, 24 inch trenches Set 2PT pressure 7/8/14

INITIAL SITE SKETCH

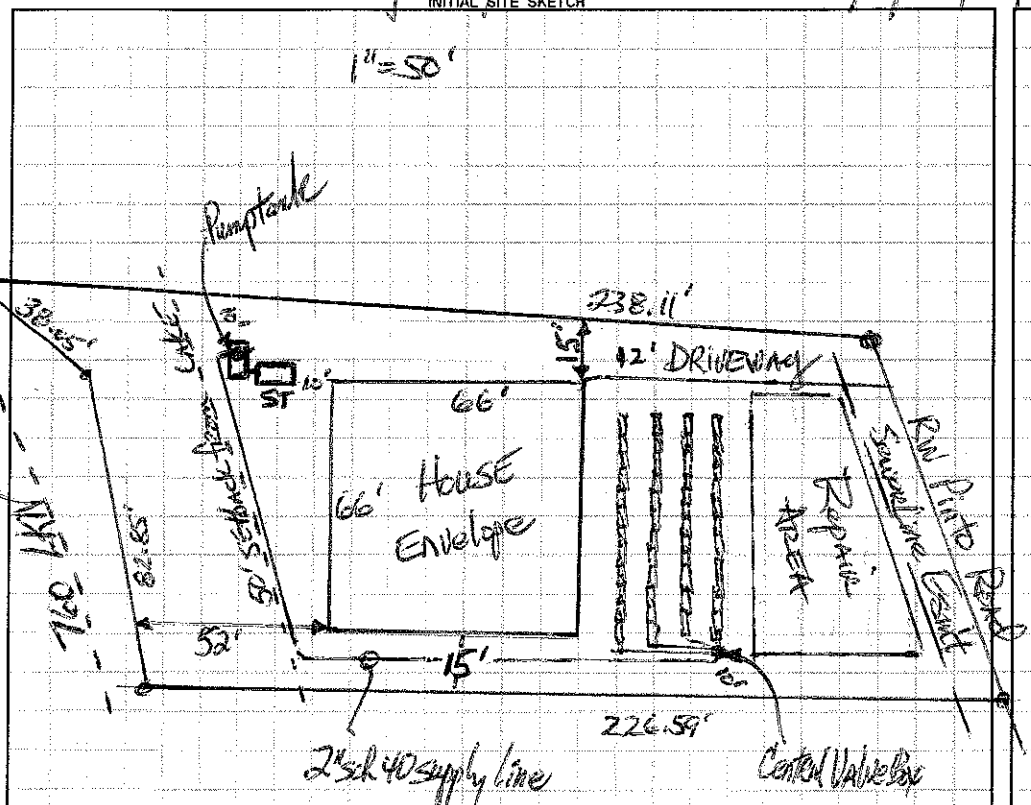

AS BUILT SKETCH

CH Electrical & Alarm Maintenance Cont. 12-4-14

Permit can be suspended or revoked if any false information is supplied toward securing the permit / any unauthorized changes are made to the site / any unauthorized changes are made in the installation of the system. **CONTACT A LOCATOR SERVICE PRIOR TO ANY EXCAVATION**

☐ **IMPROVEMENT PERMIT** *with plat* valid without expiration. ☒ **IMPROVEMENT PERMIT** *with site plan* valid for 60 mos. ☒ **AUTHORIZATION TO CONSTRUCT** valid for period equal to IMPROVEMENT PERMIT--not to exceed 60 mo.

Owner / Applicant Signature: Date: 8/16/13 Installed by: Royan Septic

IMPROVEMENT PERMIT by: DR Hinson REHS Date: 8-9-13 OPERATION PERMIT by: APPROVED Date: DEC 04 2014

AUTHORIZATION TO CONSTRUCT by: Date: 12-11-13 Existing System Inspected by: Date:

Health Dept. Copy - WHITE Applicant (Final Approval) - YELLOW Applicant (Conditional Approval) - PINK