IREDELL COUNTY HEALTH DEPARTMENT

Statesville Office (704) 878-5305 Mooresville Office (704) 660-3625 PERMIT # 180594

IMPROVEMENT PERMIT / AUTHORIZATION TO CONSTRUCT / OPERATION PERMIT / EXISTING SYSTEM

PIN # 4648562829 ✓

APPLICANT: HINCHLEY GAUVAIN APPLICANT ADDRESS: PO Box 3965 MOORESVILLE, NC 28117

SITE ADDRESS: ~~156 PINTO RD~~ MOORESVILLE NC 28117 / 156 Twin Sisters Lane PHONE: ALT. PHONE: 704-237-4822

SITE DIRECTIONS: RT 21(N) - TL CORNELIUS - TL PINTO - ON RT

SUBDIVISION: ~~MAGNOLIA BAY~~ SISTERS COVE SECTION: 3 LOT # 110 LOT AREA: .6AC DESIGN FLOW: 360 L.T.A.R.: .25

Septic Tank	1000	(gal)	STB	794	Date	9/12/16	☑ New System ☐ Repair ☐ Expansion	System Type: I II III (IV) V VI	
Pump Tank	1000	(gal)	PT	283	Date	9/12/16	System Description:	LP PPBPS	
Pump Make	Liberty		Model	290HVS	Serial #		Repair System Description:	LP PPBPS	
# Nitrification Fields	1		# Lines	4	Linear Ft:	260	Maintenance Agreement Required:	☑ YES ☐ NO	
Trench Width	24"		Max. Trench Bottom Depth	36"	Gravel Depth	N/A	☐ GRAVITY	☑ PRESSURE	


☑ Residence ☐ Business ☐ Other ☐ Slab ☐ Basement w/plumbing

No. Bedrooms 3 No. Persons 6 No. Employees ☑ Crawl Space ☐ Basement w/o plumbing

Water Supply: ☐ Private ☐ Public ☑ Community

Comments / Conditions: IF OLD SEPTIC SYSTEM IS EXCAVATED DURING INSTALLATION - PERMIT MAY BE REVOKED. 5-13-16: House is approximately 19' longer (85' deep) vs. the house box dimension (66') as shown/approved below. House must be constructed in exact location proposed by Don Allbrooks & Associates (Plat Dated April 18 2016 - Approved May 13, 2016) Tanks & lines checked 10/27/16 by WS

INITIAL SITE SKETCH

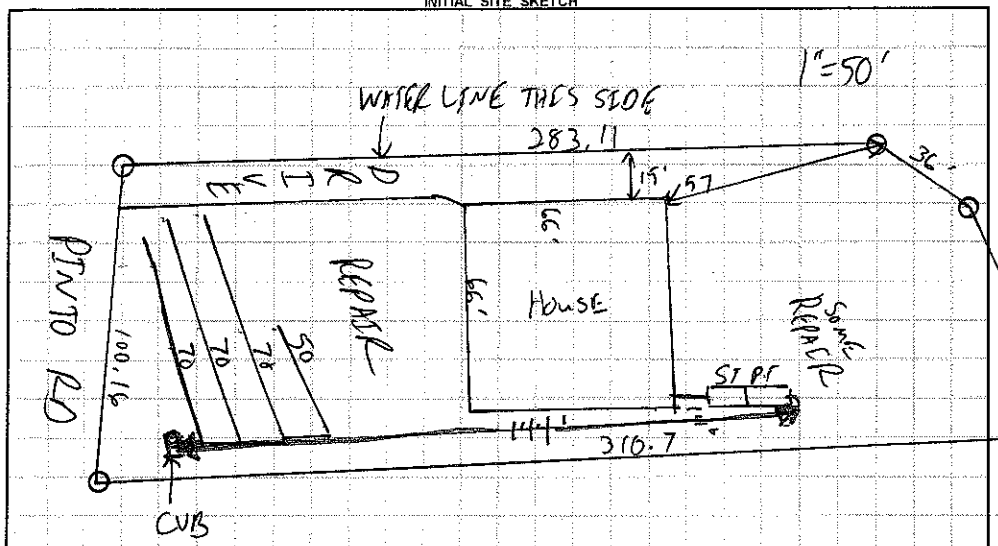

AS BUILT SKETCH

Permit can be suspended or revoked if any false information is supplied toward securing the permit / any unauthorized changes are made to the site / any unauthorized changes are made in the installation of the system. **CONTACT A LOCATOR SERVICE PRIOR TO ANY EXCAVATION**

☐ **IMPROVEMENT PERMIT** ***with plat*** *valid without expiration.* ☑ **IMPROVEMENT PERMIT** ***with site plan*** *valid for 60 mos.* ☐ **AUTHORIZATION TO CONSTRUCT** *valid for period equal to IMPROVEMENT PERMIT--not to exceed 60 mo.*

Owner / Applicant Signature: Date: 10/17/17 Installed by: R+H

IMPROVEMENT PERMIT by: C. Reits Date: 10/7/13 OPERATION PERMIT by: Maria Dotson Date: 11/19/17

AUTHORIZATION TO CONSTRUCT by: Thomas Shuck Date: 5-13-16 Existing System Inspected by: Date:

Health Dept. Copy - WHITE Applicant (Final Approval) - YELLOW Applicant (Conditional Approval) - PINK