3100

IREDELL COUNTY HEALTH DEPARTMENT

Statesville Office (704) 878-5305 Mooresville Office (704) 660-3625 PERMIT # 180590 / 212490

IMPROVEMENT PERMIT / AUTHORIZATION TO CONSTRUCT / OPERATION PERMIT / EXISTING SYSTEM

PIN # 4648574245

APPLICANT: HINCHLEY CALVAIN / Eric Wood APPLICANT ADDRESS: 138 PINTO RD MOORESVILLE NC 28117

SITE ADDRESS: 138 PINTO RD MOORESVILLE NC 28117 PHONE: 704 237-4822 ALT. PHONE: 704 202 1527

SITE DIRECTIONS: 21N - TL COLNELIUS RD - TR PINTO - ON RT


SUBDIVISION: ~~MAGNOLIA BAY~~ SISTER'S COVE SECTION: III LOT # 57 LOT AREA: 1.58ac DESIGN FLOW: ~~360~~ L.T.A.R.: .275

Septic Tank	1000	(gal)	STB	794	Date	5-29-15	☑ New System ☐ Repair ☐ Expansion	System Type: I II III (IV) V VI	☑ Residence	No. Bedrooms	4	Water Supply
Pump Tank	1000	(gal)	PT	27	Date	6-11-15	System Description: CP ABBPS		☐ Business	No. Persons	8	☐ Private
Pump Make	Myers	Model	ME 50	Serial #	220		Repair System Description: CP ABBPS		☐ Other	No. Employees		☐ Public
# Nitrification Fields	1	# Lines	3 @ 97'	Linear Ft:	291		Maintenance Agreement Required: ☑ YES ☐ NO		☐ Slab	☑ Crawl Space		☑ Community
Trench Width	24"	Max. Trench Bottom Depth	36"	Gravel Depth	N/A		☐ GRAVITY ☑ PRESSURE		☐ Basement w/plumbing		☐ Basement w/o plumbing	

Comments / Conditions: IF OLD SEPTIC SYSTEM IS EXCAVATED DURING ~~INSPECTION~~ INSTALLATION PERMIT MAY BE REVOKED.
2/3/15 Reviewed floor plans, house larger but should still fit otherwise in compliance

Must keep house at least 50ft from 760 Contour. Keep Septic System 50ft from lake, 10ft to PL, 15ft side slope of foundation, drain a 25ft upslope of drain

INITIAL SITE SKETCH

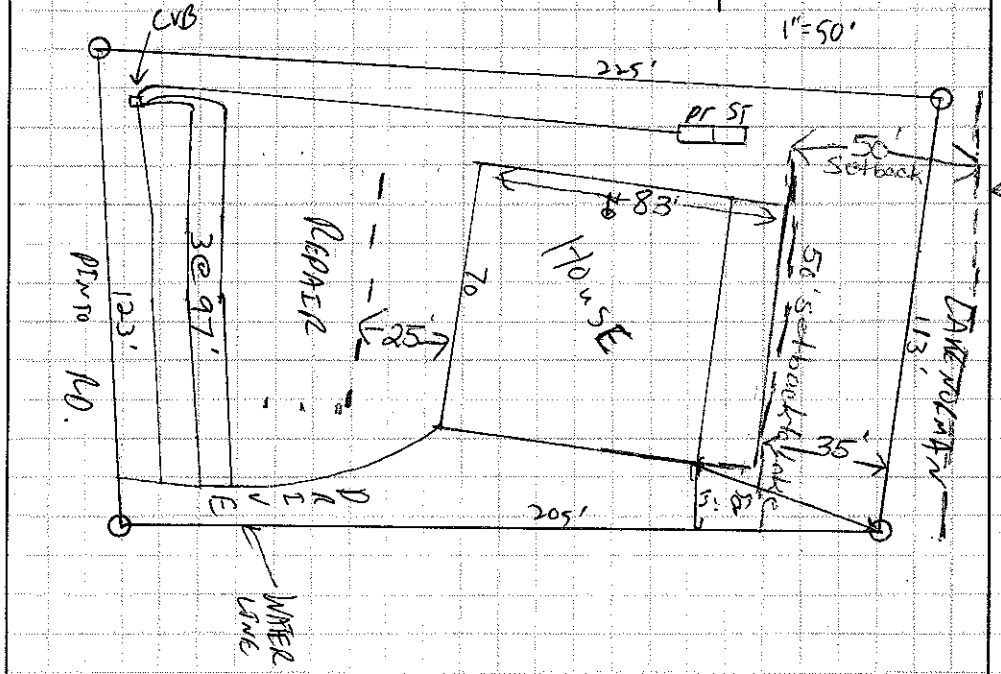

AS BUILT SKETCH

No vehicular traffic over Septic System.
DRIVEWAY / VALVE BOX FLIPPED
CHECKED LINES / TANKS / ~~CVB~~

760 Contour

SEE PLAN FROM PENNINGER SOIL CONSULTING SHOWING APPROVED POOL LOCATION

APPROVED AUG 24 2015

Permit can be suspended or revoked if any false information is supplied toward securing the permit / any unauthorized changes are made to the site / any unauthorized changes are made in the installation of the system. **CONTACT A LOCATOR SERVICE PRIOR TO ANY EXCAVATION**

☐ **IMPROVEMENT PERMIT** *with plat* valid without expiration. ☐ **IMPROVEMENT PERMIT** *with site plan* valid for 60 mos. ☐ **AUTHORIZATION TO CONSTRUCT** valid for period equal to IMPROVEMENT PERMIT--not to exceed 60 mo.

Owner / Applicant Signature: [signature] Date: 10/15/13 Installed by: R&M

IMPROVEMENT PERMIT by: [signature] Date: 10/7/13 OPERATION PERMIT by: Maria Dotson RS Date: 11/12/15

AUTHORIZATION TO CONSTRUCT by: Maria Dotson Date: 2/3/15 Existing System Inspected by: Date:

Health Dept. Copy - WHITE Applicant (Final Approval) - YELLOW Applicant (Conditional Approval) - PINK