IREDELL COUNTY HEALTH DEPARTMENT

Statesville Office (704) 878-5305 Mooresville Office (704) 660-3625 PERMIT # 217895

IMPROVEMENT PERMIT / AUTHORIZATION TO CONSTRUCT / OPERATION PERMIT / EXISTING SYSTEM

PIN # 4648-57-5447

APPLICANT: Carolina Pool Consultants LLC APPLICANT ADDRESS: 4728 Mountain Crk, Denver NC 28037

SITE ADDRESS: 126 Twin Sisters Ln - Mooresville PHONE: 704-728-3520 ALT. PHONE:

SITE DIRECTIONS: Hwy 115 N, TL on Connector, Continue Straight to Cornelius, TL on Twin Sister, Lot on R

SUBDIVISION: Sisters Cove SECTION: 3 LOT # 55 LOT AREA: 0.577 ac DESIGN FLOW: 480 gpd L.T.A.R.: 0.275


Septic Tank	EX.	(gal)	STB		Date		☐ New System	☐ Repair	☐ Expansion	System Type: I II III (IV) V VI	☐ Residence	No. Bedrooms	4	Water Supply	
Pump Tank	EX.	(gal)	PT		Date		System Description:	EX. LP PPBPS			☐ Business	No. Persons	8	☐ Private	
Pump Make		Model			Serial #		Repair System Description:	LP PPBPS			☒ Other Pool	No. Employees		☐ Public	
# Nitrification Fields	EX.	# Lines	EX.		Linear Ft:	EX	Maintenance Agreement Required:	☑ YES	☐ NO		☐ Slab	☐ Crawl Space		☑ Community	
Trench Width	EX	Max. Trench Bottom Depth	EX.		Gravel Depth	N/A		☐ GRAVITY	☑ PRESSURE		☐ Basement w/plumbing		☐ Basement w/o plumbing		

Comments / Conditions:

This permit is for the construction of a 12'x21' pool.

INITIAL SITE SKETCH

AS BUILT SKETCH

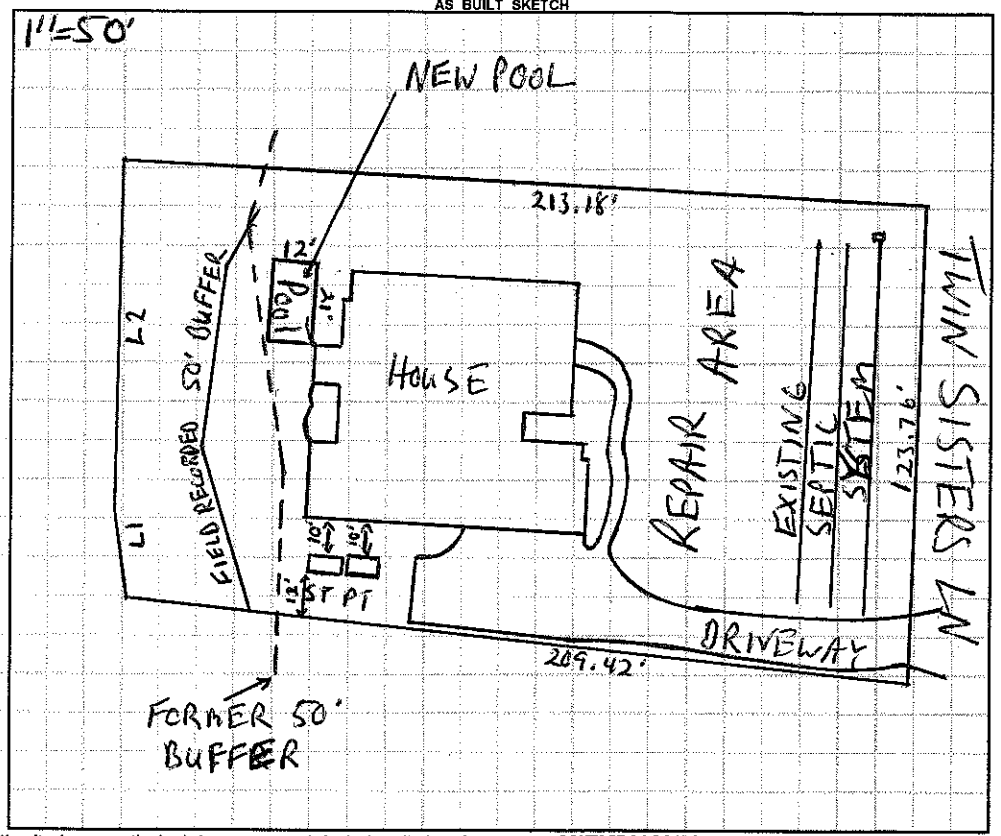

Permit can be suspended or revoked if any false information is supplied toward securing the permit / any unauthorized changes are made to the site / any unauthorized changes are made in the installation of the system. **CONTACT A LOCATOR SERVICE PRIOR TO ANY EXCAVATION**

☐ **IMPROVEMENT PERMIT** ***with plat*** *valid without expiration.* ☐ **IMPROVEMENT PERMIT** ***with site plan*** *valid for 60 mos.* ☐ **AUTHORIZATION TO CONSTRUCT** *valid for period equal to IMPROVEMENT PERMIT--not to exceed 60 mo.*

Owner / Applicant Signature: Nicole Riley Date: 5/5/16 Installed by:

IMPROVEMENT PERMIT by: Date: OPERATION PERMIT by: Date:

AUTHORIZATION TO CONSTRUCT by: Date: Existing System Inspected by: Date: 4-28-16

Health Dept. Copy - WHITE Applicant (Final Approval) - YELLOW Applicant (Conditional Approval) - PINK