4648 615291

IREDELL COUNTY HEALTH DEPARTMENT

STATESVILLE 704-878-5305 MOORESVILLE 704-664-5281

IMPROVEMENT PERMIT / CERTIFICATE OF COMPLETION / OPERATION PERMIT / EXISTING SYSTEM INSPECTION

PROPERTY DESCRIPTION NO. 16611 DATE 7/2/93 TAX MAP NO. 29 A 8

OWNER OR CONTRACTOR CW BROTHERTON PHONE: Business Home

ADDRESS Rt 4 Box 392 Mocksville, NC

LOCATION BLUEFIELD RD, OFF 150W; on (R) JUST PAST CREEK IN FIELD

SUBDIVISION No BLOCK / SECTION LOT No LOT AREA 250' X 360' SITE CLASS. P L.T.A.R. (.25-.3)

Water Supply: ☑ Individual ☐ Community ☐ Public

Septic Tank: 1000 Gallons; STB 358 Date 6-13-92

Pump Tank: Gallons; PT Date

Nitrification Field: No Fields 1 Square Feet 1200 Linear Feet 460

No Lines 4 Trench Width 36" Trench Depth 30" Gravel Depth 12"

☑ New System ☐ Repair System Type: I, (II), III, IV, V, VI

System Description: CONV.

Repair System Description: CONV. - PRESSURE

Maintenance Agreement Required: ☐ Yes ☑ No

☑ House/Mod. Home No. Bedrooms 3 Garbage Disposal: ☐ Yes ☑ No

☐ Mobile Home No. Bathrooms 2 Auto. Dishwasher: ☑ Yes ☐ No


☐ Business No. Employees Auto. Washing Machine: ☑ Yes ☐ No

☐ Other Other


☐ Slab ☑ Crawl Space ☐ Basement w/plumbing ☐ Basement wo/plumbing

Comments

INITIAL SITE SKETCH

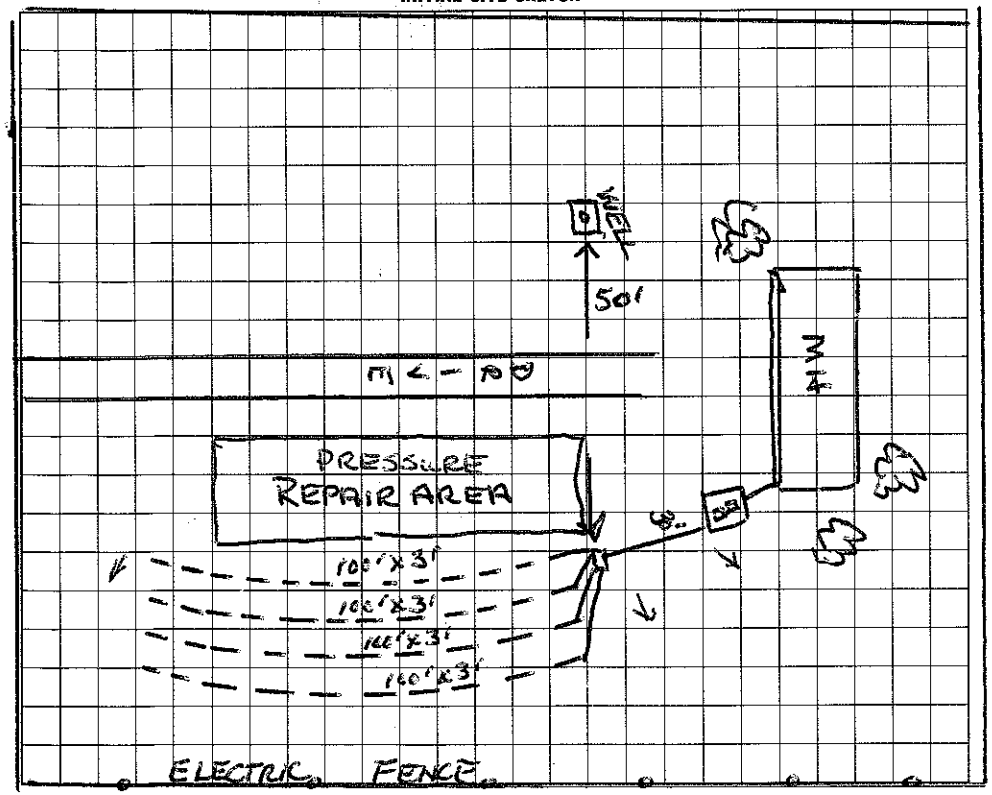

AS BUILT SKETCH

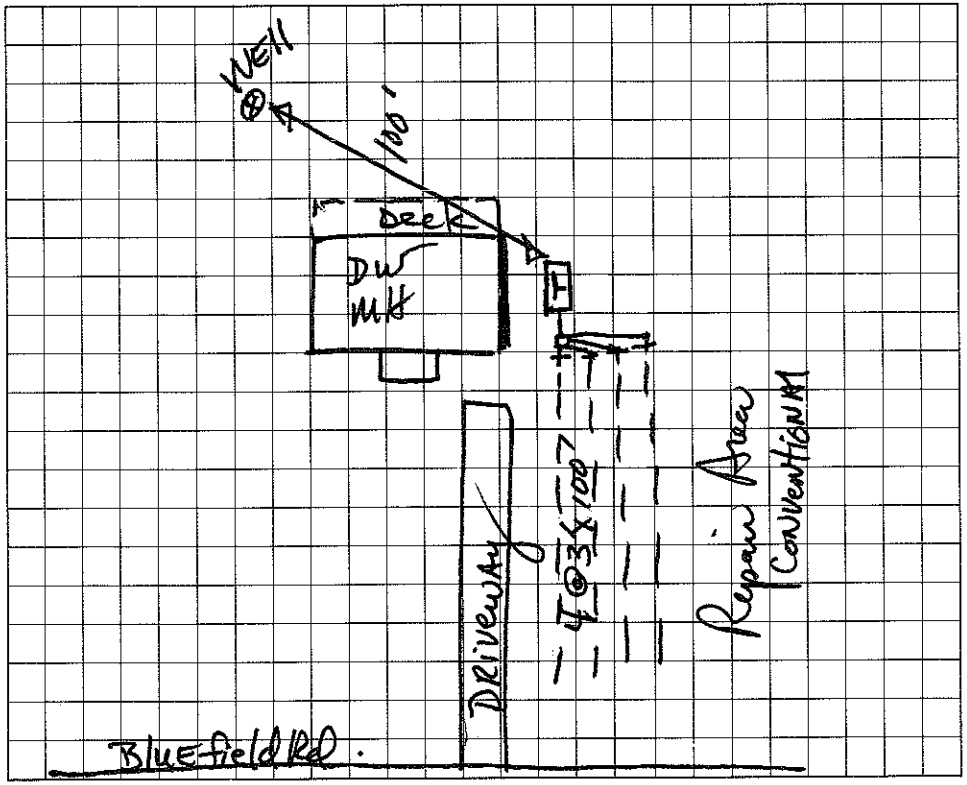

BLUEFIELD RD.

I understand that this permit can be suspended or revoked if any false information is supplied toward securing the permit/any unauthorized changes are made to the site/any unauthorized changes are made in the installation of the system. Improvement Permit is valid for 60 months from date of issuance.

Signed: x Mike Brotherton

Improvement Permit by: Wesley Sparks RS. date 7/2/93

Existing System Inspection by: date

Installed by:

Certificate of Completion by: Janice R Jones, RS date 8/3/93

Operation Permit by: date

HEALTH DEPT. COPY: WHITE INSPECTION COPY (FINAL): GREEN OWNER COPY (FINAL): YELLOW INSPECTION COPY (INITIAL): PINK OWNER COPY (INITIAL): GOLD