IREDELL COUNTY HEALTH DEPARTMENT

STATESVILLE 704-878-5305 MOORESVILLE 704-664-5281

IMPROVEMENT PERMIT / AUTHORIZATION TO CONSTRUCT / OPERATION PERMIT / EXISTING SYSTEM INSPECTION

PERMIT# 126368 PIN# ~~4648 86 8336~~ 4648867370 DATE 2/24/05

OWNER OR CONTRACTOR Theresa Newton PHONE: Business 704 363-6864 Home

ADDRESS 525 Shepherd Rd Troutman NC 28166

LOCATION 2.1 N. TL Cornelius Rd, On Rt at Dorothy Ln,

SUBDIVISION BLOCK / SECTION LOT LOT AREA 1.313 AC SITE CLASS PS DESIGN FLOW 480 L.T.A.R. 0.3

Septic Tank: 1000 Gallons; STB 1012 Date 5/21/05

Pump Tank: Gallons; PT Date

Pump Make: Model Serial No. 400

Nitrification Field: No Fields 1 Square Feet ~~1600~~ Linear Feet ~~535~~

No Lines ~~5 Chambers~~ Trench Width 36" Max Trench Bottom Depth 36" Gravel Depth 12"

☒ New System ☐ Repair System Type: I, (II), III, IV, V, VI

System Description: Gravity Conventional

Repair System Description: Pump Innovative

Maintenance Agreement Required: ☐ Yes ☒ No

☐ House/Mod. Home No. Bedrooms 4

☒ Mobile Home No. Bathrooms

☐ Business No. Employees

☐ Other

☐ Slab ☒ Crawl Space ☐ Basement w/plumbing ☐ Basement wo/plumbing


Water Supply: ☒ Individual ☐ Public ☐ Community

Comments:/Conditions:


1" = 50'

Comments:/Conditions:

INITIAL SITE SKETCH

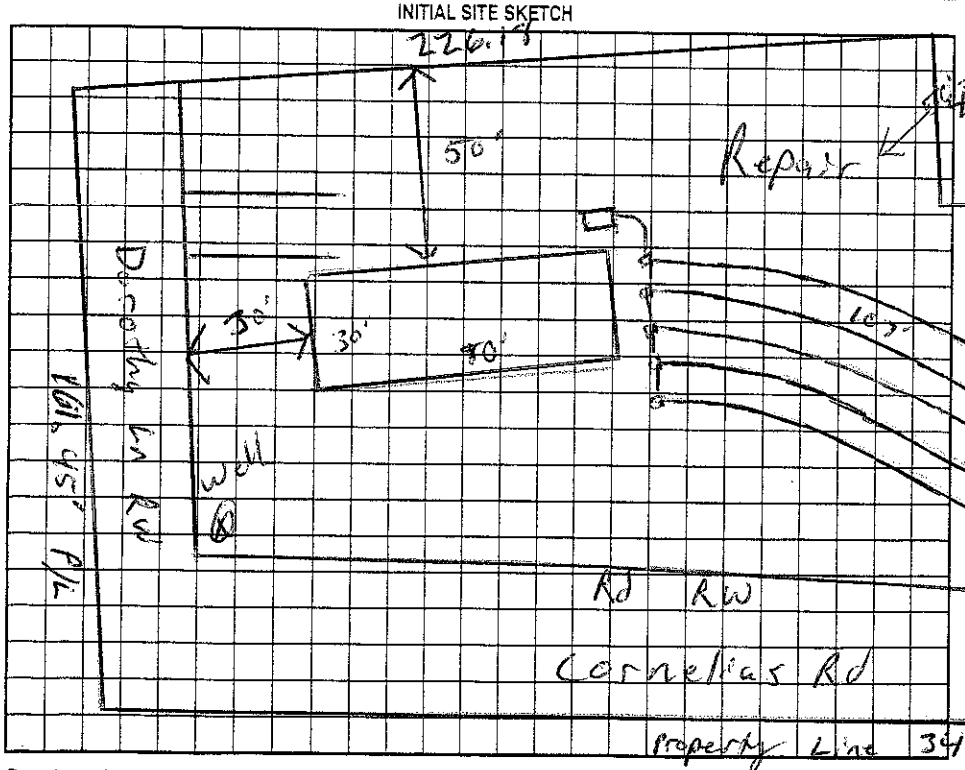

AS BUILT SKETCH

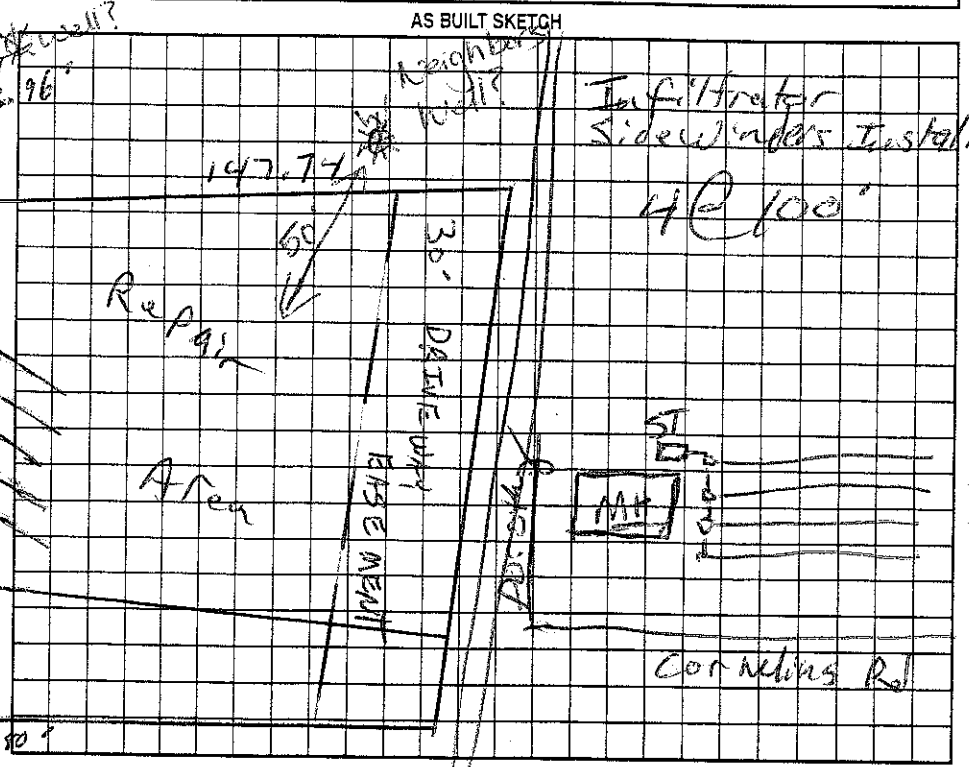

Permit can be suspended or revoked if any false information is supplied toward securing the permit/any unauthorized changes are made to the site/any unauthorized changes are made in the installation of the system. Improvement Permit with plat valid without expiration. Improvement Permit with site plan valid for sixty months. Authorization to Construct is valid for a period equal to that of Improvement Permit – not to exceed sixty months.

Signed: Theresa Newton date

Improvement Permit by: RS date 2/24/05

Authorization to Construct by: RS date 12/9/05

Installed by: Craig Thompson

Operation Permit by: RS date 1/10/06

Existing System Inspection by: date

HEALTH DEPT. COPY: WHITE OWNER COPY (FINAL): YELLOW OWNER COPY (INITIAL): PINK