IREDELL COUNTY HEALTH DEPARTMENT

STATESVILLE 704-878-5305 ∅ MOORESVILLE 704-664-5281

IMPROVEMENT PERMIT / AUTHORIZATION TO CONSTRUCT / OPERATION PERMIT / EXISTING SYSTEM INSPECTION

PERMIT# 126367 PIN# ~~4648 86 8356.000~~ 4648 86 8485 DATE 2/24/05

OWNER OR CONTRACTOR Theresa Newton PHONE: Business 704 363-6964 Home

ADDRESS 525 Shepherds Rd ~~Mocksville~~ Troutman NC 28166

LOCATION 2 N, TL Cornelius Rd, TR Dorothy on Rt.

SUBDIVISION BLOCK / SECTION LOT LOT AREA 0.945ac SITE CLASS. PS DESIGN FLOW 360 ~~480~~ L.T.A.R. 0.3

Septic Tank: 1000 Gallons; STB 1012 Date 1-22-05

Pump Tank: Gallons; PT Date

Pump Make: Model 1200 Serial No. 400

Nitrification Field: No Fields 1 Square Feet 1005 Linear Feet 535

No Lines ~~5 @ 107'~~ 4 @ 100' Trench Width 36" Max Trench Bottom Depth 36" Gravel Depth 12"

☒ New System ☐ Repair System Type: I (II) III IV V VI

System Description: Gravity Conventional

Repair System Description: 25% Reduction

Maintenance Agreement Required: ☐ Yes ☒ No

☐ House/Mod. Home ☒ Mobile Home ☐ Business ☐ Other

No. Bedrooms 4 No. Bathrooms No. Employees


☐ Slab ☒ Crawl Space ☐ Basement w/plumbing ☐ Basement wo/plumbing

Water Supply: ☒ Individual ☐ Public ☐ Community


Comments:/Conditions: Reviewed Floor plans, in compliance with I.P. 1"=50'

Comments:/Conditions: Note: May need to install 25% Reduction Drainfield if house moved further back. Note: House not set up at time of inspection.

INITIAL SITE SKETCH

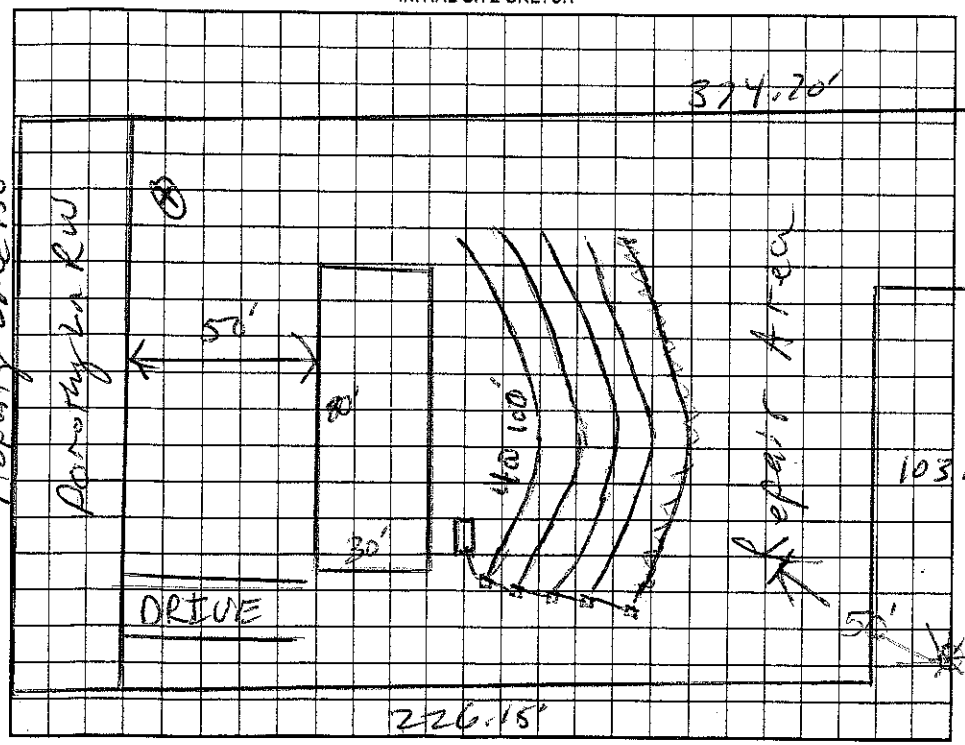

AS BUILT SKETCH

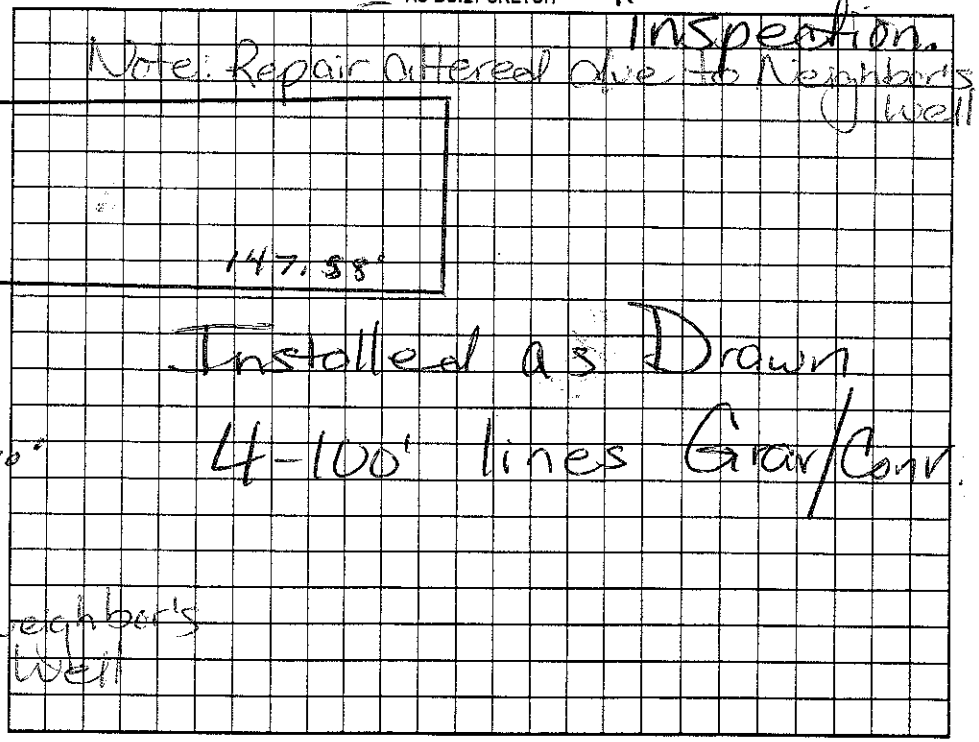

Permit can be suspended or revoked if any false information is supplied toward securing the permit/any unauthorized changes are made to the site/any unauthorized changes are made in the installation of the system. Improvement Permit with plat valid without expiration. Improvement Permit with site plan valid for sixty months. Authorization to Construct is valid for a period equal to that of Improvement Permit – not to exceed sixty months.

Signed: Theresa Newton date

Improvement Permit by: RS date 2/24/05

Authorization to Construct by: Maria H. Dotson RS date 7/19/05

Installed by: Craig Thompson RS

Operation Permit by: Maria H. Dotson date 7/25/05

Existing System Inspection by: date

HEALTH DEPT. COPY: WHITE OWNER COPY (FINAL): YELLOW OWNER COPY (INITIAL): PINK