IREDELL COUNTY HEALTH DEPARTMENT

74343 ~~74334~~ (3:30 - 4:00)

STATESVILLE 704-878-5305 MOORESVILLE 704-664-5281

IMPROVEMENT PERMIT / AUTHORIZATION TO CONSTRUCT / OPERATION PERMIT / EXISTING SYSTEM INSPECTION

PERMIT# 074343 PIN# 4648869089 DATE 6/15/98

OWNER OR CONTRACTOR EASTWAY INC PHONE: Business _____ Home 664-5755

ADDRESS PO BOX 733 MOORESVILLE NC 28115

LOCATION 200 - I-N - TL CORNELIUS - 1 MILE ON RT

SUBDIVISION — BLOCK / SECTION — LOT — LOT AREA .81 AC SITE CLASS. RS DESIGN FLOW 240GPD L.T.A.R. .36GPD/FT

Septic Tank: 1000 Gallons; STB 101 Date 6/17/98
Pump Tank: _____ Gallons; PT _____ Date _____
Pump Make: _____ Model _____ Serial No. _____
Nitrification Field: No Fields 1 Square Feet 810 Linear Feet 270
No Lines 3@67' Trench Width 36" Max Trench Bottom Depth 36" Gravel Depth N/A

☑ New System ☐ Repair System Type: I (II) III, IV, V, VI
System Description: GRAVITY CONVENTIONAL
Repair System Description: GRAVITY PANEL
Maintenance Agreement Required: ☐ Yes ☑ No


☑ House/Mod. Home No. Bedrooms 3
☐ Mobile Home No. Bathrooms 2
☐ Business No. Employees ____
☐ Other _____
☐ Slab ☑ Crawl Space ☐ Basement w/plumbing ☐ Basement wo/plumbing

Water Supply:
☑ Individual
☐ Public
☐ Community

Comments:/Conditions:

Comments:/Conditions:

INITIAL SITE SKETCH

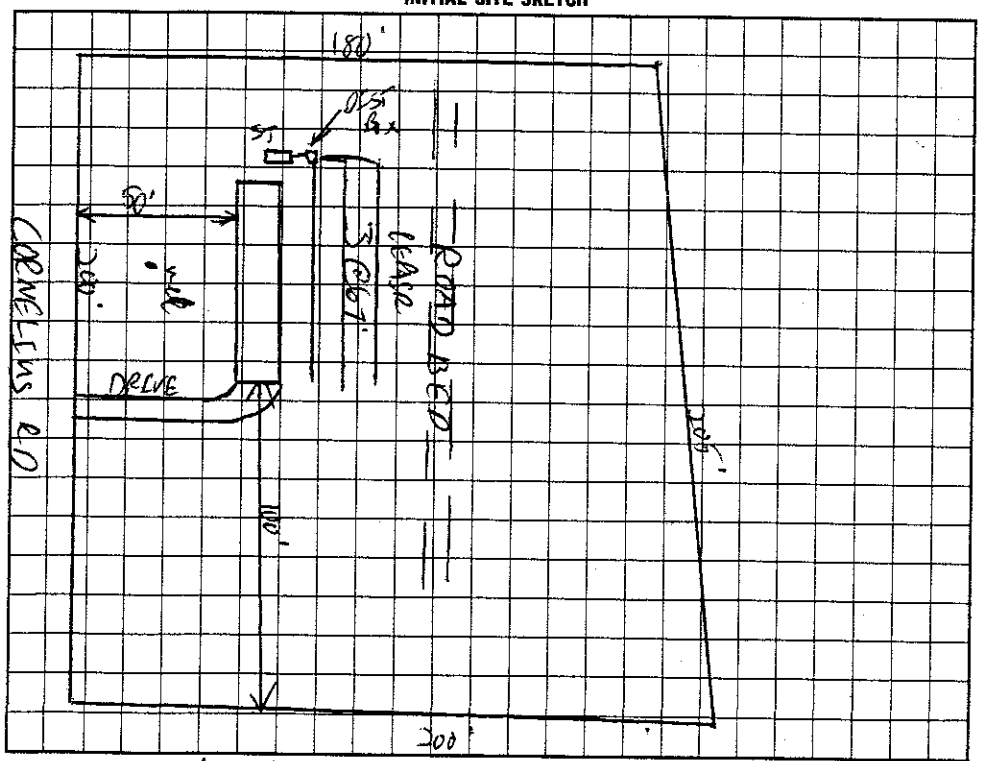

AS BUILT SKETCH

I understand that this permit can be suspended or revoked if any false information is supplied toward securing the permit/any unauthorized changes are made to the site/any unauthorized changes are made in the installation of the system. Improvement Permit with plat valid without expiration. Improvement Permit with site plan valid for sixty months. Authorization to Construct is valid for a period equal to that of Improvement Permit – not to exceed sixty months.

Signed: _____ date 6-15-98 Installed by: A1 BACKHOE

Improvement Permit by: C _____ RS date _____ Operation Permit by: C _____ RS date 8/17/98

Authorization to Construct by: C _____ RS date _____ Existing System Inspection by: _____ date _____

HEALTH DEPT. COPY: WHITE INSPECTION COPY (FINAL): GREEN OWNER COPY (FINAL): YELLOW INSPECTION COPY (INITIAL): PINK OWNER COPY (INITIAL): GOLD