IREDELL COUNTY HEALTH DEPARTMENT

STATESVILLE 704-878-5305 MOORESVILLE 704-664-5281

Paid 175.00 CK

IMPROVEMENT PERMIT / AUTHORIZATION TO CONSTRUCT / OPERATION PERMIT / EXISTING SYSTEM INSPECTION

PERMIT# 088144 PIN# 4648 97 6378 DATE 3/23/00

OWNER OR CONTRACTOR Larry Upright PHONE: Business 662-6201 Home

ADDRESS 146 Accent Loop Mooresville, NC. 28117

LOCATION 21N TL Connelly Rd TR Dorothy Ln. to 2ND gravel road on (L) to rear lot.

SUBDIVISION WOODHILLS BLOCK / SECTION LOT 4 LOT AREA ~1.1 Ac SITE CLASS. PS DESIGN FLOW 360 L.T.A.R. .25

Septic Tank: 1000 Gallons; STB 875 Date 3/7/00

Pump Tank: 1000 Gallons; PT 302 Date 4/5/00

Pump Make: Model Serial No.

Nitrification Field: No Fields 1 Square Feet 1080 Linear Feet 360

No Lines 6@60' x 3' Trench Width 36" Max Trench Bottom Depth 32"

[X] New System [ ] Repair System Type: I, II, (III), IV, V, VI

System Description: ~~Pressure~~ EZLAY or CH-PLAS.

Repair System Description: Same

Maintenance Agreement Required: [ ] Yes [ ] No

[X] House/Mod. Home No. Bedrooms 3

[ ] Mobile Home No. Bathrooms 2

[ ] Business No. Employees

[ ] Other

[ ] Slab [ ] Crawl Space [ ] Basement w/plumbing [ ] Basement wo/plumbing

Water Supply: [X] Individual [ ] Public [ ] Community


Comments/Conditions: Saprolite mixture 100' separation required between Well and any part of Septic Tank System.

5 Lines


(Lines, Tanks)

Comments/Conditions:

INITIAL SITE SKETCH (1"=50')

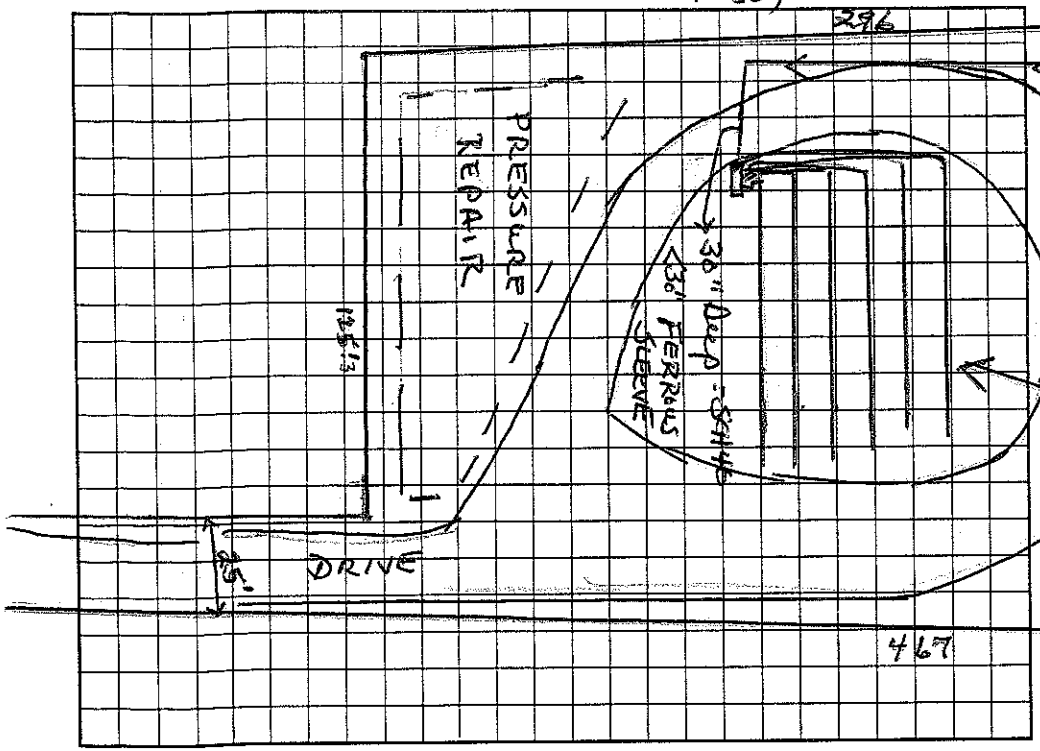

AS BUILT SKETCH

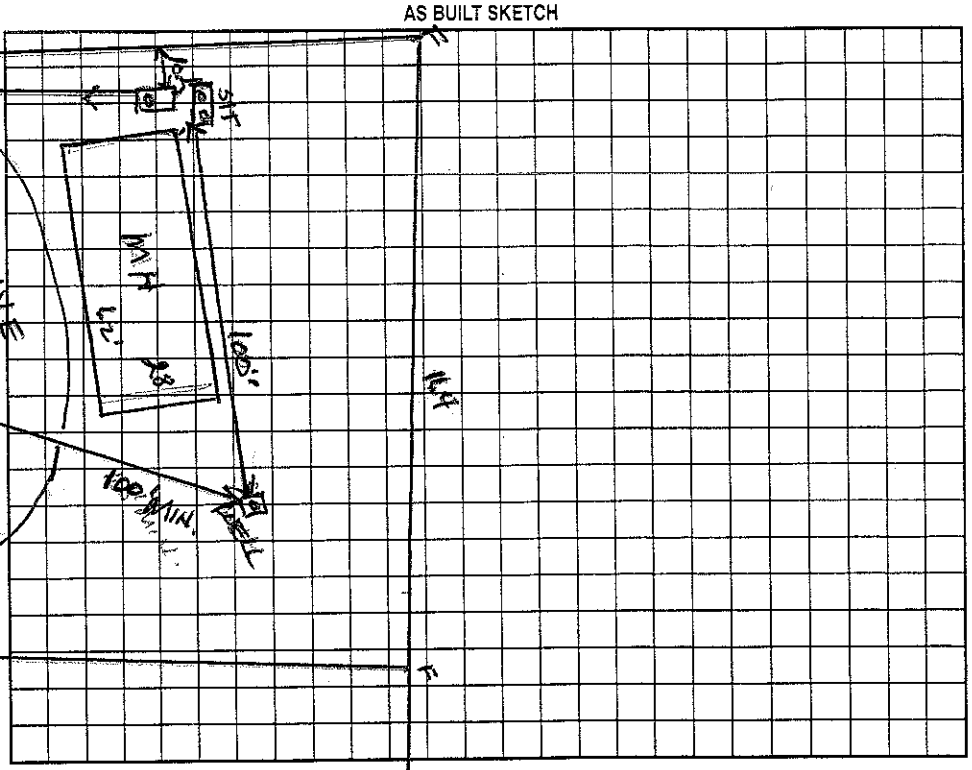

Permit can be suspended or revoked if any false information is supplied toward securing the permit/any unauthorized changes are made to the site/any unauthorized changes are made in the installation of the system. Improvement Permit with plat valid without expiration. Improvement Permit with site plan valid for sixty months. Authorization to Construct is valid for a period equal to that of Improvement Permit – not to exceed sixty months.

Signed: Wesley McDonnell date 3-28-00

Improvement Permit by: Wesley Sparks RS. date 3/23/00

Authorization to Construct by: Wesley Sparks RS. date 3/23/00

Installed by: ROWAN SEPTIC

Operation Permit by: C. Ny Thomas date 4/5/00

Existing System Inspection by: date

HEALTH DEPT. COPY: WHITE OWNER COPY (FINAL): YELLOW OWNER COPY (INITIAL): PINK