IREDELL COUNTY HEALTH DEPARTMENT

...VILLE 704-878-5305 MOORESVILLE 704-664-5281

IMPROVEMENT PERMIT / AUTHORIZATION TO CONSTRUCT / OPERATION PERMIT / EXISTING SYSTEM INSPECTION

PERMIT# 088101 PIN# 4648 87 7683 DATE 3/13/00

OWNER OR CONTRACTOR Piedmont Housing PHONE: Business 489-1113 Home

ADDRESS 3697 N Hwy 16

LOCATION 21N TL Connelly Rd. TR Dorothy Lane to last lot on (L)

SUBDIVISION Woodhills BLOCK / SECTION LOT 6 LOT AREA .89 Ac SITE CLASS PS DESIGN FLOW 480 L.T.A.R. .3

Septic Tank: 1000 Gallons; STB 9821 Date 2/23/00
Pump Tank: Gallons; PT Date
Pump Make: Model Serial No.
Nitrification Field: No Fields 1 Square Feet 1596 Linear Feet 532
No Lines 4@133'x3' Trench Width 36" Max Trench Bottom Depth 36" Gravel Depth 12"

[X] New System [ ] Repair System Type: I, (II), III, IV, V, VI
System Description: Gravity - Conventional
Repair System Description: Same
Maintenance Agreement Required: [ ] Yes [X] No

[X] House/Mod. Home No. Bedrooms 4
[ ] Mobile Home No. Bathrooms 2.5
[ ] Business No. Employees
[ ] Other


[ ] Slab [X] Crawl Space [ ] Basement w/plumbing [ ] Basement wo/plumbing

Water Supply: [X] Individual [ ] Public [ ] Community


Comments:/Conditions:

Comments:/Conditions:

INITIAL SITE SKETCH (1 = 50')

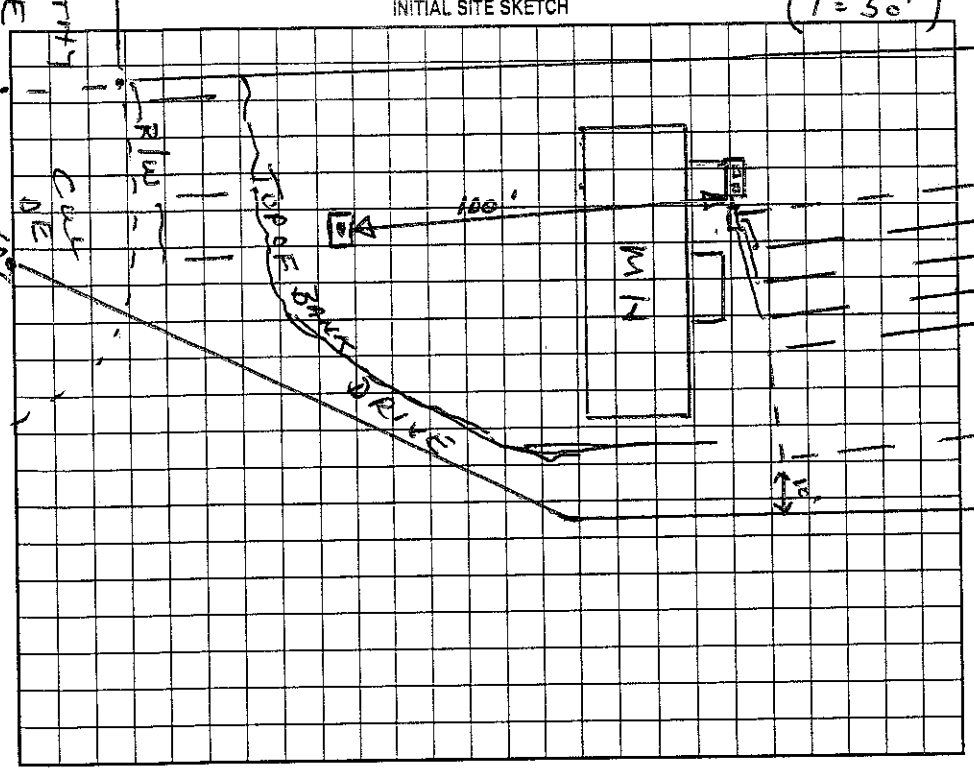

AS BUILT SKETCH

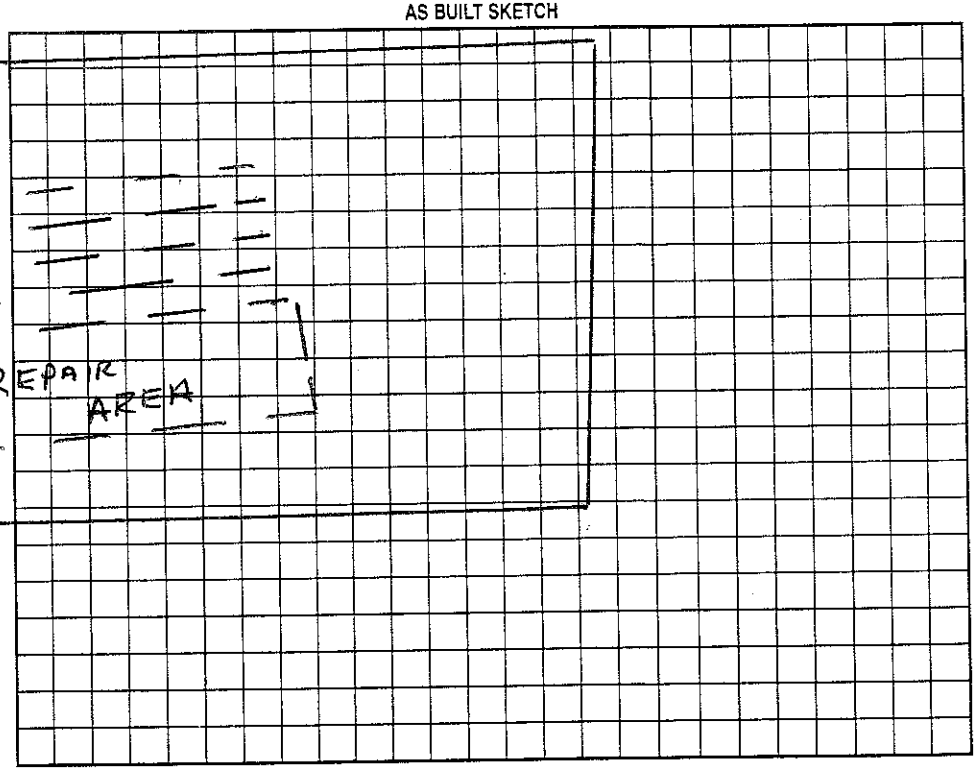

Permit can be suspended or revoked if any false information is supplied toward securing the permit/any unauthorized changes are made to the site/any unauthorized changes are made in the installation of the system. Improvement Permit with plat valid without expiration. Improvement Permit with site plan valid for sixty months. Authorization to Construct is valid for a period equal to that of Improvement Permit – not to exceed sixty months.

Signed: X date 3/15/00 Installed by: Foothills Grading

Improvement Permit by: Wesley Sparks RS. date 3/15/00 Operation Permit by: Wesley Sparks RS. date 4/8/00

Authorization to Construct by: Wesley Sparks RS. date 3/15/00 Existing System Inspection by: date

HEALTH DEPT. COPY: WHITE OWNER COPY (FINAL): YELLOW OWNER COPY (INITIAL): PINK