# IREDELL COUNTY HEALTH DEPARTMENT

STATESVILLE 704-878-5305 MOORESVILLE 704-664-5281

## IMPROVEMENT PERMIT / AUTHORIZATION TO CONSTRUCT / OPERATION PERMIT / EXISTING SYSTEM INSPECTION

PERMIT# 11256 PIN# 4648 87 8723.000 DATE 6/14/06

OWNER OR APPLICANT J KENNETH GRANT PHONE: Business _____ Home _____

ADDRESS 111 BRISTOL RD. STATESVILLE,

LOCATION 115-21 N TO CORNELIUS TR DOROTHY LN.

SUBDIVISION WOOD HILL BLOCK / SECTION _____ LOT 7 LOT AREA 2.02 SITE CLASS. PS DESIGN FLOW _____ L.T.A.R. 3

Septic Tank: 1000 Gallons; STB 825 Date 6/7/06

Pump Tank: _____ Gallons; PT _____ Date _____

Pump Make: _____ Model _____ Serial No. _____

Nitrification Field: No. Fields 1 Square Feet 900 Linear Feet 300

No Lines 4@75 Trench Width 3' Max Trench Bottom Depth 3'

☒ New System ☐ Repair ☐ Expansion System Type: I II (III) IV V VI

System Description: GRAVITY - 25% REDUCTION

Repair System Description: GRAVITY - PP3PS

Maintenance Agreement Required: ☐ Yes ☒ No

☒ House/Mod. Home ☐ Mobile Home ☐ Business ☐ Other

No. Bedrooms 2 No. Persons 2 No. Employees ____


Water Supply: ☐ Individual ☐ Public ☐ Community

Gravel Depth No ☒ Gravity ☐ Pressure ☒ Slab ☐ Crawl Space ☐ Basement w/plumbing ☐ Basement wo/plumbing


Comments:/Conditions:

Comments:/Conditions:

INITIAL SITE SKETCH

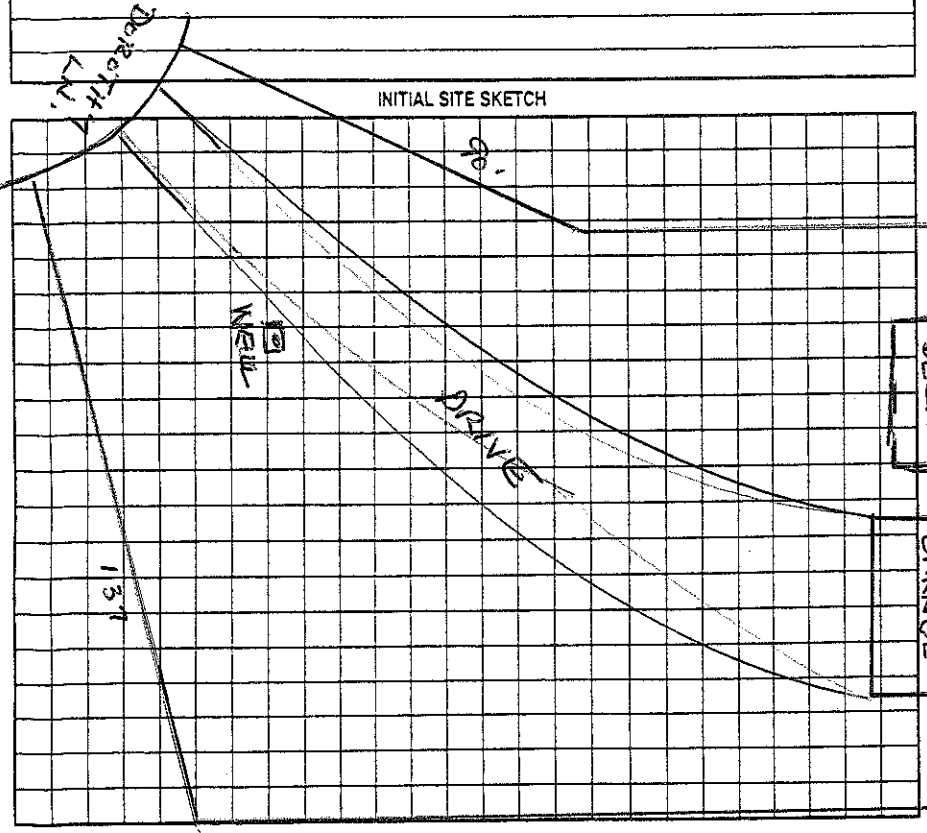


AS BUILT SKETCH

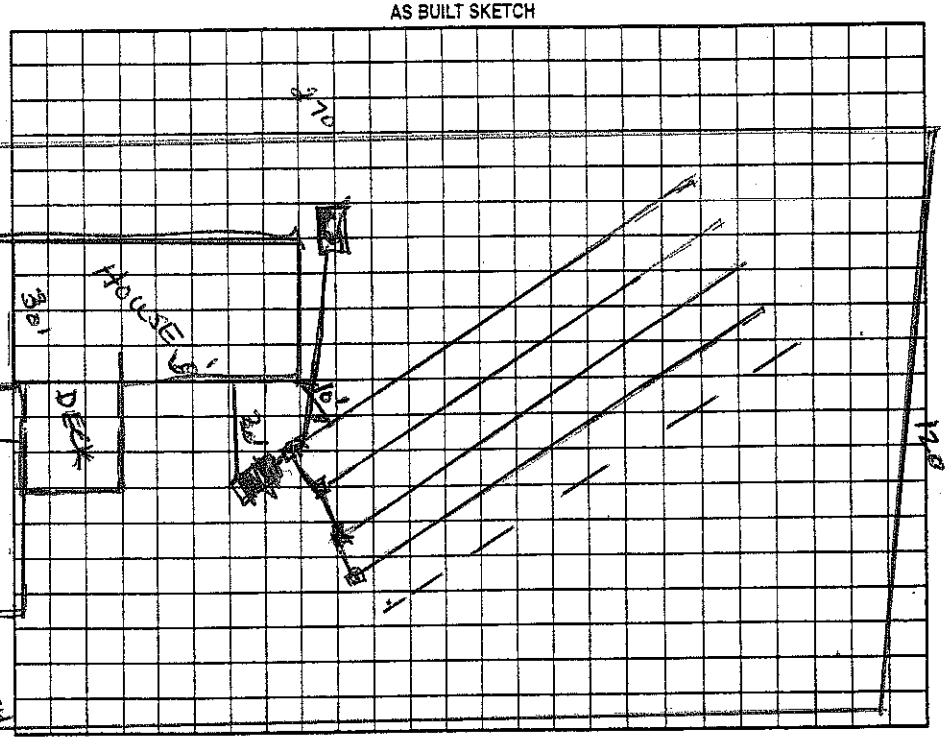


Permit can be suspended or revoked if any false information is supplied toward securing the permit/any unauthorized changes are made to the site/any unauthorized changes are made in the installation of the system. Improvement Permit with plat valid without expiration ☐ Improvement Permit with site plan valid for sixty months ☐ Authorization to Construct is valid for a period equal to that of Improvement Permit – not to exceed sixty months.

Signed: X J. Kenneth Grant date 07-25-06 Installed by: JOE THOMPSON

Improvement Permit by: Wesley Sparks RS date 6/14/06 Operation Permit by: Wesley Sparks RS. date _____

Authorization to Construct by: Wesley Sparks RS date 6/14/06 Existing System Inspection by: _____ date _____

HEALTH DEPT. COPY: WHITE OWNER COPY (FINAL): YELLOW OWNER COPY (INITIAL): PINK