IREDELL COUNTY HEALTH DEPARTMENT

STATESVILLE 704-878-5305 MOORESVILLE 704-664-5287

IMPROVEMENT PERMIT / AUTHORIZATION TO CONSTRUCT / OPERATION PERMIT / EXISTING SYSTEM INSPECTION

PERMIT# 088238 PIN# 4648 87 9115 DATE 3/30/00

OWNER OR CONTRACTOR Oakwood Homes. PHONE: Business 528-4516 Home

ADDRESS Troutman, NC. 28166

LOCATION Dorothy Ln. Cornelius Rd. TR Dorothy home to first cleared lot on (L) 480

SUBDIVISION Wood Hills BLOCK / SECTION LOT 1 LOT AREA 21786 FT² SITE CLASS. PS DESIGN FLOW ~~360~~ L.T.A.R. .3

Septic Tank: 1000 Gallons; STB 312 Date 10/8/99
Pump Tank: Gallons; PT Date
Pump Make: Model Serial No.
Nitrification Field: No Fields 1 Square Feet 1200 Linear Feet 400
No Lines 4 Trench Width 36" Max Trench Bottom Depth 36"

☒ New System ☐ Repair System Type: I, II, (III) IV, V, VI
System Description: GRAVITY - HDS of PLASTIC CHAM
Repair System Description: 16" PPBS
Maintenance Agreement Required: ☐ Yes ☒ No

☒ House/Mod. Home No. Bedrooms 4
☐ Mobile Home No. Bathrooms 3
☐ Business No. Employees
☐ Other

~~Gravel Depth~~ SAND ☐ Slab ☐ Crawl Space ☐ Basement w/plumbing ☐ Basement wo/plumbing


Water Supply: ☒ Individual ☐ Public ☐ Community

Comments:/Conditions:

(1" = 40')

Comments:/Conditions:

INITIAL SITE SKETCH

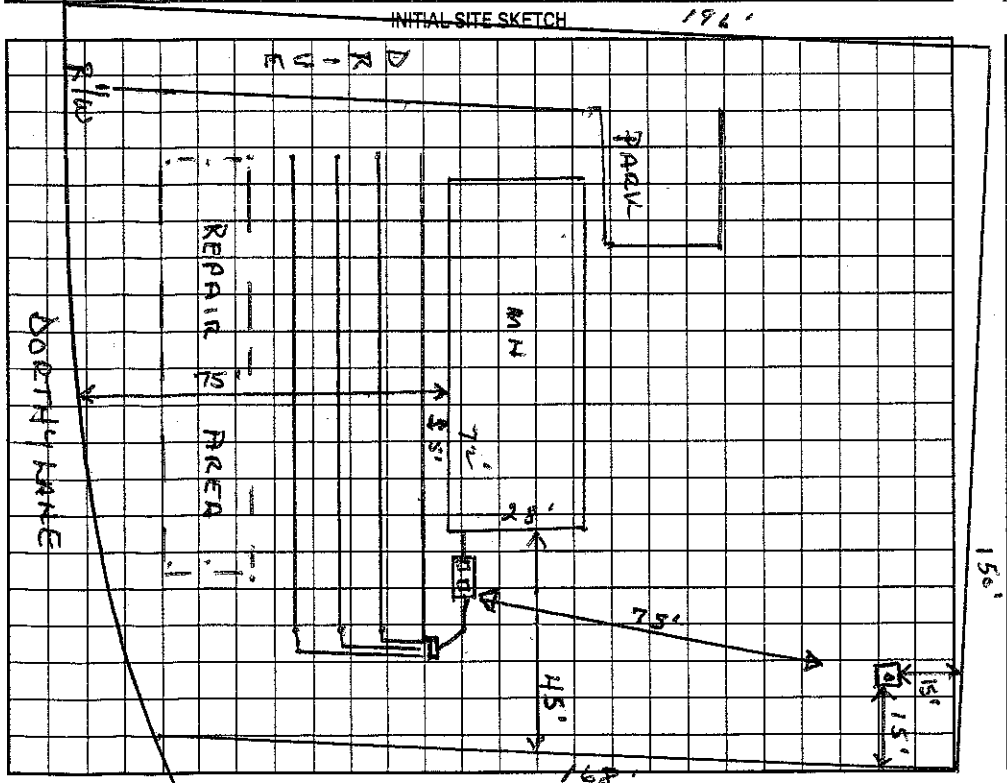

AS BUILT SKETCH

Permit can be suspended or revoked if any false information is supplied toward securing the permit/any unauthorized changes are made to the site/any unauthorized changes are made in the installation of the system. Improvement Permit with plat valid without expiration. Improvement Permit with site plan valid for sixty months. Authorization to Construct is valid for a period equal to that of Improvement Permit – not to exceed sixty months.

Signed: * date 4/3/00

Improvement Permit by: Wesley Sparks R.S. date 3/30/00

Authorization to Construct by: Wesley Sparks R.S. date 3/30/00

Installed by: Michael Tucker - 873-2417

Operation Permit by: Wesley Sparks R.S. date 5/5/00

Existing System Inspection by: date

HEALTH DEPT. COPY: WHITE OWNER COPY (FINAL): YELLOW OWNER COPY (INITIAL): PINK