# IREDELL COUNTY HEALTH DEPARTMENT

STATESVILLE 704-878-5305 MOORESVILLE 704-664-5281

## IMPROVEMENT PERMIT / AUTHORIZATION TO CONSTRUCT / OPERATION PERMIT / EXISTING SYSTEM INSPECTION

PERMIT# 79094 PIN# 4648879313 DATE 4/12/99

OWNER OR CONTRACTOR RAYNELL FRYE PHONE: Business Home 933-3055

ADDRESS 7600 KARRICKER RD. KANNAPOLIS NC 28081

LOCATION 21 N. TO CONNELLYS TR DORTHY LN - 0.9 LT

SUBDIVISION WOOD HILLS BLOCK / SECTION LOT 3 LOT AREA .56 AC SITE CLASS. 1S DESIGN FLOW 360 L.T.A.R. -3

Septic Tank: 1000 Gallons; STB 312 Date 12/14/99

Pump Tank: Gallons; PT Date

Pump Make: Model Serial No.

Nitrification Field: No. Fields 1 Square Feet 900 Linear Feet 300

No. Lines 4@75' Trench Width 36" Max Trench Bottom Depth 36" Gravel Depth N/A

☒ New System ☐ Repair System Type: I, II, III, IV, V, VI

System Description: GR4 0274 @ 25% Reduction

Repair System Description: SAME

Maintenance Agreement Required: ☐ Yes ☒ No

☒ House/Mod. Home No. Bedrooms 3

☐ Mobile Home No. Bathrooms 2

☐ Business No. Employees

☐ Other


☐ Slab ☒ Crawl Space ☐ Basement w/plumbing ☐ Basement wo/plumbing

Water Supply: ☒ Individual ☐ Public ☐ Community

Comments:/Conditions:

Comments:/Conditions:

INITIAL SITE SKETCH

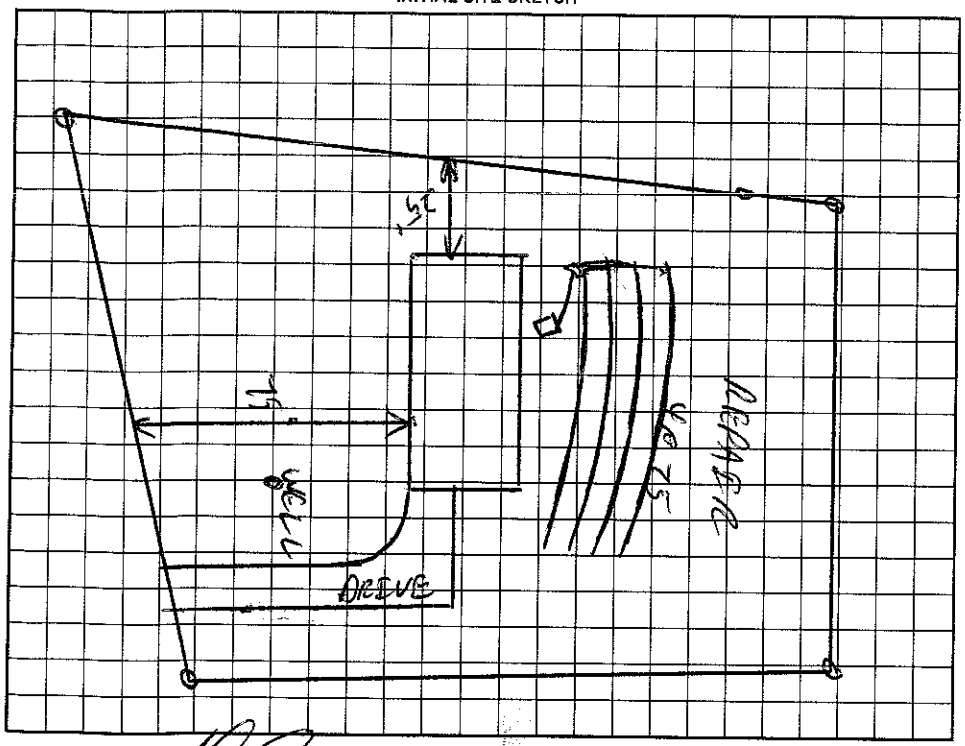


AS BUILT SKETCH

Permit can be suspended or revoked if any false information is supplied toward securing the permit/any unauthorized changes are made to the site/any unauthorized changes are made in the installation of the system. Improvement Permit with plat valid without expiration. Improvement Permit with site plan valid for sixty months. Authorization to Construct is valid for a period equal to that of Improvement Permit – not to exceed sixty months.

Signed: date 8-18-99 Installed by: Craig Thompson

Improvement Permit by: RS date 4/12/99 Operation Permit by: Wesley Sparks RS. date 3/27/00

Authorization to Construct by: RS date 4/12/99 Existing System Inspection by: date

HEALTH DEPT. COPY: WHITE OWNER COPY (FINAL): YELLOW OWNER COPY (INITIAL): PINK