IREDELL COUNTY HEALTH DEPARTMENT

STATESVILLE 704-878-5305 / 30.00 Paid MOORESVILLE 704-664-5281

IMPROVEMENT PERMIT / AUTHORIZATION TO CONSTRUCT / OPERATION PERMIT / EXISTING SYSTEM INSPECTION

PERMIT# 122018 PIN# 4648 95 6847 DATE 7/26/04

OWNER OR CONTRACTOR Kingdom Hall of Jehovah's Witnesses PHONE: Business 704-799-9442 Home

ADDRESS 760 Big Shoal Loop. Mooresville, NC. 28117

LOCATION 21N to Cornelius Rd. TR Olympic Dr., first tract on L

SUBDIVISION Cornelius Estates BLOCK / SECTION LOT 45 LOT AREA 4 Ac SITE CLASS. PS DESIGN FLOW 600 L.T.A.R. .3

Septic Tank: 1500 Gallons; STB 62 Date 10/7/04

Pump Tank: 1500 Gallons; PT 202/357 Date

Pump Make: Zoeller Model M152 Serial No. 7/04

Nitrification Field: No Fields 1 Square Feet 1500 Linear Feet 500

No Lines 6@83' Trench Width 3' Max Trench Bottom Depth 30" Gravel Depth No

☒ New System ☐ Repair System Type: I, II, III, IV, V, VI

System Description: PressMan → Type 3 (25% Red)

Repair System Description: Same

Maintenance Agreement Required: ☐ Yes ☒ No

☐ House/Mod. Home No. Bedrooms

☐ Mobile Home No. Bathrooms

☐ Business No. Employees

☒ Other CHURCH - 187 - 561 GPD

☒ Slab ☐ Crawl Space ☐ Basement w/plumbing ☐ Basement wo/plumbing


Water Supply: ☒ Individual ☐ Public ☐ Community

Comments:/Conditions: 495

11/10/04 Lines, tanks & pressure checked by W.S


SCH 40 PVC - PRESSURE RATED

INITIAL SITE SKETCH

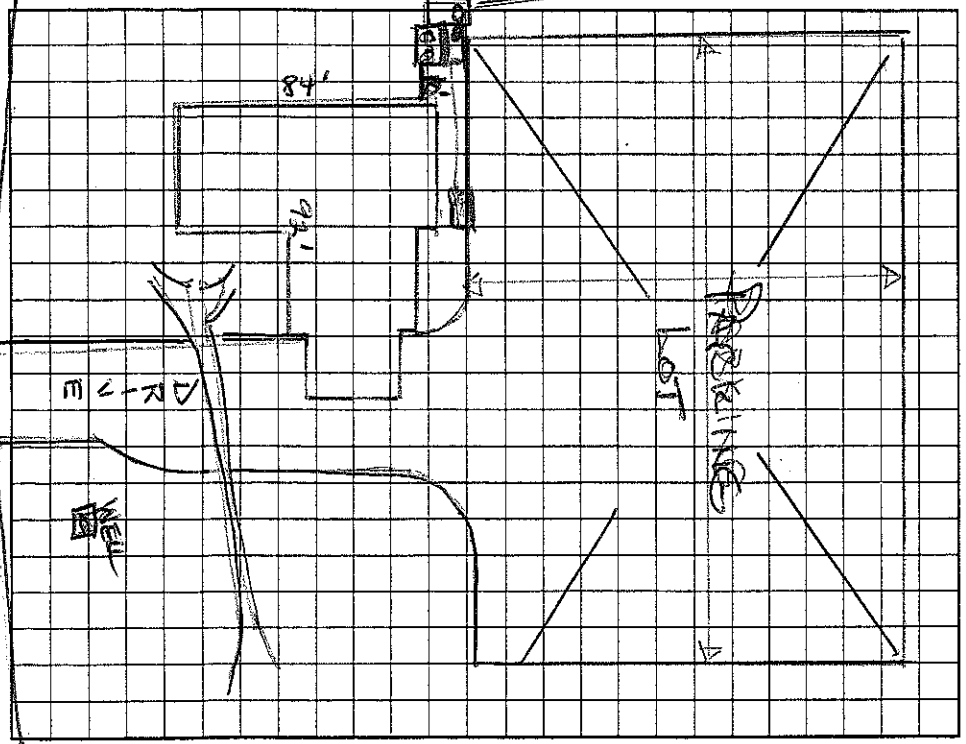

Comments:/Conditions:

AS BUILT SKETCH

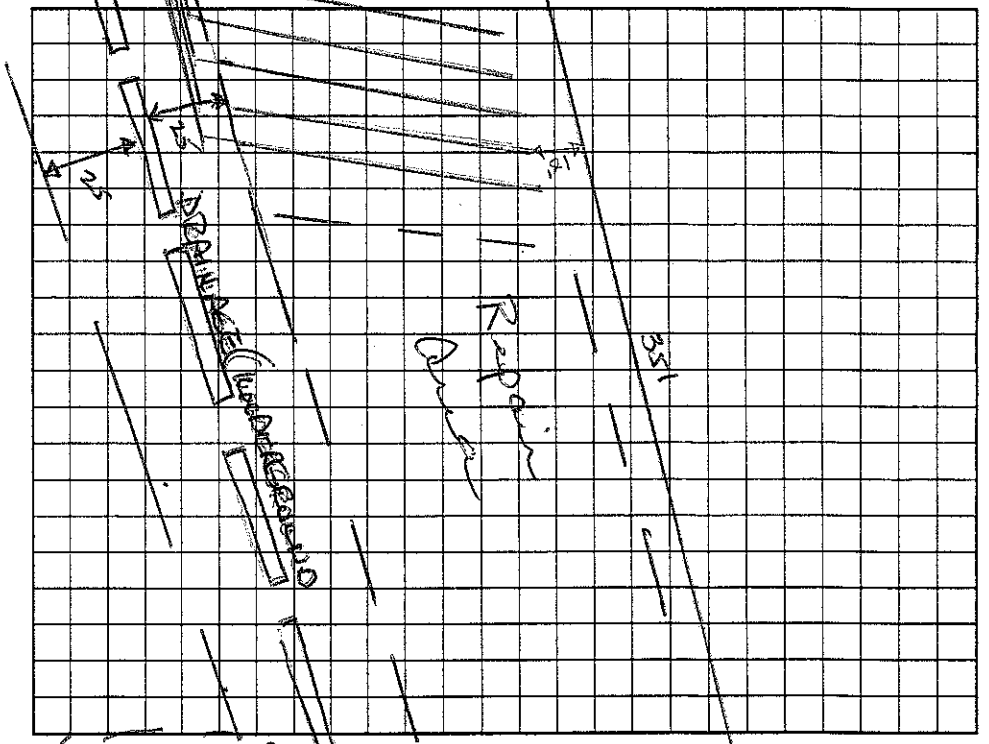

OLYMPIA DRIVE

Permit can be suspended or revoked if any false information is supplied toward securing the permit/any unauthorized changes are made to the site/any unauthorized changes are made in the installation of the system. Improvement Permit with plat valid without expiration/ Improvement Permit with site plan valid for sixty months. Authorization to Construct is valid for a period equal to that of Improvement Permit – not to exceed sixty months.

Signed: [signature] date

Improvement Permit by: Wesley Sparks RS. date 7/26/04

Authorization to Construct by: Wesley Sparks RS date 7/26/04

Installed by: Dennis Wilson Pro. [signature] RS

Operation Permit by: [signature] RS date 12/7/04

Existing System Inspection by: date

HEALTH DEPT. COPY: WHITE OWNER COPY (FINAL): YELLOW OWNER COPY (INITIAL): PINK

532