IREDELL COUNTY HEALTH DEPARTMENT

4648960188

STATESVILLE 704-878-5305 MOORESVILLE 704-664-5281

IMPROVEMENT PERMIT / CERTIFICATE OF COMPLETION / OPERATION PERMIT / EXISTING SYSTEM INSPECTION

PROPERTY DESCRIPTION NO. 20492 DATE 3/14/95 TAX MAP NO. 2Q B 2

OWNER OR CONTRACTOR Nathan Whitmer PHONE: Business Home 663-0478

ADDRESS PO Box 1734 Mooresville Watershed: ☑ Yes ☐ No

LOCATION Cornelius Rd on (R) before Judes Rd.

SUBDIVISION BLOCK / SECTION LOT LOT AREA .5 SITE CLASS P DESIGN FLOW 360 L.T.A.R. .35

Septic Tank: 1000 Gallons; STB 1612 Date ~~8/25/97~~

Pump Tank: Gallons; PT Date

Pump Make: Model Serial No.

Nitrification Field: No Fields 1 Square Feet 1028 Linear Feet 343

No Lines 4 Trench Width 36" Max Trench Bottom Depth 36" Gravel Depth 12"

☐ New System ☐ Repair System Type: I (II) III, IV, V, VI

System Description: Conv.

Repair System Description:

Maintenance Agreement Required: ☐ Yes ☑ No

☐ House/Mod. Home No. Bedrooms 3

☑ Mobile Home No. Bathrooms 2

☐ Business No. Employees

☐ Other


☐ Slab ☑ Crawl Space ☐ Basement w/plumbing ☐ Basement wo/plumbing

Water Supply: ☑ Individual ☐ Community ☐ Public


Comments: Trailer must be setup as shown here. Small lot - no room for mistakes. Call before digging if there any problem. P.O.

Comments:

INITIAL SITE SKETCH 147'

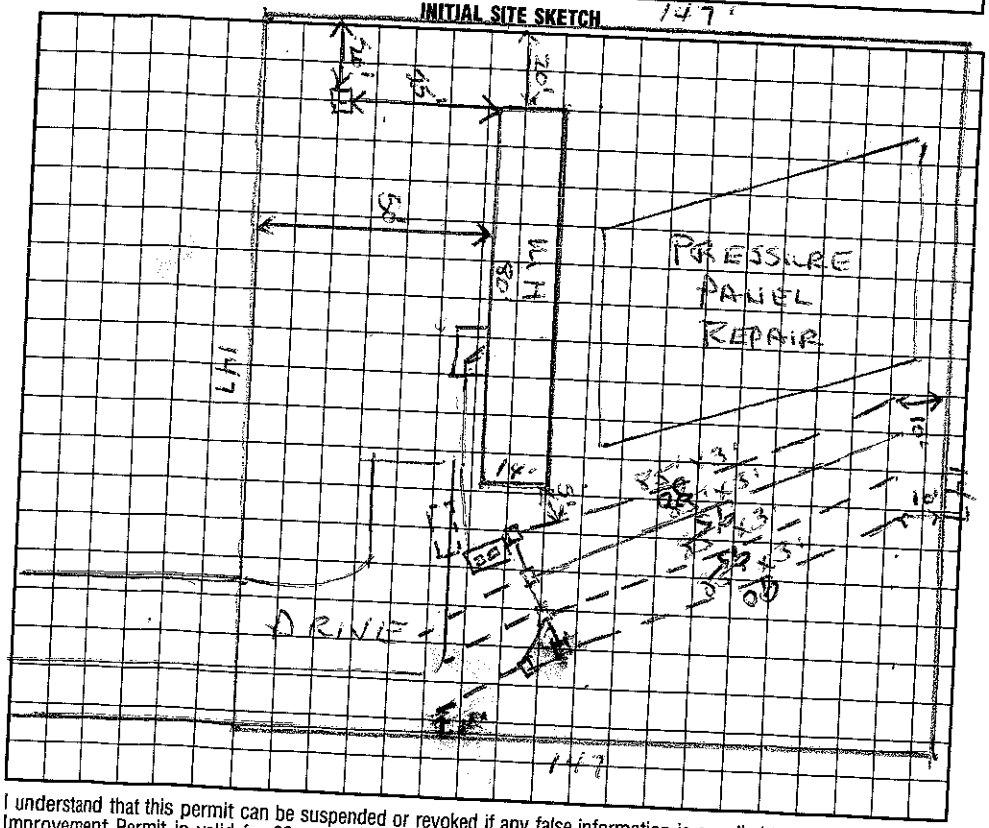

AS BUILT SKETCH

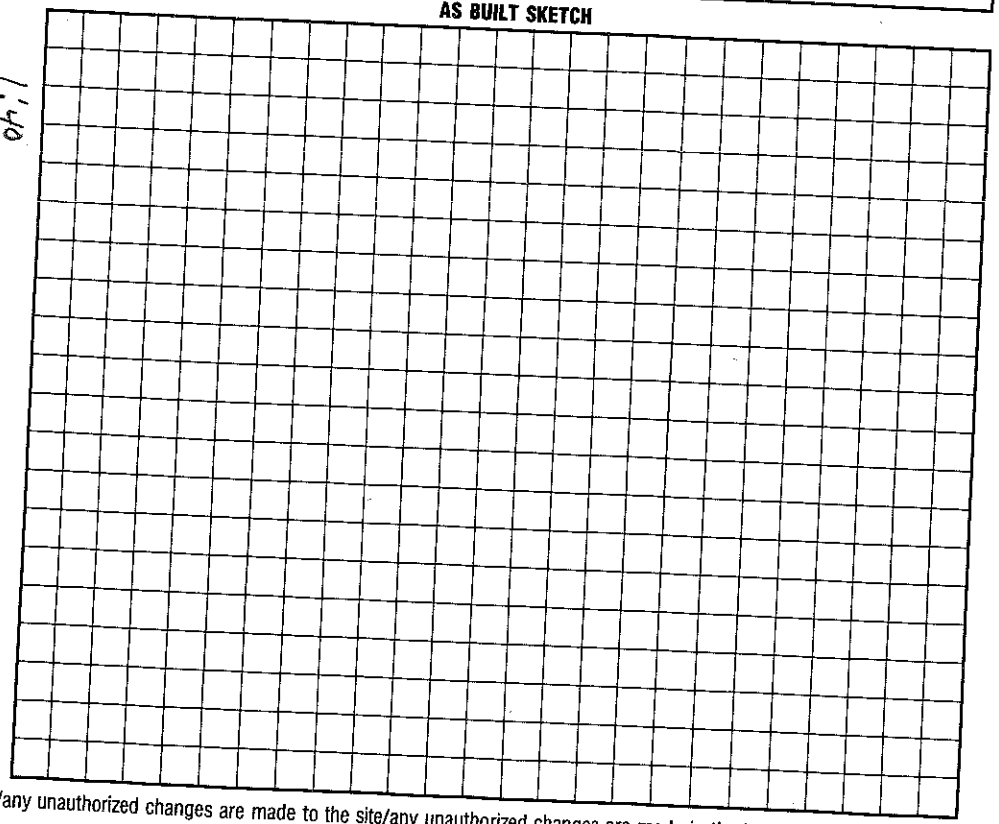

I understand that this permit can be suspended or revoked if any false information is supplied toward securing the permit/any unauthorized changes are made to the site/any unauthorized changes are made in the installation of the system. Improvement Permit is valid for 60 months from date of issuance.

Signed: Nathan Whitmer

Improvement Permit by: Wesley Sparks R.S. date 3/14/95

Existing System Inspection by: date

Installed by: A-1 Backhoe Service

Certificate of Completion by: Wesley Sparks R.S. date 10/7/97

Operation Permit by: Wesley Sparks R.S. date 10/7/97

HEALTH DEPT. COPY: WHITE INSPECTION COPY (FINAL): GREEN OWNER COPY (FINAL): YELLOW INSPECTION COPY (INITIAL): PINK OWNER COPY (INITIAL): GOLD