11:30

# IREDELL COUNTY HEALTH DEPARTMENT

STATESVILLE 704-878-5305 MOORESVILLE 704-664-5281

## IMPROVEMENT PERMIT / AUTHORIZATION TO CONSTRUCT / OPERATION PERMIT / EXISTING SYSTEM INSPECTION

PERMIT# 076514 PIN# 4648 96 3219 DATE 10/21/98

OWNER OR CONTRACTOR BURL TORRENCE PHONE: Business Home

ADDRESS PO BOX 1814 MOORESVILLE

LOCATION CORNELIUS RD - TO DOROTHY LN - ON RT ~ 200 yards off Rd

SUBDIVISION BLOCK / SECTION — LOT — LOT AREA 4.86 AC SITE CLASS. PS DESIGN FLOW 480 L.T.A.R. .3

Septic Tank: 1000 Gallons; STB 1017 Date 10/13/98

Pump Tank: Gallons; PT Date

Pump Make: Model Serial No. 933

Nitrification Field: No Fields 1 Square Feet 1600 Linear Feet 400

No Lines 4@133' Trench Width 36" Max Trench Bottom Depth 36" Gravel Depth 12"

☒ New System ☐ Repair System Type: I (II) III, IV, V, VI

System Description: GRAVITY CONVENTIONAL

Repair System Description: SAME

Maintenance Agreement Required: ☐ Yes ☒ No

☐ House/Mod. Home ☒ Mobile Home ☐ Business ☐ Other

No. Bedrooms 3 No. Bathrooms 3 No. Employees


Water Supply: ☒ Individual ☐ Public ☐ Community

☐ Slab ☒ Crawl Space ☐ Basement w/plumbing ☐ Basement wo/plumbing

Comments:/Conditions:

Comments:/Conditions:

**INITIAL SITE SKETCH** (NO SCALE)

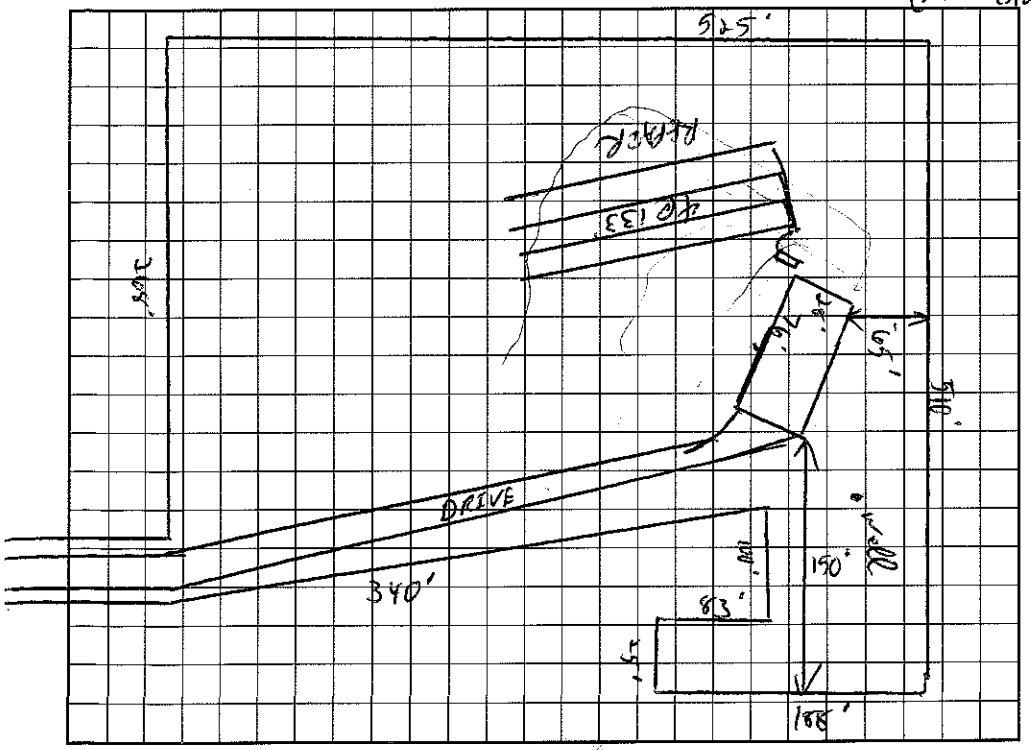


**AS BUILT SKETCH**

I understand that this permit can be suspended or revoked if any false information is supplied toward securing the permit/any unauthorized changes are made to the site/any unauthorized changes are made in the installation of the system. Improvement Permit with plat valid without expiration. Improvement Permit with site plan valid for sixty months. Authorization to Construct is valid for a period equal to that of Improvement Permit – not to exceed sixty months.

Signed: date 10/30/98 Installed by: A-1 BACKHOE

Improvement Permit by: C. Zerr RS date 10/21/98 Operation Permit by: C. Zerr RS date 1/14/99

Authorization to Construct by: C. Zerr RS date 10/21/98 Existing System Inspection by: date

HEALTH DEPT. COPY: WHITE INSPECTION COPY (FINAL): GREEN OWNER COPY (FINAL): YELLOW INSPECTION COPY (INITIAL): PINK OWNER COPY (INITIAL): GOLD