IREDELL COUNTY HEALTH DEPARTMENT

STATESVILLE ⊘ MOORESVILLE 704-664-5281

IMPROVEMENT PERMIT / AUTHORIZATION TO CONSTRUCT / OPERATION PERMIT / EXISTING SYSTEM INSPECTION

PERMIT# 117635 PIN# 4648-96-8090 DATE 1/13/04

OWNER OR CONTRACTOR ~~Steam Comfort~~ / JM Workman & Company Inc PHONE: Business ~~704-636-7554~~ 704 637 9905 Home

ADDRESS 607 Anderson Ave. Salisbury NC 28144

LOCATION 21 N, TL Cornelius, TR Olympia on LT 1st past Airel Dr.

SUBDIVISION Cornelius Est BLOCK / SECTION LOT 55 LOT AREA 0.889 AC SITE CLASS. FS DESIGN FLOW 360 L.T.A.R. .03

Septic Tank: 1000 Gallons; STB 1012 Date 11/5/03
Pump Tank: Gallons; PT Date
Pump Make: Model Serial No.
Nitrification Field: No Fields 1 Square Feet 1200 Linear Feet 400
No Lines 4@100' Trench Width 36" Max Trench Bottom Depth 36" Gravel Depth 12"

☒ New System ☐ Repair System Type: I, II, III, IV, V, VI
System Description: Gravity Conventional
Repair System Description: Same
Maintenance Agreement Required: ☐ Yes ☒ No


☒ House/Mod. Home No. Bedrooms 3
☐ Mobile Home No. Bathrooms 2
☐ Business No. Employees
☐ Other
☐ Slab ☒ Crawl Space ☐ Basement w/plumbing ☐ Basement wo/plumbing

Water Supply: ☒ Individual ☐ Public ☐ Community


Comments:/Conditions:
1"=40'

Comments:/Conditions: Installed as shown.

INITIAL SITE SKETCH

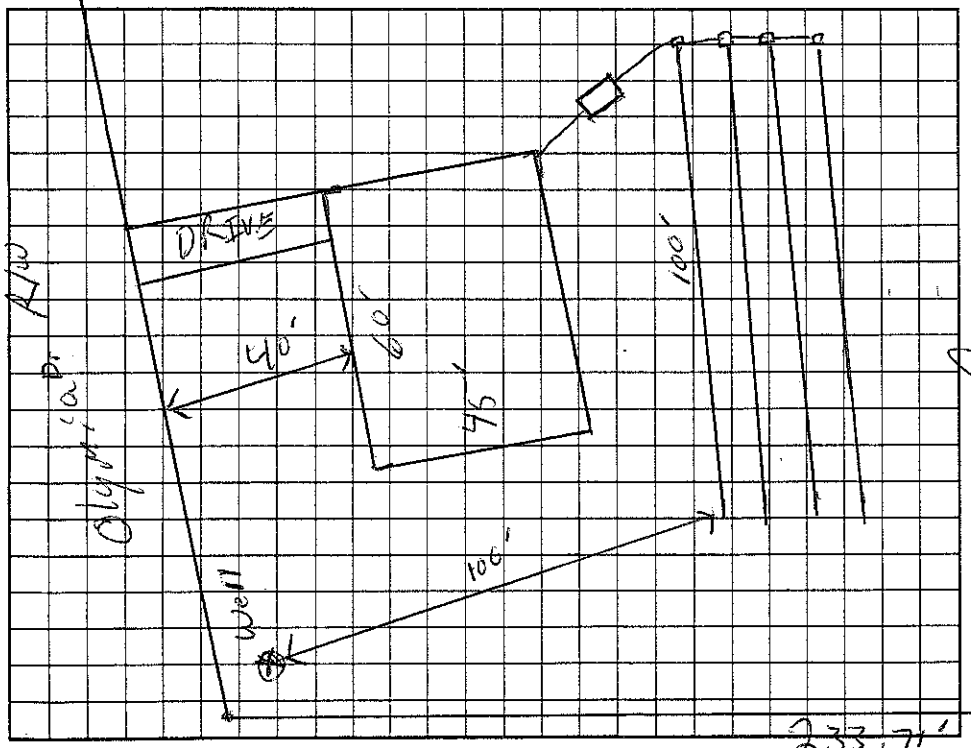

AS BUILT SKETCH

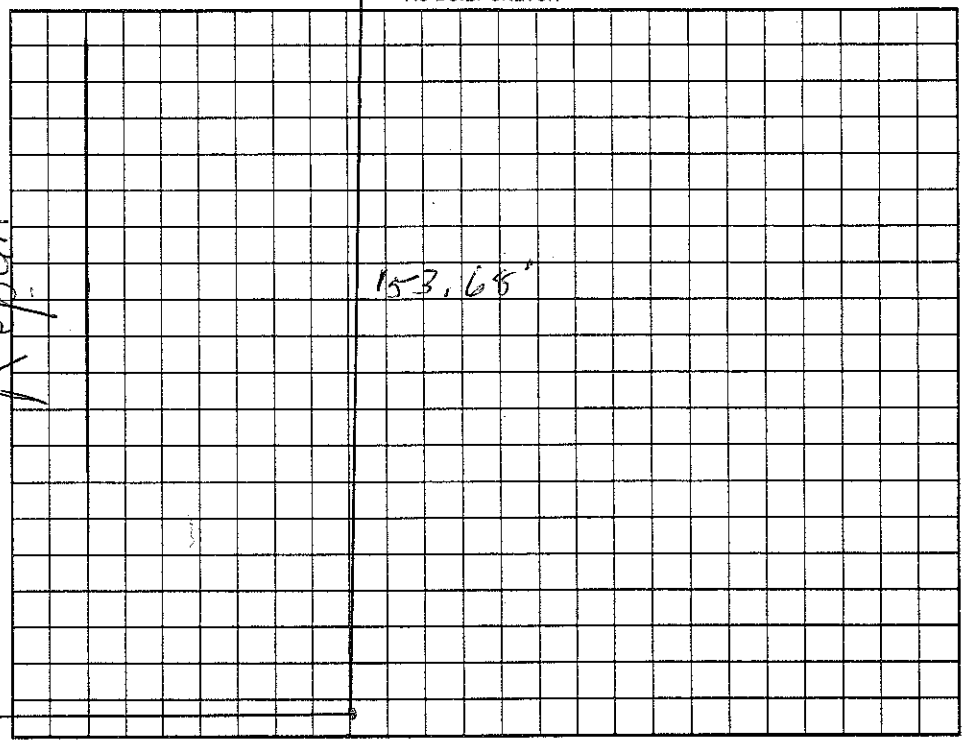

Permit can be suspended or revoked if any false information is supplied toward securing the permit/any unauthorized changes are made to the site/any unauthorized changes are made in the installation of the system. Improvement Permit with plat valid without expiration. Improvement Permit with site plan valid for sixty months. Authorization to Construct is valid for a period equal to that of Improvement Permit – not to exceed sixty months.

Signed: Stanley Shayan date 1-30-04 Installed by: A1 Backhoe

Improvement Permit by: RS date 1/13/04 Operation Permit by: Wesley Sparks RS. date 4-19-04

Authorization to Construct by: RS date 1/13/04 Existing System Inspection by: date

HEALTH DEPT. COPY: WHITE OWNER COPY (FINAL): YELLOW OWNER COPY (INITIAL): PINK