IREDELL COUNTY HEALTH DEPARTMENT

STATESVILLE 704-878-5305 MOORESVILLE 704-664-5281

IMPROVEMENT PERMIT / AUTHORIZATION TO CONSTRUCT / OPERATION PERMIT / EXISTING SYSTEM INSPECTION

PERMIT # 153685 PIN # 4648 96 9173 DATE 11/4/08

OWNER or APPLICANT BRIAN SCOTT SMITH PHONE: Business Home: 704-458-9155

OWNER or APPLICANT ADDRESS 104 LAWNHAVEN DR. MOORESVILLE, NC 28115

LOCATION / DIRECTIONS 21 N TL CORNELIUS RD. TR OLYMPIA DR. ON L AT CORNER OF ALYAH LN.

SUBDIVISION CORNELIUS ESTATES BLOCK / SECTION LOT # 54 LOT AREA .767 DESIGN FLOW 360 L.T.A.R. .35

Septic Tank 1000 Gallons: STB 877 Date 6/1/09

Pump Tank Gallons: PT Date

Pump Make Model Serial #

Nitrification Field No Fields 1 No Lines 5 Linear Feet 345 (300)

Trench Width 3' Max. Trench Bottom Depth 3' Gravel Depth 12"

[X] New System [ ] Repair [ ] Expansion System Type I (II) III IV V VI

System Description: GRAVITY - ~~CONVENTIONAL~~ 25% RED

Repair System Description: PM → 25% REDUCTION

Maintenance Agreement Required [ ] YES [X] NO

[X] GRAVITY [ ] PRESSURE

[X] Residence No. Bedrooms 3

[ ] Business No. Persons

[ ] Other No. Employees

[ ] Slab [X] Crawl Space

[ ] Basement w/plumbing [ ] Basement w/o plumbing


Water Supply: [X] Private [ ] Public [ ] Community

Comments / Conditions: DROP BOXES - LINES ON CONTOUR AS SHOWN - ALL REVISIONS MUST BE IN WRITING AND APPROVED BY ICHD.

1" = 50'

Comments / Conditions: Inspection Installed

INITIAL SITE SKETCH

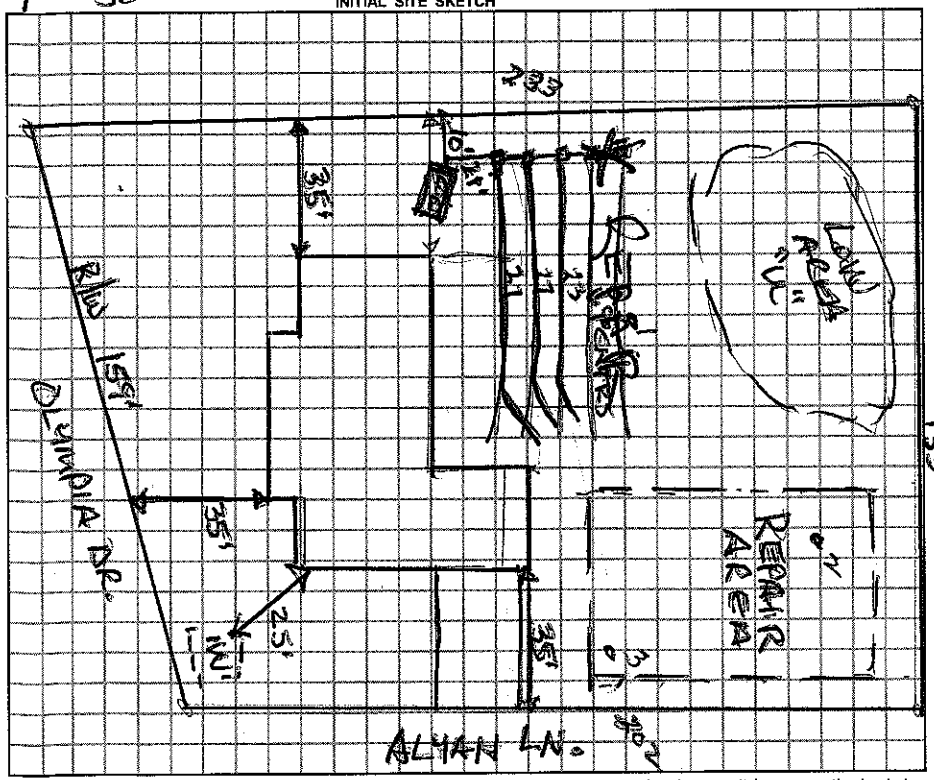

AS BUILT SKETCH

Permit can be suspended or revoked if any false information is supplied toward securing the permit / any unauthorized changes are made to the site / any unauthorized changes are made in the installation of the system.

[ ] *IMPROVEMENT PERMIT w / plat valid without expiration.* [X] *IMPROVEMENT PERMIT w / site plan valid for 60 mos.* [ ] *AUTHORIZATION TO CONSTRUCT valid for period equal to IMPROVEMENT PERMIT-not to exceed 60 mo.*

Owner / Applicant Signature: * Brian S. Smith Date 12-5-08

Improvement Permit by: Wesley Sparks RS. Date 11/4/08

Authorization to Construct by: Wesley Sparks RS. Date 11/4/08

YOU SHOULD CONTACT A LOCATOR SERVICE PRIOR TO ANY EXCAVATION.

Installed by: Lewis L Mc Spaw in Style Tanks

Operation Permit by: Wesley Sparks REHS Date: 12/8

Existing System Inspected by: Date:

WHITE COPY Environmental Health YELLOW COPY (Final) Owner / Applicant PINK COPY (Initial) Owner / Applic