IREDELL COUNTY HEALTH DEPARTMENT

STATESVILLE 704-878-5305 MOORESVILLE 704-664-5281

IMPROVEMENT PERMIT / AUTHORIZATION TO CONSTRUCT / OPERATION PERMIT / EXISTING SYSTEM INSPECTION

130.00 Paid

PERMIT# 118033 PIN# 4648 98 9826 DATE 2/12/04

OWNER OR CONTRACTOR Gregory Osborne PHONE: Business 704-799-8971 Home

ADDRESS 156 Bradford Lyn Rd. Mooresville, NC. 28115

LOCATION Cornelius Rd. rt Cornelius Estates straight to "T" rt 1st on L before top of hill

SUBDIVISION Cornelius Estates BLOCK / SECTION LOT 30 LOT AREA 3.5 AC SITE CLASS. PS DESIGN FLOW 480 L.T.A.R. .3

Septic Tank: 1000 Gallons; STB 994 Date 4/28/04

Pump Tank: Gallons; PT Date

Pump Make: Model Serial No.

Nitrification Field: No Fields 1 Square Feet 1200 Linear Feet 406

No Lines 4 @ 100' Trench Width 3' Max Trench Bottom Depth 3' Gravel Depth N/A

[X] New System [ ] Repair System Type: I, II, (III), IV, V, VI

System Description: Gravity - 25% Reduced

Repair System Description: Gravity - 25% Reduced

Maintenance Agreement Required: [ ] Yes [ ] No

[X] House/Mod. Home [ ] Mobile Home [ ] Business [ ] Other

No. Bedrooms 4 No. Bathrooms 3 No. Employees


[ ] Slab [ ] Crawl Space [X] Basement w/plumbing [ ] Basement wo/plumbing

Water Supply: [X] Individual [ ] Public [ ] Community


Comments:/Conditions:

Comments:/Conditions:

INITIAL SITE SKETCH

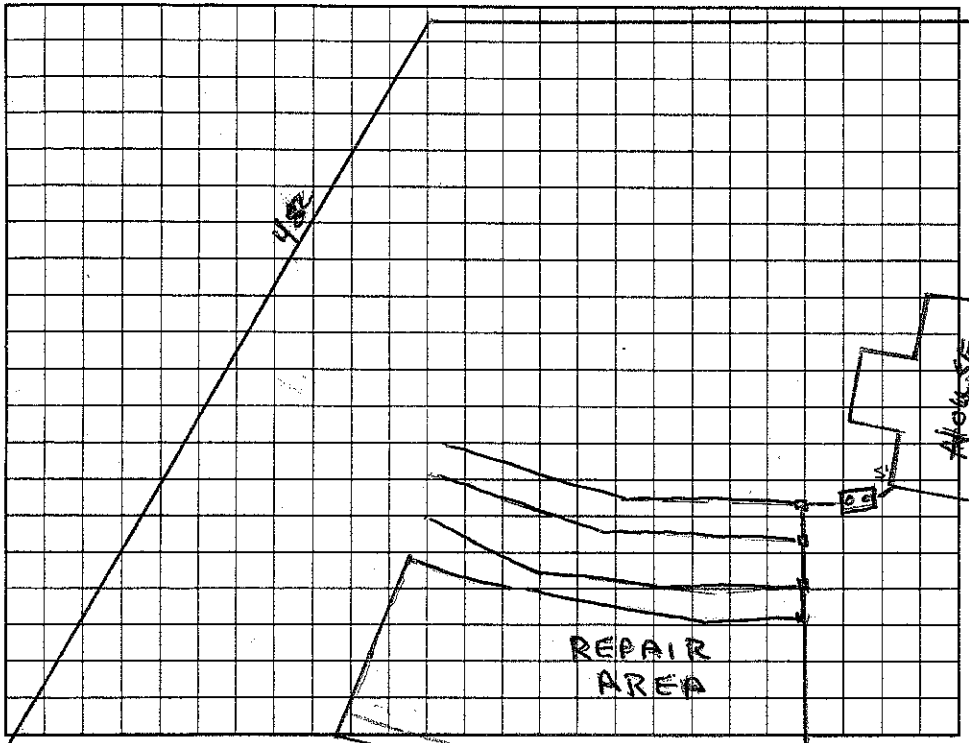

AS BUILT SKETCH

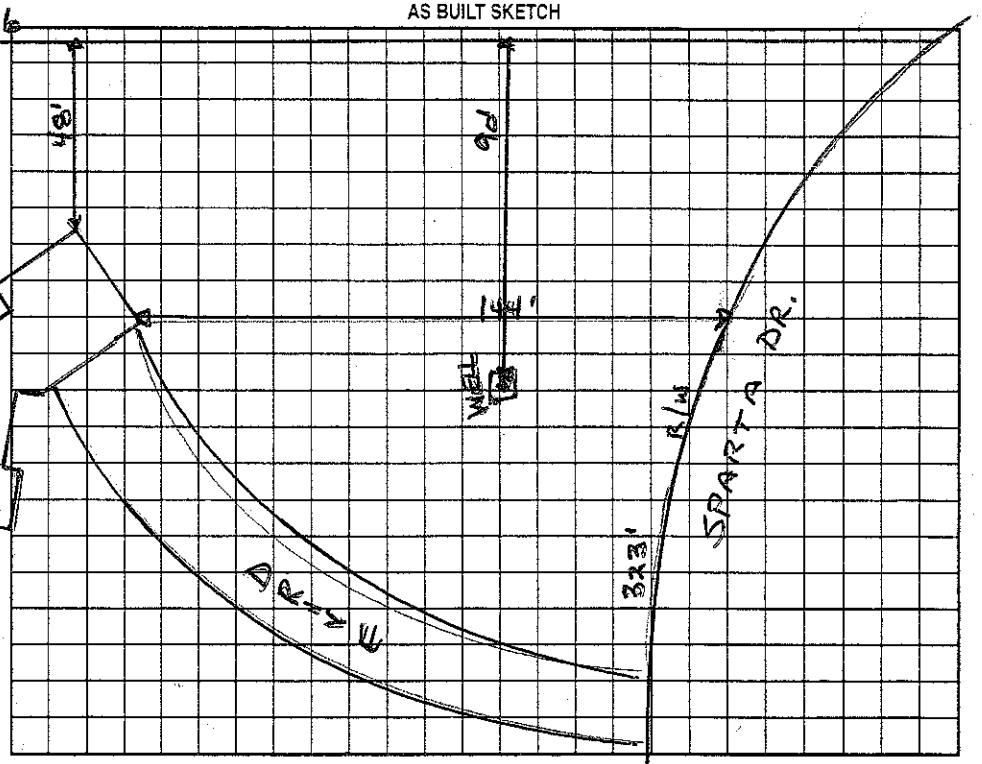

Permit can be suspended or revoked if any false information is supplied toward securing the permit/any unauthorized changes are made to the site/any unauthorized changes are made in the installation of the system. Improvement Permit with plat valid without expiration. Improvement Permit with site plan valid for sixty months. Authorization to Construct is valid for a period equal to that of Improvement Permit – not to exceed sixty months.

Signed: * date 2-5-04

Improvement Permit by: Wesley Sparks RS. date 2/12/04

Authorization to Construct by: Wesley Sparks RS date 2/12/04

Installed by: Russell Well + Pump

Operation Permit by: Wesley Sparks RS. date 8/4/04

Existing System Inspection by: date

HEALTH DEPT. COPY: WHITE OWNER COPY (FINAL): YELLOW OWNER COPY (INITIAL): PINK