IREDELL COUNTY HEALTH DEPARTMENT

Authorization to Construct 4649020305 1 of 2

STATESVILLE 704-878-5305 MOORESVILLE 704-664-5281

IMPROVEMENT PERMIT / ~~CERTIFICATE OF COMPLETION~~ / OPERATION PERMIT / EXISTING SYSTEM INSPECTION

PROPERTY DESCRIPTION NO. 04 8657 DATE 8/25/97 TAX MAP NO. 4639 90 8600 Pt of F Watershed: X Yes ☐ No

OWNER OR CONTRACTOR Christopher Southers PHONE: Business _____ Home 528-4475

ADDRESS 1693 Perth Rd. Mooresville, NC. 28115

LOCATION Perth N on R just past Rocky Mount Church

SUBDIVISION N/A BLOCK / SECTION _____ LOT 1 LOT AREA ~ .75 SITE CLASS. PS DESIGN FLOW 360 L.T.A.R. .3

Septic Tank: 1000 Gallons; STB 1012 Date 8/2/97

Pump Tank: _____ Gallons; PT _____ Date _____

Pump Make: _____ Model _____ Serial No. 270 Aug

Nitrification Field: No Fields 1 Square Feet 1200 Linear Feet ~~_____~~

No Lines 3 Trench Width 36" Max Trench Bottom Depth 36" Gravel Depth 12"

X New System ☐ Repair System Type: I, II, III, IV, V, VI

System Description: CONV.

Repair System Description: SAME

Maintenance Agreement Required: ☐ Yes ☐ No

☐ House/Mod. Home No. Bedrooms 3

X Mobile Home No. Bathrooms 2.5

☐ Business No. Employees _____

☐ Other _____


☐ Slab X Crawl Space ☐ Basement w/plumbing ☐ Basement wo/plumbing

Water Supply: X Individual ☐ Community ☐ Public


Comments:

Comments:

INITIAL SITE SKETCH

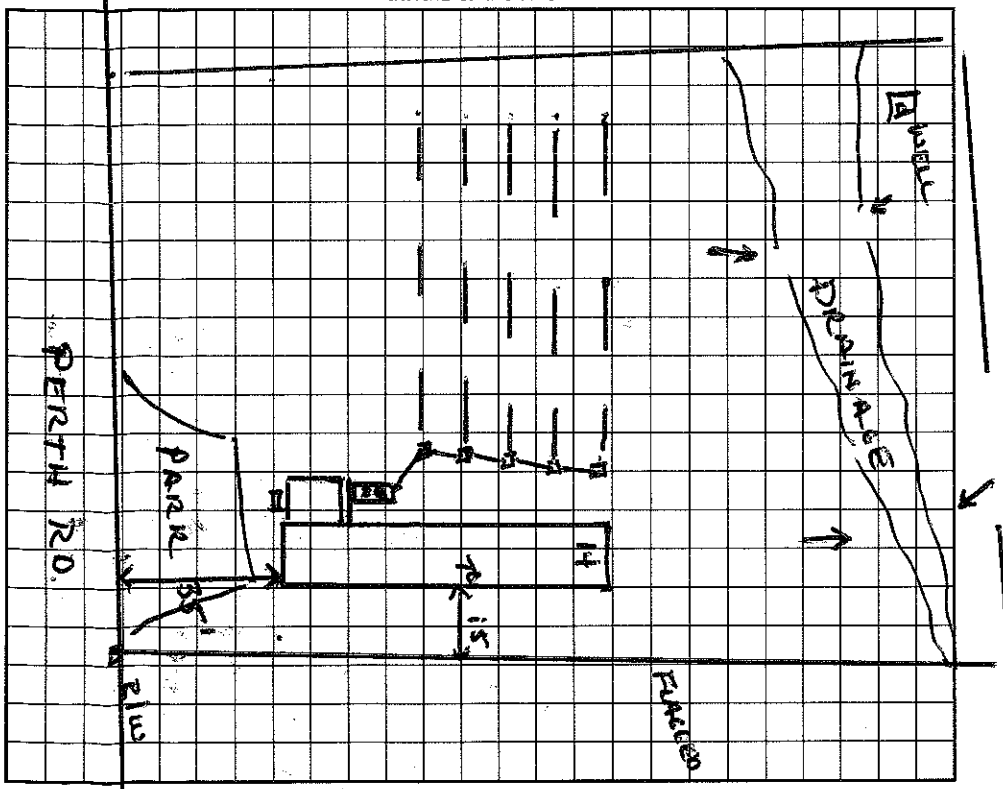

AS BUILT SKETCH

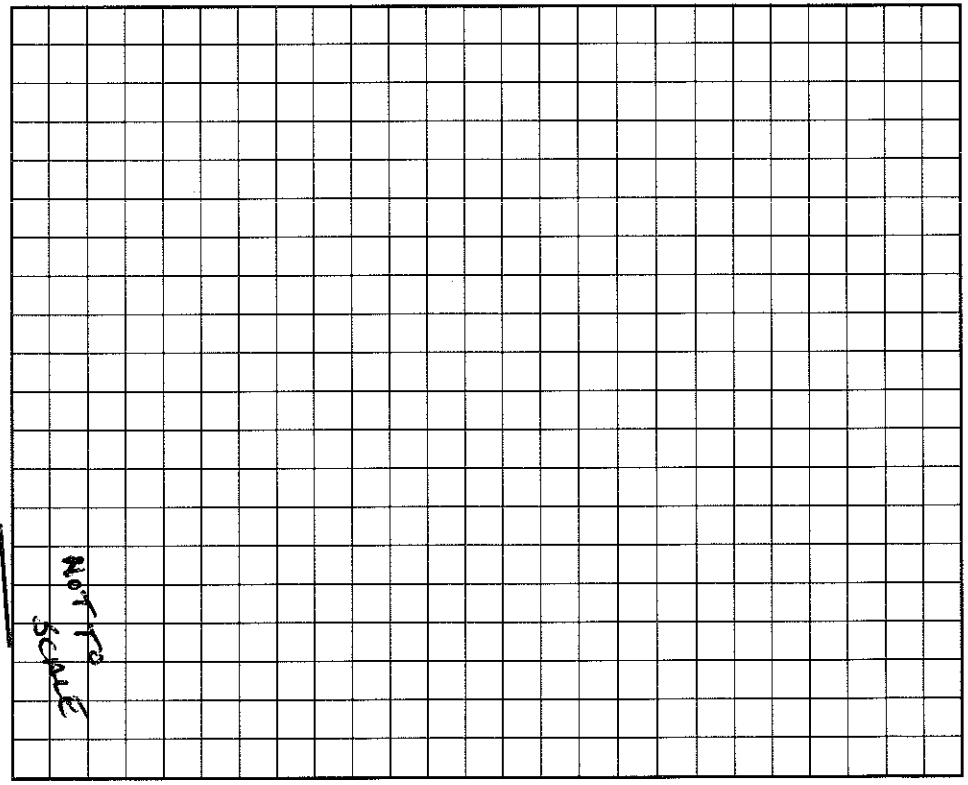

I understand that this permit can be suspended or revoked if any false information is supplied toward securing the permit/any unauthorized changes are made to the site/any unauthorized changes are made in the installation of the system. Improvement Permit is valid for 60 months from date of issuance.

Signed: Tommy Freeman

Improvement Permit by: Wesley Sparks RS. date 8/25/97

Existing System Inspection by: Wesley Sparks RS date 8/25/97

Installed by: A1 Backhoe

Certificate of Completion by: Wesley Sparks RS date 10/10/97

Operation Permit by: Wesley Sparks RS. date 10/10/97

HEALTH DEPT. COPY: WHITE INSPECTION COPY (FINAL): GREEN OWNER COPY (FINAL): YELLOW INSPECTION COPY (INITIAL): PINK OWNER COPY (INITIAL): GOLD