
Acknowledgement Of
Plans Submittal ONLY!

Date 3-5-15

APPROVED MAR 19 2015 Date

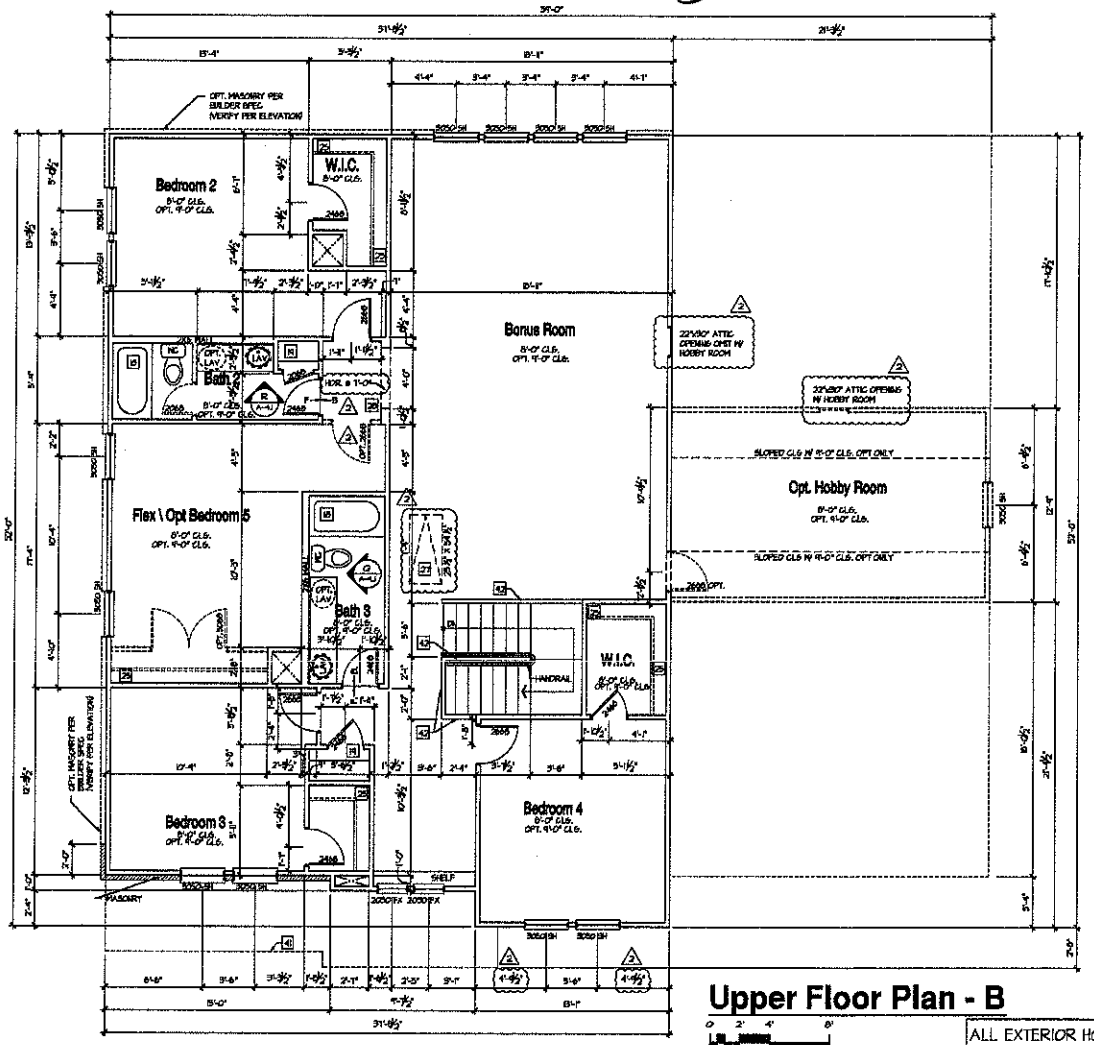

Upper Floor Plan - B

0 2' 4' 8'

ALL EXTERIOR HOUSE WALLS MAY BE OPTIONAL 2X6 STUD WALLS - SEE STRUCTURAL PLANS FOR DETAILS.

TYPICAL CONSTRUCTION ASSEMBLIES:

A. TYPICAL ROOF CONSTRUCTION:
ASPHALT ROOF SHINGLES

B. TYPICAL FRAME FLOOR CONSTRUCTION:
T&G PLYWOOD FLOORING ON 3/4" TONGUE & GROOVE FLOOR SHEATHING ON FLOOR TRUSSES OR FLOOR JOISTS AS NOTED ON STRUCTURAL DRAWINGS.

C. SLAB ON GRADE FLOOR CONSTRUCTION:
4" CONCRETE SLAB, EXCEPT AS SPECIFIED BY SOIL REPORT, AND STRUCTURAL ENGINEER. INCLUDE VAPOR BARRIER PER SECTION N, C, 5, a.

D. WINDOWS:
A. ALL WINDOWS SHALL COMPLY WITH MINIMUM STANDARDS OUTLINED IN APPLICABLE RES. CODES.
B. WINDOW SUPPLIER TO VERIFY AT LEAST ONE WINDOW IN ALL BEDROOMS TO HAVE A CLEAR EGRESS OPENING OF 5.7 SQ. FT. WITH MIN. DIMENSION OF 24" IN HEIGHT AND 20" IN WIDTH, SILL HEIGHT NOT GREATER THAN 44" ABOVE FLOOR.
C. TYPICAL WINDOW HEAD HEIGHT:
7'-0" A.F.F. @ 8'-1 1/8" PLATE HEIGHT (U.N.O.)
8'-0" A.F.F. @ 9'-1 1/8" PLATE HEIGHT (U.N.O.)

E. ELECTRICAL:
ALL ELECTRICAL AND MECHANICAL EQUIPMENT & METERS ARE SUBJECT TO RELOCATION DUE TO FIELD CONDITIONS. CONTRACTOR TO VERIFY.

F. HVAC:
PROVIDE BACK DRAFT DAMPERS @ DRYER VENT, HOOD VENT, & EXHAUST FANS.

G. STONE SILLS:
INSTALL PER LOCAL CODE.

H. DIMENSIONS ARE TO THE FACE OF STUD, U.N.O.

I. ALL EXTERIOR DIMENSIONS ARE TO FACE OF STUDS UNLESS OTHERWISE NOTED.

J. ALL ANGLED PARTITIONS ARE 45 DEGREES UNLESS OTHERWISE NOTED.

K. BRICK SILLS:
INSTALL PER LOCAL CODE.

FLOOR PLAN NOTES:

(BATH_FLOOR)

6 THE FOLLOWING KEYNOTES REFERENCE THE SYMBOLS AS SHOWN ON PLANS.

L. IF RAILING / GUARDRAIL IS PROVIDED, ALL RAILING / GUARDRAIL BALUSTERS TO BE SPACED SUCH THAT A 4" SPHERE CANNOT PASS BETWEEN BALUSTERS.
RAILING/HANDRAILS ARE TO BE AT A 34" MINIMUM TO 38" MAXIMUM HEIGHT A.F.F. FOR STAIRS AND 36" MINIMUM ON HORIZONTAL SURFACE GUARDS.

1. LINE OF OVERHEAD GARAGE DOOR IN OPEN POSITION
2. SLOPE GARAGE FLOOR 1/8" PER FOOT TOWARD OVERHEAD GARAGE DOOR OPENING.
3. FIREPLACE, AS SPECIFIED BY BUILDER. INSTALL PER MANUFACTURERS SPECIFICATIONS. ALL FACTORY BUILT FIREPLACES SHALL COMPLY WITH LOCAL CODES.
4. SINK W/ GARBAGE DISPOSAL
5. DISHWASHER
6. RANGE
7. COOK TOP
8. OVEN
9. REFRIGERATOR SPACE.
10. PANTRY
11. REVERSHAL SINK
12. 42" X 42" SHOWER
13. 60" X 60" SHOWER
14. 42" X 60" TUB 21" TO TOP OF DECKING
15. 60" X 60" SHOWER TUB
16. 60" X 60" TUB/SHOWER
17. 60" X 60" TUB/SHOWER
18. LINEN SHELVING PER BUILDER SPECS.)
19. WASHER SPACE
20. DRYER VENT
21. OPTIONAL LAUNDRY SINK.
22. PROVIDE NON-COMBUSTIBLE PLATFORM ELEVATED 30" ABOVE GARAGE FLOOR FOR WATER HEATER.
23. 5 SHELVES PER BUILDER SPECS.
24. ROD AND SHELF PER BUILDERS SPECS.
25. ATTIC ACCESS (22 1/2"x30" (U.O.)
26. ATTIC ACCESS W/ STAIRS (25 1/2"x54 1/2".)
27. SYSTEM BOXED DROPPED @ 8'-0" W/ TYP. FLOOR & 7'-0" AT UPPER FLOOR U.N.O.
28. GYPSUM BOARD ARCH @ 1'-2" TO 8'-0".
29. GYPSUM BOARD LOW WALL, 36" A.F.F. (U.N.O.) W/ MSF CAP.
30. SOFFIT, REFER TO EXTERIOR ELEVATIONS FOR HEIGHTS & ARCHITECTURAL DETAILS FOR FINISH.
31. PLANT SHELF, SEE EXTERIOR ELEVATIONS.
32. HALF WALL W/ WOOD CAP OR OPTIONAL LOW WALL WITH railing ABOVE.
33. PORCH RAIL, SEE ELEVATION.
34. 36"x36" CONCRETE STOOP.
35. 6x6 BEAM.
36. OPTIONAL UPPER CABINETS.
37. OPTIONAL CABINETS.
38. OPTIONAL COFFERED CEILING @ 8'-0" PER BUILDER SPEC.
39. LINE OF FRAMING ABOVE.
40. LINE OF FRAMING WALL BELOW.
41. 2x4 LOW WALL 42" A.F.F.
42. 2x6 LOW WALL 42" A.F.F.
43. ART NICHE
44. HORIZONTAL LAUNDRY CHUTE
45. LOW WALL 24" A.F.F.
46. GYPSUM BOARD ARCH @ 8'-0" TO 8'-6"
47. LOW WALL 33" A.F.F.
48. NO HARD LATCH OR LOCKING KNOBS

ISSUE DATE: 03/05/2015
REVISIONS:

5400 Trinity Road
Suite 107
Raleigh,
North Carolina 27607
919-322-2295 Phone


Meritage Homes

Meritage Homes

BSB DESIGN
www.bsbdesign.com
8911 Westown Parkway, Suite 240
West Des Moines, Iowa 50266
515 279 3328

JOB NO. 03/12/2014 PROJECT ID
DRAWN: HOUSTOM CHECKED: JFVS
UPPER FLOOR PLAN - B

Plan - 4227
A2.2B

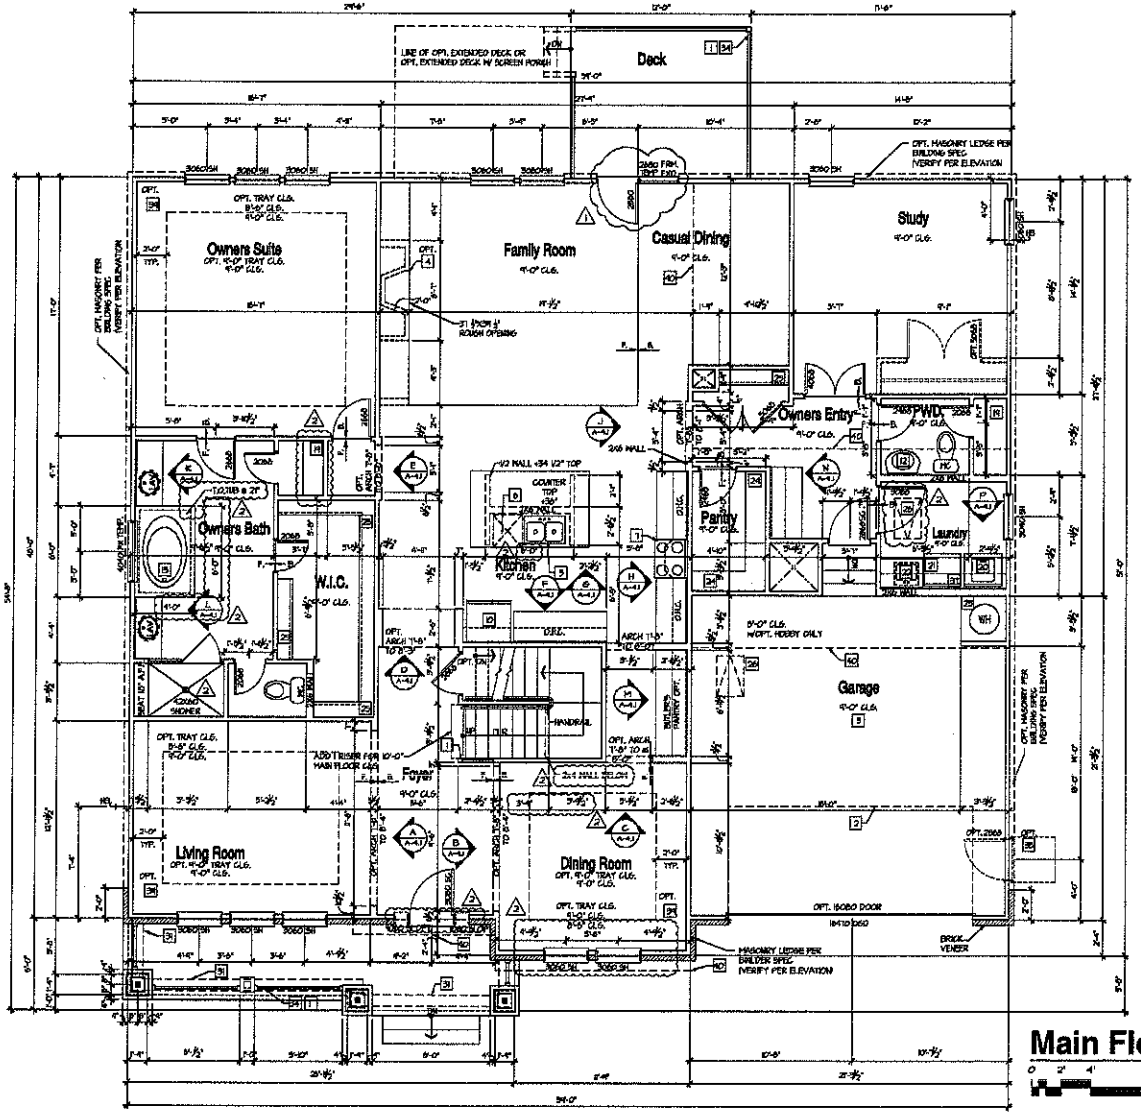

Main Floor Plan - B

0 2' 4' 8'

TYPICAL CONSTRUCTION ASSEMBLIES:

A. TYPICAL ROOF CONSTRUCTION: ASPHALT ROOF SHINGLES

B. TYPICAL FRAME FLOOR CONSTRUCTION: FINISH FLOORING ON 3/4" TONGUE & GROOVE FLOOR SHEATHING ON FLOOR TRUSSES OR FLOOR JOISTS AS NOTED ON STRUCTURAL DRAWINGS.

C. SLAB ON GRADE FLOOR CONSTRUCTION: 4" CONCRETE SLAB, EXCEPT AS SPECIFIED BY SOIL REPORT, AND STRUCTURAL ENGINEER. INCLUDE VAPOR BARRIER PER SECTION IV, C, 5, a.

D. WINDOWS:
- A. ALL WINDOWS SHALL COMPLY WITH HBHBH STANDARDS OUTLINED IN APPLICABLE RES. CHECKS.
- B. WINDOW SUPPLIER TO VERIFY AT LEAST ONE WINDOW IN ALL BEDROOMS TO HAVE A CLEAR EGRESS OPENING OF 5.7 SQ. FT. WITH MIN. DIMENSION OF 24" IN HEIGHT AND 20" IN WIDTH. SILL HEIGHT NOT GREATER THAN 44" ABOVE FLOOR.
- C. TYPICAL WINDOW HEAD HEIGHT: 7'-0" A.F.F. @ 8'-1 1/8" PLATE HEIGHT (U.N.O.) 8'-0" A.F.F. @ 9'-1 1/8" PLATE HEIGHT (U.N.O.)

E. ELECTRICAL: ALL ELECTRICAL AND MECHANICAL EQUIPMENT & METERS ARE SUBJECT TO RELOCATION DUE TO FIELD CONDITIONS. CONTRACTOR TO VERIFY.

F. HVAC: PROVIDE BACK DRAFT DAMPERS @ DRYER VENT, HOOD VENT, & EXHAUST FANS.

G. SIGHT SIZING: INSTALL PER LOCAL CODE.

H. DIMENSIONS ARE TO THE FACE OF STUD, U.N.O.

I. ALL EXTERIOR DIMENSIONS ARE TO FACE OF STUDS UNLESS OTHERWISE NOTED.

H. ALL ANGLED PARTITIONS ARE 45 DEGREES UNLESS OTHERWISE NOTED.

K. BRICK SIZING: INSTALL PER LOCAL CODE.

FLOOR PLAN NOTES:

(REFERENCE CODE)

1. THE FOLLOWING KEYNOTES REFERENCE THE SYMBOLS AS SHOWN ON PLAN:
1. IF RAILING / GUARDRAIL IS PROVIDED, ALL RAILING / GUARDRAIL BALUSTERS TO BE SPACED SUCH THAT A 4" SPHERE CANNOT PASS BETWEEN BALUSTERS. RAILING/HANDRAILS ARE TO BE AT A 34" MINIMUM TO 38" MAXIMUM HEIGHT A.F.F. FOR STAIRS AND 36" MINIMUM ON HORIZONTAL SURFACE GUARDS.
2. LINE OF OVERHEAD GARAGE DOOR IN OPEN POSITION.
3. SLOPE GARAGE FLOOR 1/8" PER FOOT TOWARD OVERHEAD GARAGE DOOR OPENING.
4. FIREPLACE, AS SPECIFIED BY BUILDER. INSTALL PER MANUFACTURERS SPECIFICATIONS. ALL FACTORY BUILT FIREPLACES SHALL COMPLY WITH LOCAL CODES.
5. SINK W/ GARBAGE DISPOSAL
6. DISHWASHER
7. RANGE
8. COOK TOP
9. OVEN
10. REFRIGERATOR SPACE.
11. PANTRY
12. PEDESTAL SINK
13. 42" X 42" SHOWER
14. ~~ARC 42"x42" SHOWER~~
15. 42" x 60" TUB 2" TO TOP OF DECKING
16. ~~60"x 60" SHOWER~~
17. 60" X 60" SHOWER
18. 60" X 60" SHOWER
19. LINEN SHELVING PER BUILDER SPECS.)
20. WASHER SPACE
21. DRYER VENT
22. OPTIONAL LAUNDRY SINK.
23. PROVIDE NON-COMBUSTIBLE PLATFORM ELEVATED 8" ABOVE GARAGE FLOOR FOR WATER HEATER.
24. 3 SHELVES PER BUILDER SPECS.
25. ~~SOFT RADIUS PER BUILDER SPECS.~~
26. ATTIC ACCESS (22 1/2"x30" U.N.O.)
27. ATTIC ACCESS W STAIRS (25 1/2"x54 1/2")
24. SYPSUM BOARD ARCH @ 11'-2" TO 8'-0".
30. GYPSUM BOARD LOW WALL, 36" A.F.F. (U.N.O.) W/ MOP CAP.
31. SOFFIT, REFER TO EXTERIOR ELEVATIONS FOR HEIGHTS & ARCHITECTURAL DETAILS FOR FINISH.
32. PLANT SHELF, SEE EXTERIOR ELEVATIONS.
33. HALF WALL W/ WOOD CAP OR OPTIONAL LOW WALL WITH RAILING ABOVE.
34. PORCH RAIL, SEE ELEVATION.
35. 36"x36" CONCRETE STOOP.
36. 6x8 BEAM.
37. OPTIONAL UPPER CABINETS.
38. OPTIONAL CABINETS.
39. OPTIONAL COFFERED CEILING @ 8'-0" PER BUILDER SPEC.
40. LINE OF FRAMING ABOVE.
41. LINE OF FRAMING WALL BELOW.
42. 2x4 LOW WALL 42" A.F.F.
43. 2x6 LOW WALL 42" A.F.F.
44. ART NICHE
45. HORIZONTAL LAUNDRY CHUTE
46. LOW WALL +24" A.F.F.
47. GYPSUM BOARD ARCH @ 8'-0" TO 5'-0"
48. LOW WALL 30" A.F.F.
49. NO KNOB LATCH OR LOCKING KNOB

SQUARE FOOTAGES

MAIN FLOOR	2486
UPPER FLOOR	1857
SUBTOTAL	4343
GARAGE	462
PORCH	58
SUNROOM	326
WALKED BASEMENT	861
OPT. HOBBY ROOM	218
OPT. SCREENED PORCH	120
TOTAL	1945

ALL EXTERIOR HOUSE WALLS MAY BE OPTIONAL 2X6 STUD WALLS - SEE STRUCTURAL PLANS FOR DETAILS.

Acknowledgement Of Plans Submittal ONLY!

Date 3-5-15

APPROVED MAR 19 2015

Date

ISSUE DATE: 03/05/2015

REVISIONS:

5400 Trinity Road
Suite 107
Raleigh,
North Carolina 27607
919-322-2285 Phone

Meritage Homes

Meritage Homes

BSB DESIGN

www.bsbdesign.com
6011 Westown Parkway, Suite 240
West Des Moines, Iowa 50266
515.279.3061

JOB NO. 08/13/2014 PROJECT MGR. JF
DRAWN HOUSTON CHECKED JFQ

MAIN FLOOR PLAN - B

Plan - 4227


A2.1B

Acknowledgement Of
Plans Submittal ONLY!

Date 3-5-15

APPROVED MAR 19 2015

Date

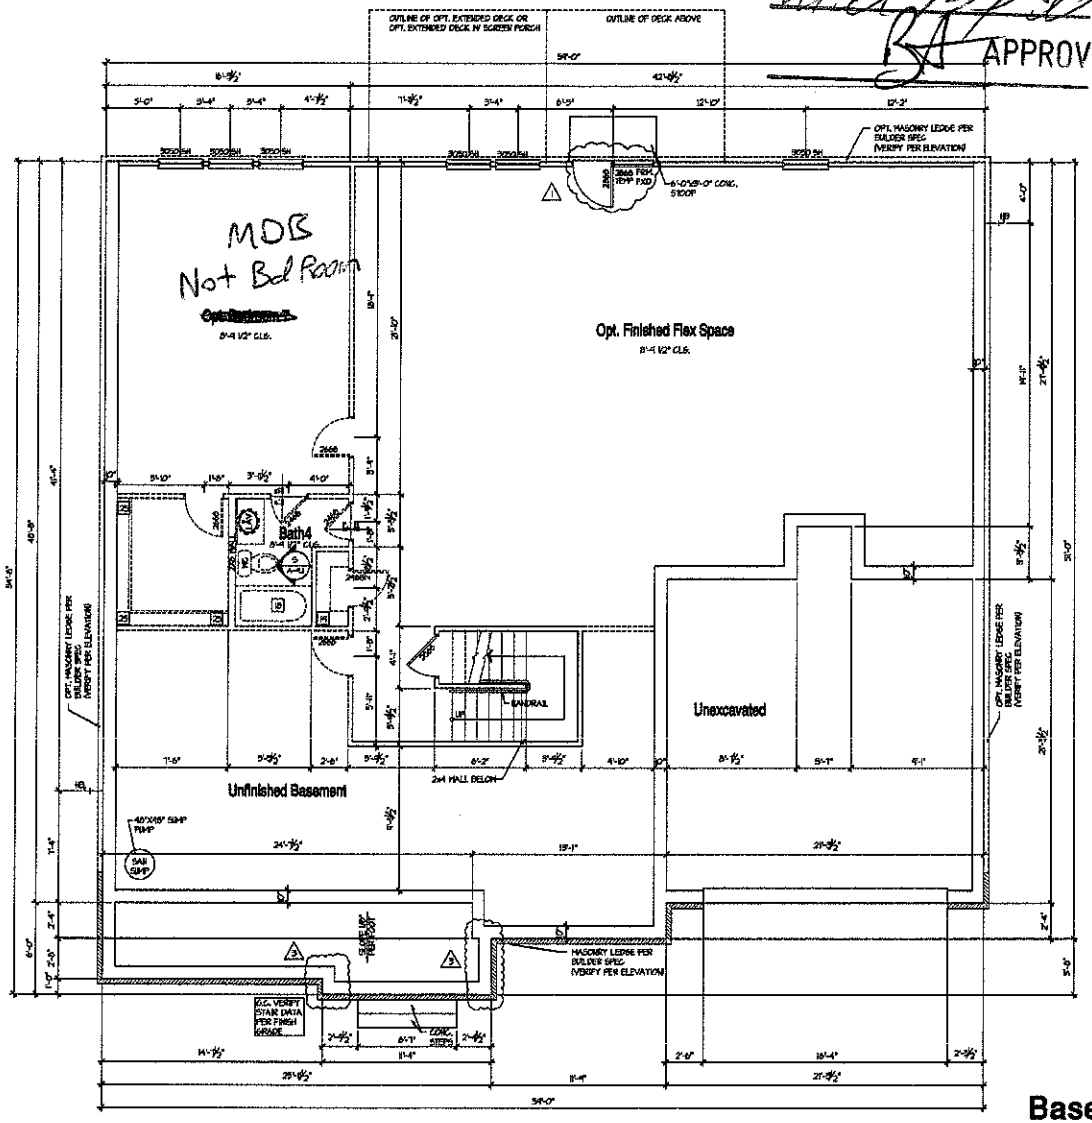

Basement Floor Plan - B

0 2' 4' 8'

REFER TO HOME PLANS FOR ALL TYPICAL NOTES AND DIMENSIONS NOT SHOWN

TYPICAL CONSTRUCTION ASSEMBLIES:

A. ROOFING:
TYPICAL ROOF CONSTRUCTION:
ASPHALT ROOF SHINGLES

B. FLOORING:
TYPICAL FRAME FLOOR CONSTRUCTION:
FINISH FLOORING ON 3/4" TONGUE & GROOVE FLOOR SHEATHING ON FLOOR TRUSSES OR JOISTS AS NOTED ON STRUCTURAL DRAWINGS.
GARAGE APRON & DOOR CONSTRUCTION:
4" CONCRETE SLAB, EXCEPT AS SPECIFIED BY SOIL REPORT, AND STRUCTURAL ENGINEER. INCLUDE VAPOR BARRIER PER SECTION M, C, S, a.

C. WINDOWS:
A. ALL WINDOWS SHALL COMPLY WITH MINIMUM STANDARDS OUTLINED IN APPLICABLE RESI. CHECKS.
B. WINDOW SUPPLIER TO VERIFY AT LEAST ONE WINDOW IN ALL BEDROOMS TO HAVE A CLEAR EGRESS OPENING OF 5.7 SQ. FT. WITH MIN. DIMENSION OF 24" IN HEIGHT AND 20" IN WIDTH SILL HEIGHT NOT GREATER THAN 44" ABOVE FLOOR.
C. TYPICAL WINDOW HEAD HEIGHT:
7'-0" A.F.F. @ 8'-1 1/8" PLATE HEIGHT (ULO)
8'-0" A.F.F. @ 9'-1 1/8" PLATE HEIGHT (ULO)

E. MECHANICAL:
ALL ELECTRICAL AND MECHANICAL EQUIPMENT & METERS ARE SUBJECT TO RELOCATION DUE TO FIELD CONDITIONS/ CONTRACTOR TO VERIFY.

F. HVAC:
PROVIDE BACK DRAFT DAMPERS @ DRYER VENT, HOOD VENT, & EXHAUST FANS.

G. STONE SILLS:
INSTALL PER LOCAL CODE.

H. DIMENSIONS ARE TO THE FACE OF STUD, U.N.O.

I. ALL EXTERIOR DIMENSIONS ARE TO FACE OF STUDS UNLESS OTHERWISE NOTED.

M. ALL ANGLED PARTITIONS ARE 45 DEGREES UNLESS OTHERWISE NOTED.

N. BRICK SILLS:
INSTALL PER LOCAL CODE.

FLOOR PLAN NOTES:

THE FOLLOWING KEYNOTES REFERENCE THE SYMBOLS AS SHOWN ON PLANS.

1. IF RAILING / HANDRAIL IS PROVIDED, ALL RAILING / HANDRAIL BALUSTERS TO BE SPACED SUCH THAT A 4" SPHERE CANNOT PASS BETWEEN BALUSTERS. RAILING/HANDRAILS ARE TO BE AT A 34" MINIMUM TO 38" MAXIMUM HEIGHT A.F.F. FOR STAIRS AND 36" MINIMUM ON HORIZONTAL SURFACE GUARDS.
2. LINE OF OVERHEAD GARAGE DOOR IN OPEN POSITION
3. SLOPE GARAGE FLOOR 1/8" PER FOOT TOWARD OVERHEAD GARAGE DOOR OPENING.
4. FIREPLACE, AS SPECIFIED BY BUILDER. INSTALL PER MANUFACTURERS SPECIFICATIONS. ALL FACTORY BUILT FIREPLACES SHALL COMPLY WITH LOCAL CODES.
5. SINK W/ GARBAGE DISPOSAL
6. DISHWASHER
7. RANGE
8. COOK TOP
9. OVEN
10. REFRIGERATOR SPACE.
11. PANTRY
12. PEDESTAL SINK
13. 42" X 42" SHOWER
14. 60"X 60" SHOWER
15. 42" X 60" TUB 2" TO TOP OF DECKING
16. 60"X 60" SHOWER-TUB
17. 30" X 60" TUB/SHOWER
18. 60" X 60" TUB/SHOWER
19. LINEN SHELVING- PER BUILDER SPECS.)
20. WASHER SPACE
21. DRYER VENT
22. OPTIONAL LAUNDRY SINK.
23. PROVIDE NON-COMBUSTIBLE PLATFORM ELEVATED 6" ABOVE GARAGE FLOOR FOR WATER HEATER.
24. 5 SHELVES PER BUILDER SPECS.
25. 220 AMP ANGLE PER BUILDER SPECS
26. ATTIC ACCESS (22 1/2"x30" U.N.O.).
27. ATTIC ACCESS W STAIRS (22 1/2"x54 1/2").
28. SYMBOL DENOTES DIMENSION @ 2'-0" FROM MAIN FLOOR & 1'-0" AT UPPER FLOOR U.N.O.
29. GYPSUM BOARD ARCH @ 1'-2" TO 8'-0".
30. GYPSUM BOARD LOW WALL, 36" A.F.F. (U.N.O.) W/ HDF CAP.
31. SOFFIT, REFER TO EXTERIOR ELEVATIONS FOR HEIGHTS & ARCHITECTURAL DETAILS FOR FINISH.
32. PLANT SHELF, SEE EXTERIOR ELEVATIONS.
33. HALF WALL W/ WOOD CAP OR OPTIONAL LOW WALL WITH RAIL AS ABOVE.
34. PORCH RAIL, SEE ELEVATION.
35. 36"x36" CONCRETE STOOP.
36. 6x8 BEAM.
37. OPTIONAL UPPER CABINETS.
38. OPTIONAL CABINETS.
39. OPTIONAL COFFERED CEILING @ 8'-0" PER BUILDER SPEC.
40. LINE OF FRAMING ABOVE.
41. LINE OF FRAMING WALL BELOW.
42. 2X4 LOW WALL 42" A.F.F.
43. 2X6 LOW WALL 42" A.F.F.
44. ART NICHE
45. HORIZONTAL LAUNDRY CHUTE
46. LOW WALL 42" A.F.F.
47. GYPSUM BOARD ARCH @ 8'-0" TO 8'-6"
48. LOW WALL 36" A.F.F.
49. NO HARD LATCH OR LOCKING KNOB

ISSUE DATE: 03/05/2013
REVISIONS:

5400 Trinity Road
Suite 107
Raleigh,
North Carolina 27607
919-322-2288 Phone

Meritage Homes

Meritage Homes

BSB DESIGN
www.bsbdesign.com
2001 Western Parkway, Suite 240
West Des Moines, Iowa 50265
515.270.3300

JOB NO. 03/12/2014 PHILLIPS F.
DRAWN HOUSTON CHECKED JFTG
BASEMENT PLAN - B

Plan - 4227
A0.1B